




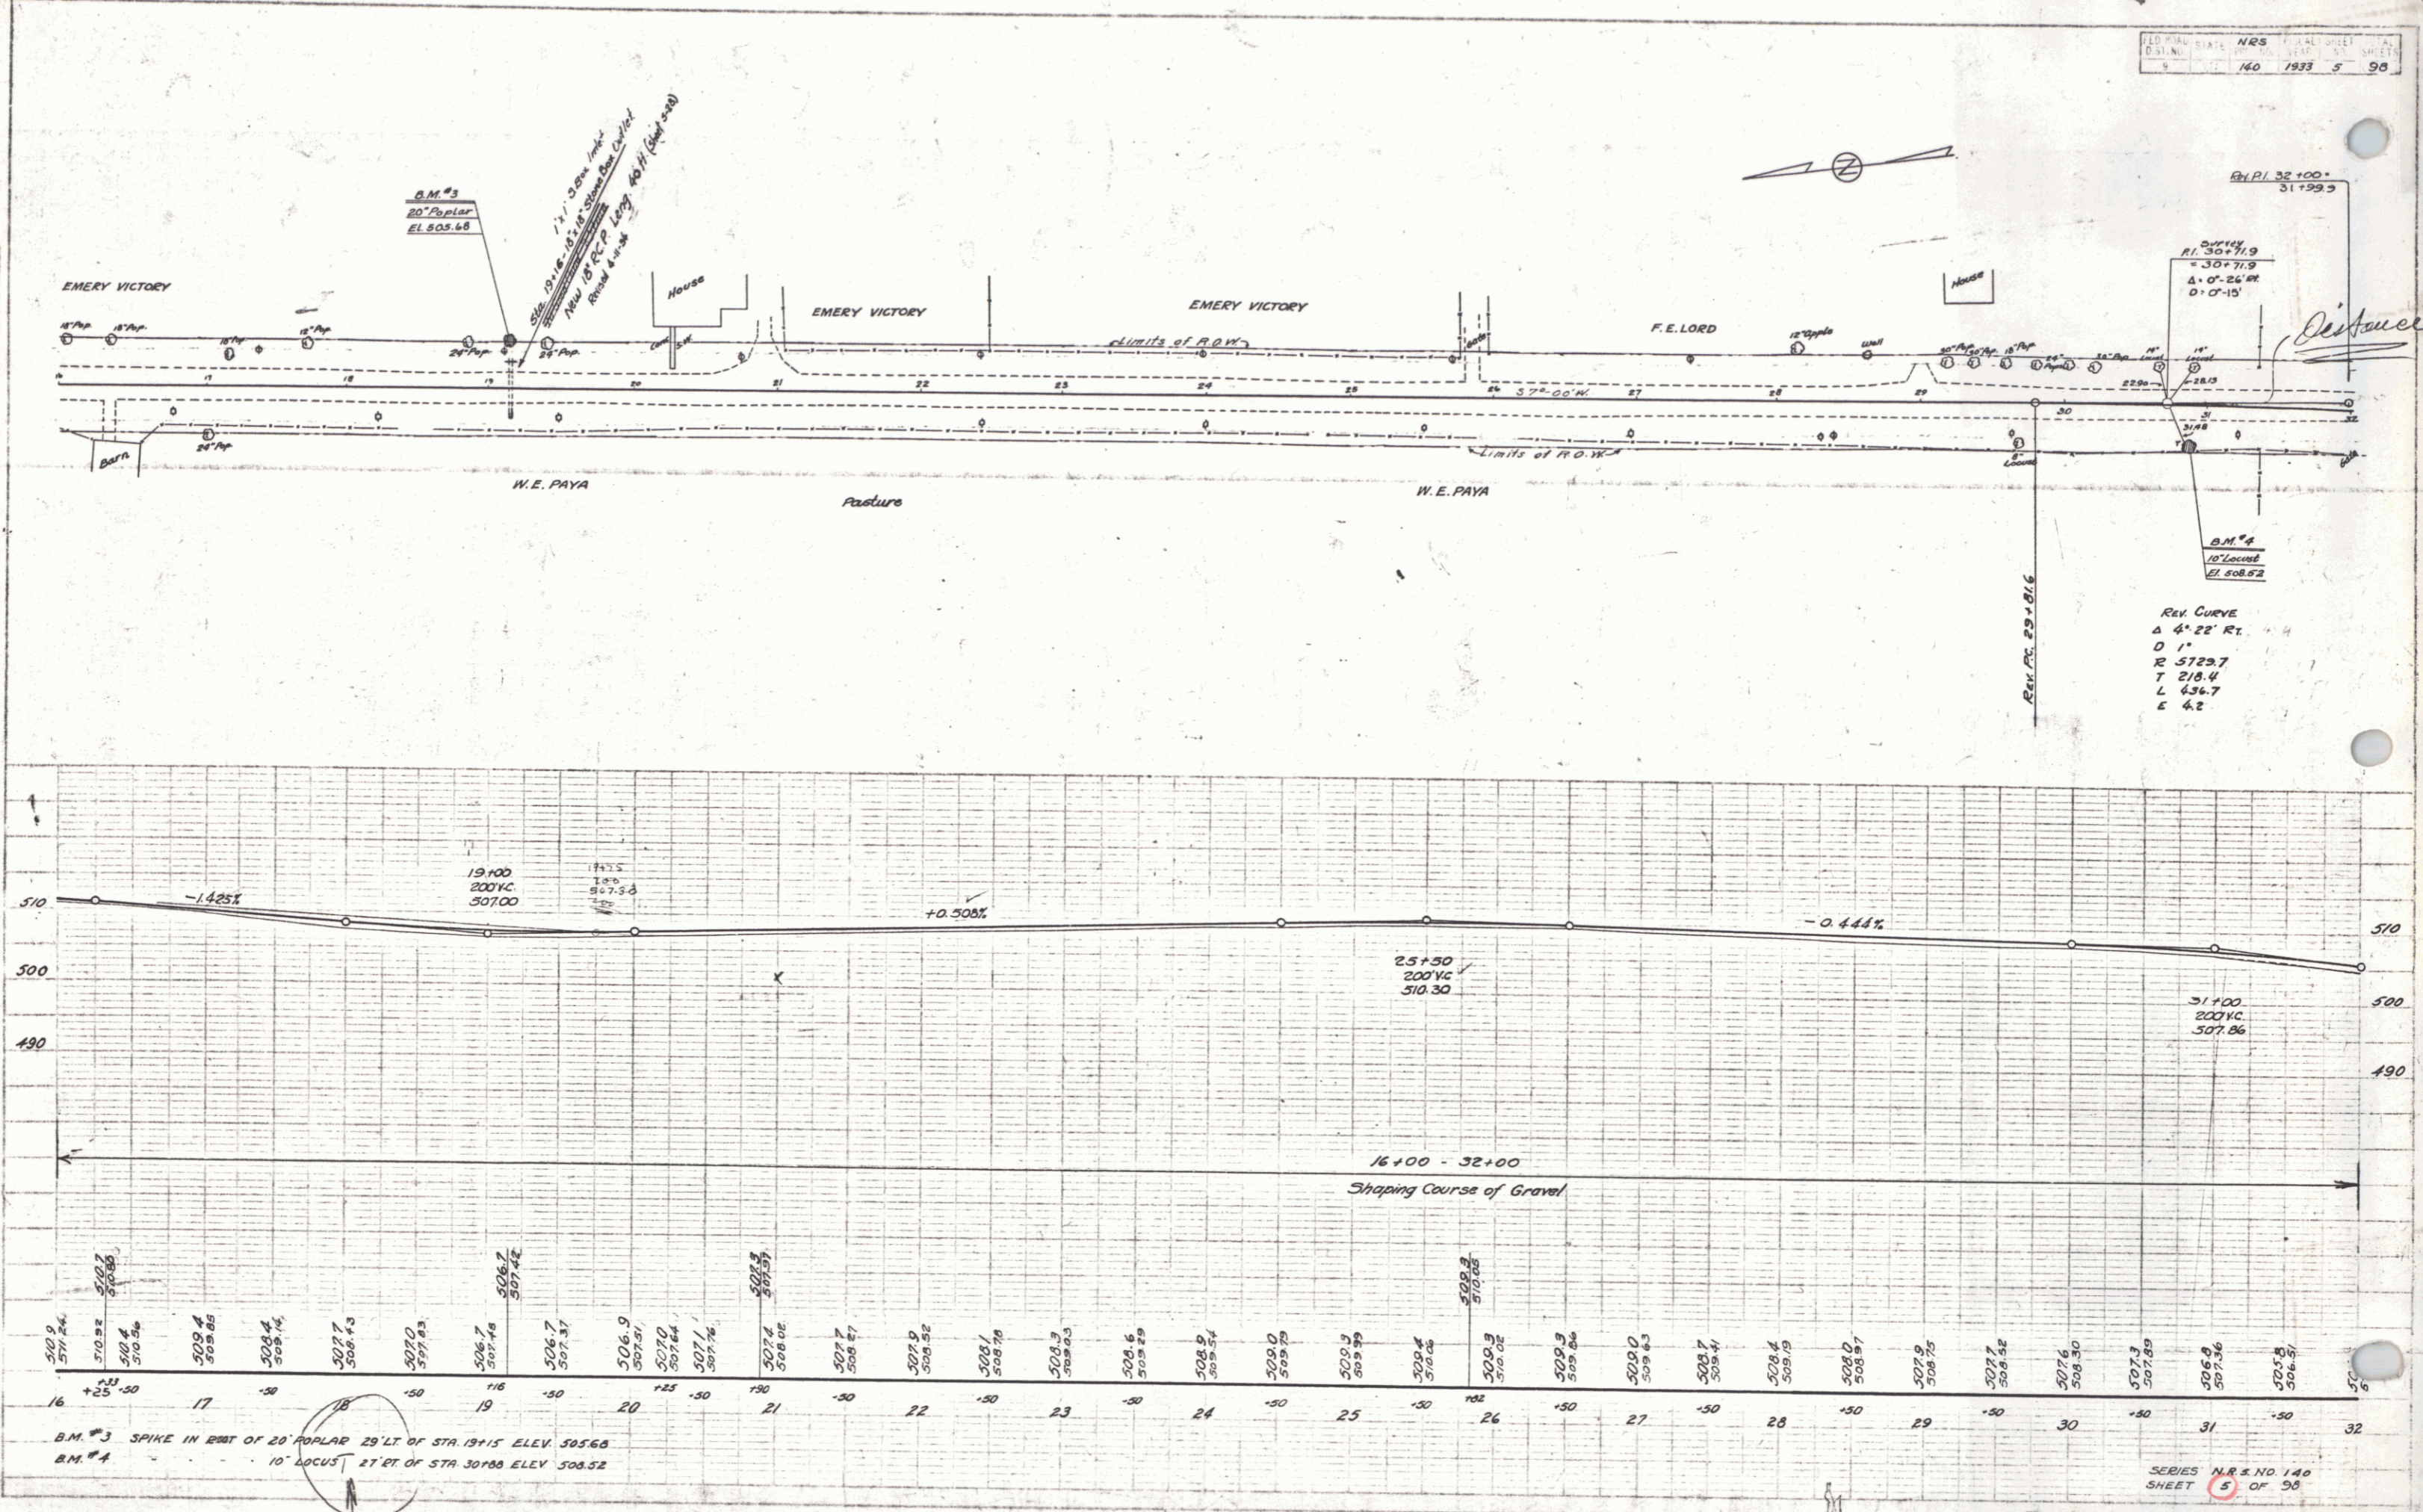

B.M. #3 SPIKE IN ROOT OF 20' POPLAR 29' LT OF STA. 19+15 ELEV. 505.68  
 B.M. #4 10' LOCUS 27' RT OF STA. 30+00 ELEV. 508.52