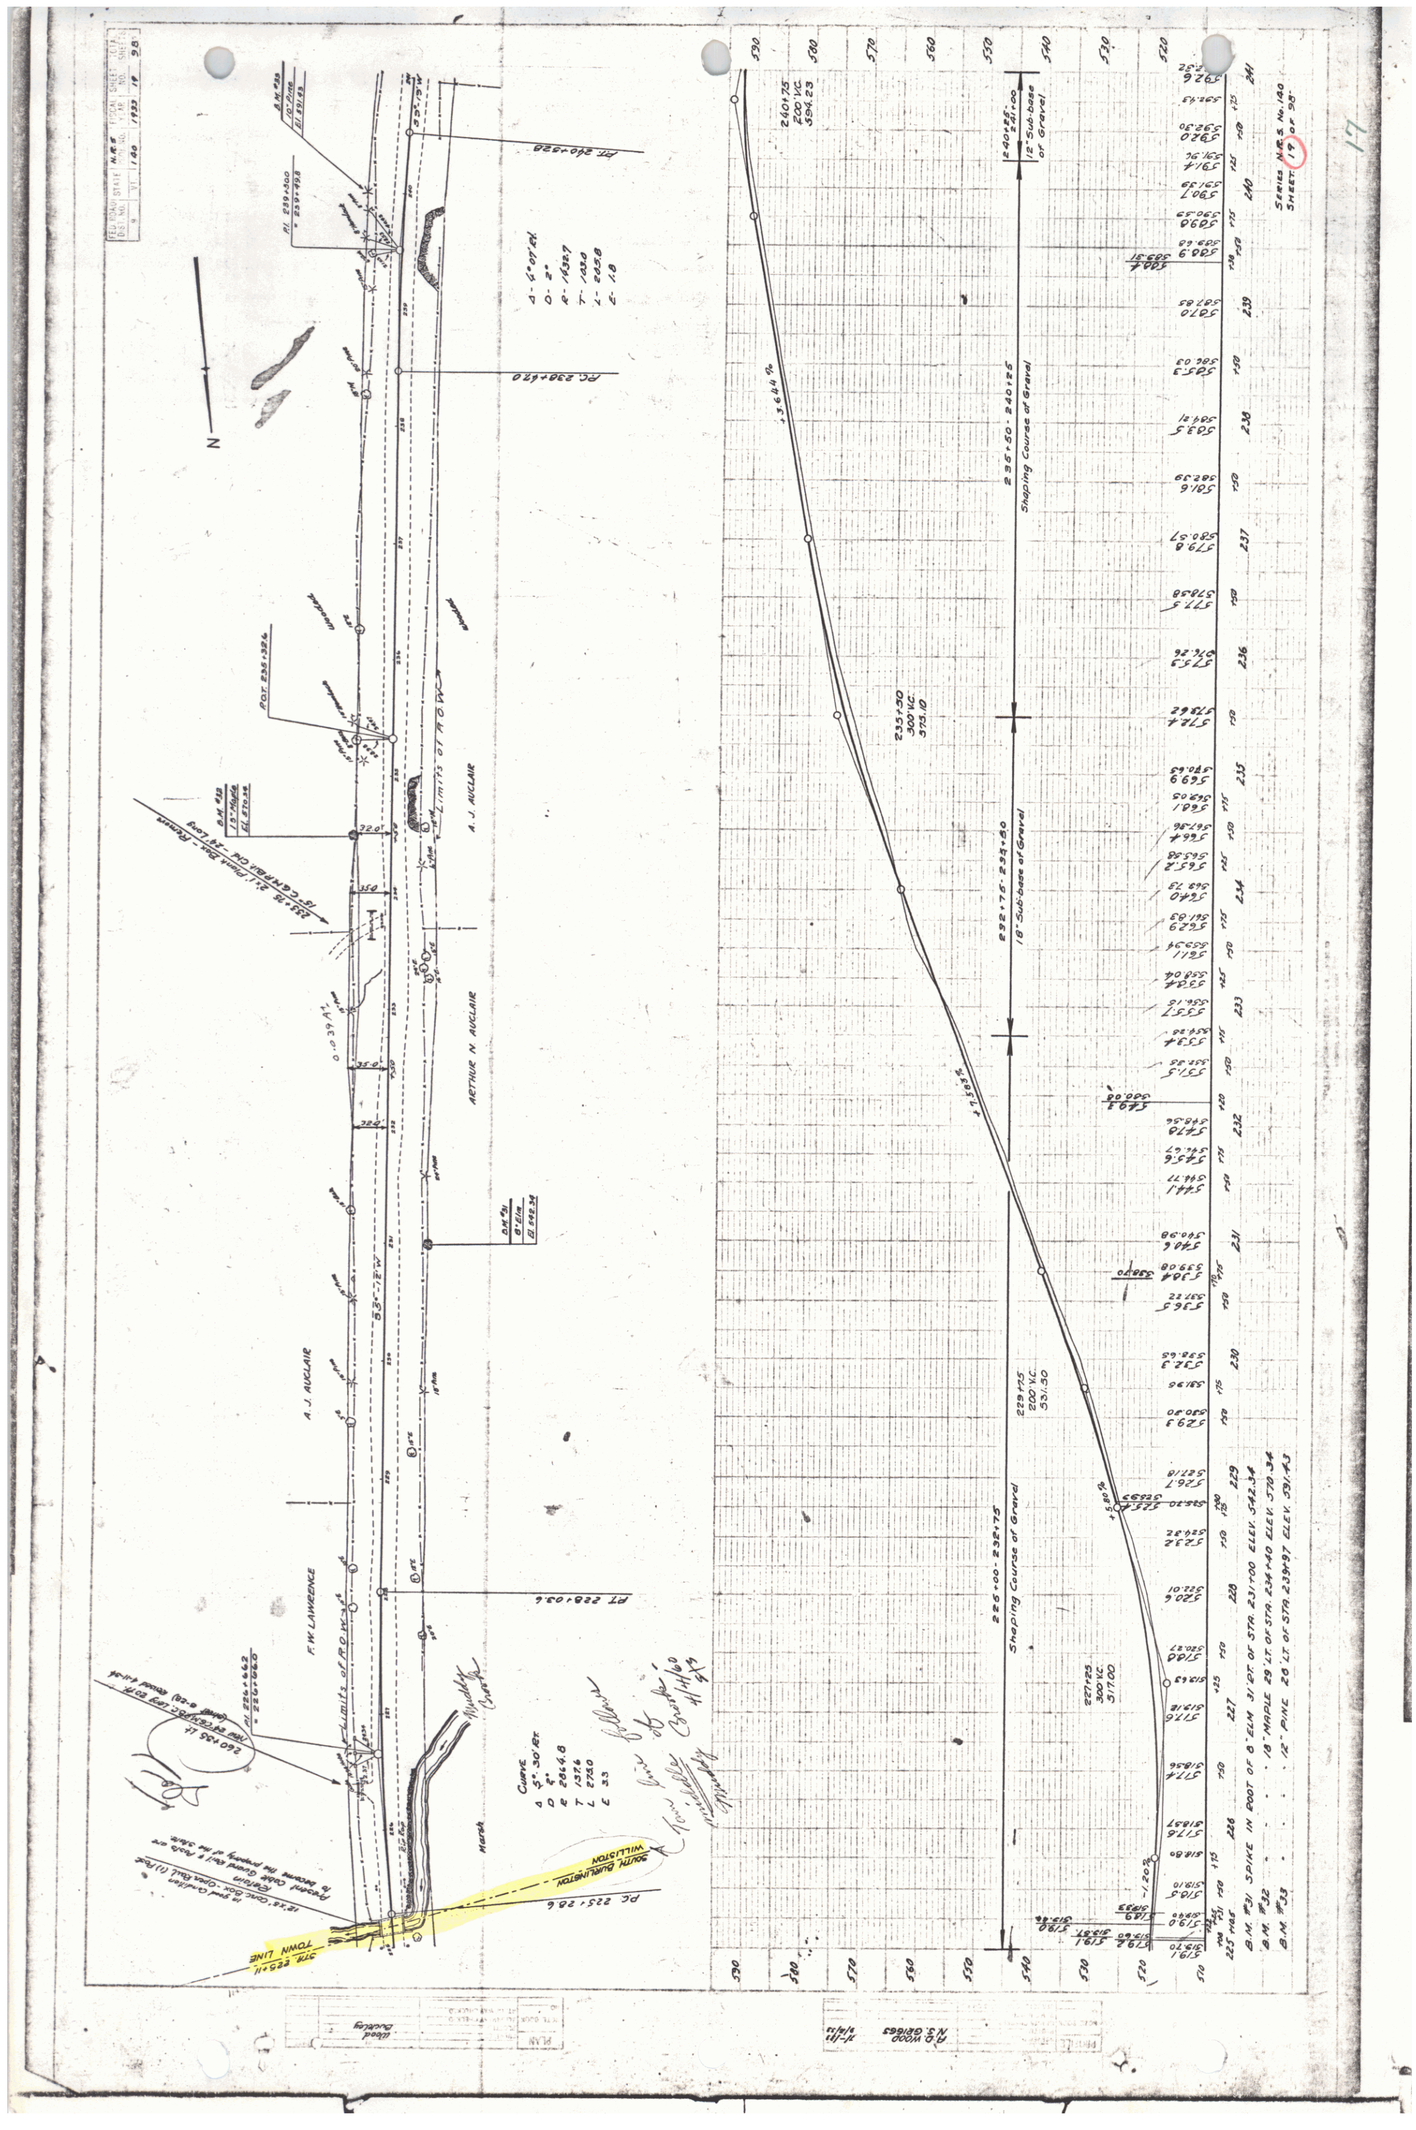
FEDERAL AID PROJECT NO. N.H.F.
STATE VT.
FISCAL YEAR 1933
SHEET NO. 28
N
A.J. AUCLAIR
ARTHUR N. AUCLAIR
F.W. LAWRENCE
Limits of R.O.W.
TOWN LINE
Shaping Course of Gravel
18" Sub-base of Gravel
12" Sub-base or Gravel
SERIES N.H.S. No. 180
SHEET 19 of 28