FED. ROAD DIST. NO.	STATE	FISCAL YEAR	SHEET NO.	TOTAL SHEETS
0	VT.	140 1933	21	98

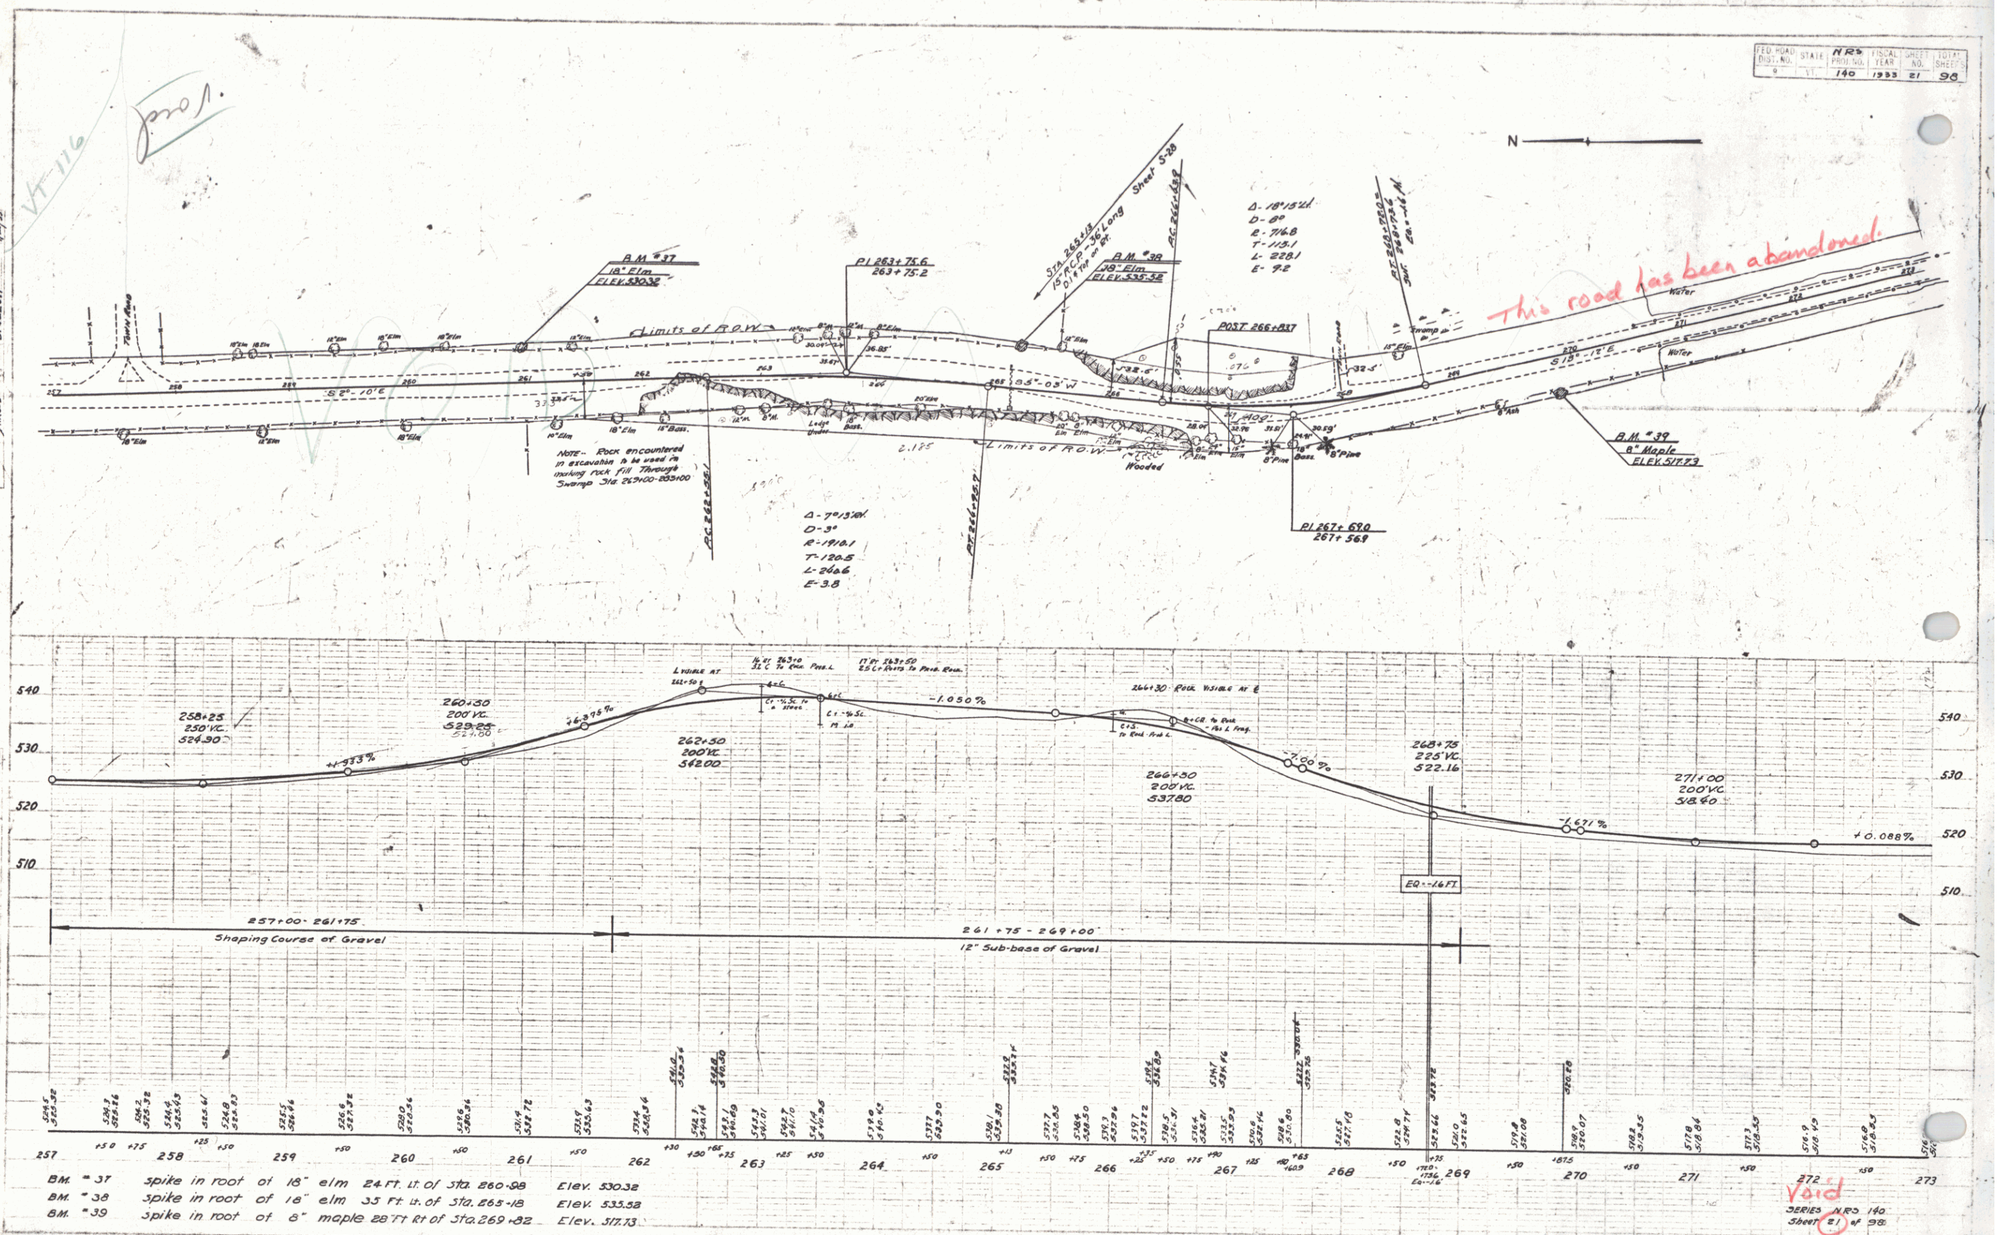

B.M. #37	Spike in root of 18" elm 24 Ft. Lt. of Sta. 260+98	Elev. 530.32
B.M. #38	Spike in root of 18" elm 35 Ft. Lt. of Sta. 265+18	Elev. 535.52
B.M. #39	Spike in root of 8" maple 28 Ft Rt of Sta. 269+82	Elev. 517.73

VT-116

Proof.

WORPLY
BIGELOW
TRACED
9/20/33
1"=100'

VOID

25