


Construct Drive
11'10 7:50 ET
File 116 13:42 FT

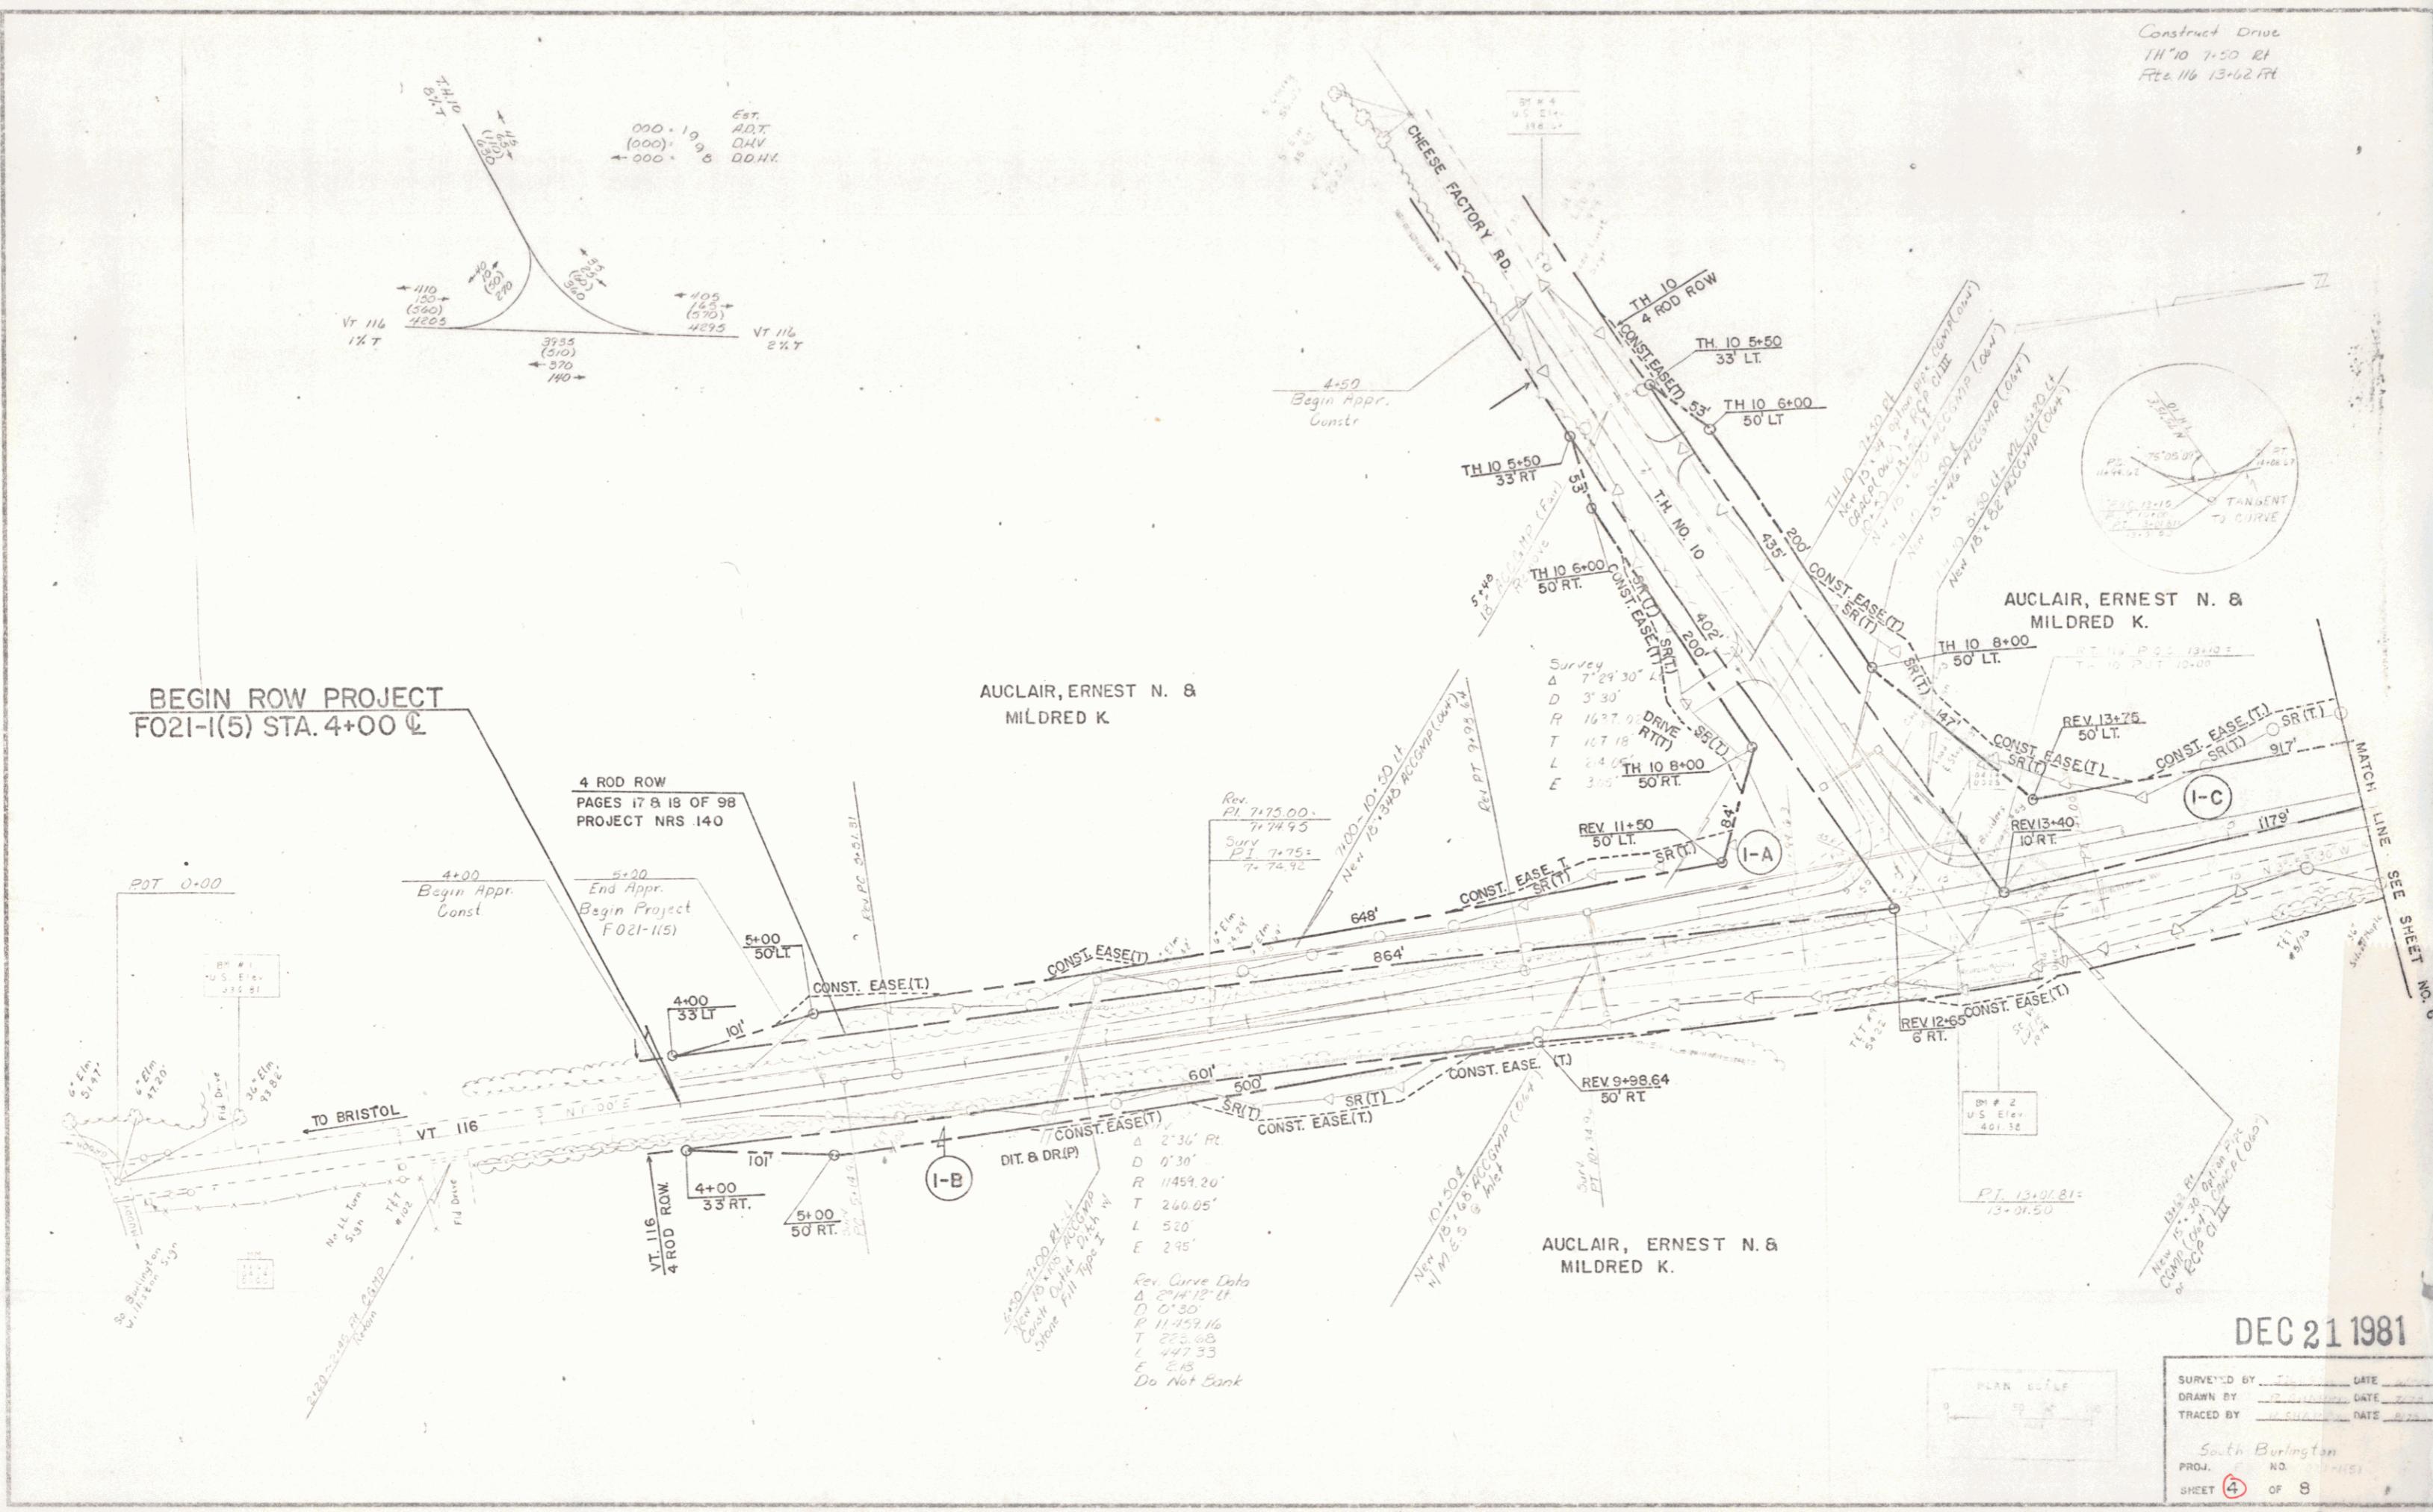

BEGIN ROW PROJECT
F021-1(5) STA. 4+00 CL

4 ROD ROW
PAGES 17 & 18 OF 98
PROJECT NRS 140

AUCLAIR, ERNEST N. &
MILDRED K.

AUCLAIR, ERNEST N. &
MILDRED K.

DEC 21 1981

SURVEYED BY	DATE
DRAWN BY	DATE
TRACED BY	DATE
South Burlington	
PROJ. NO.	
SHEET 4	OF 8