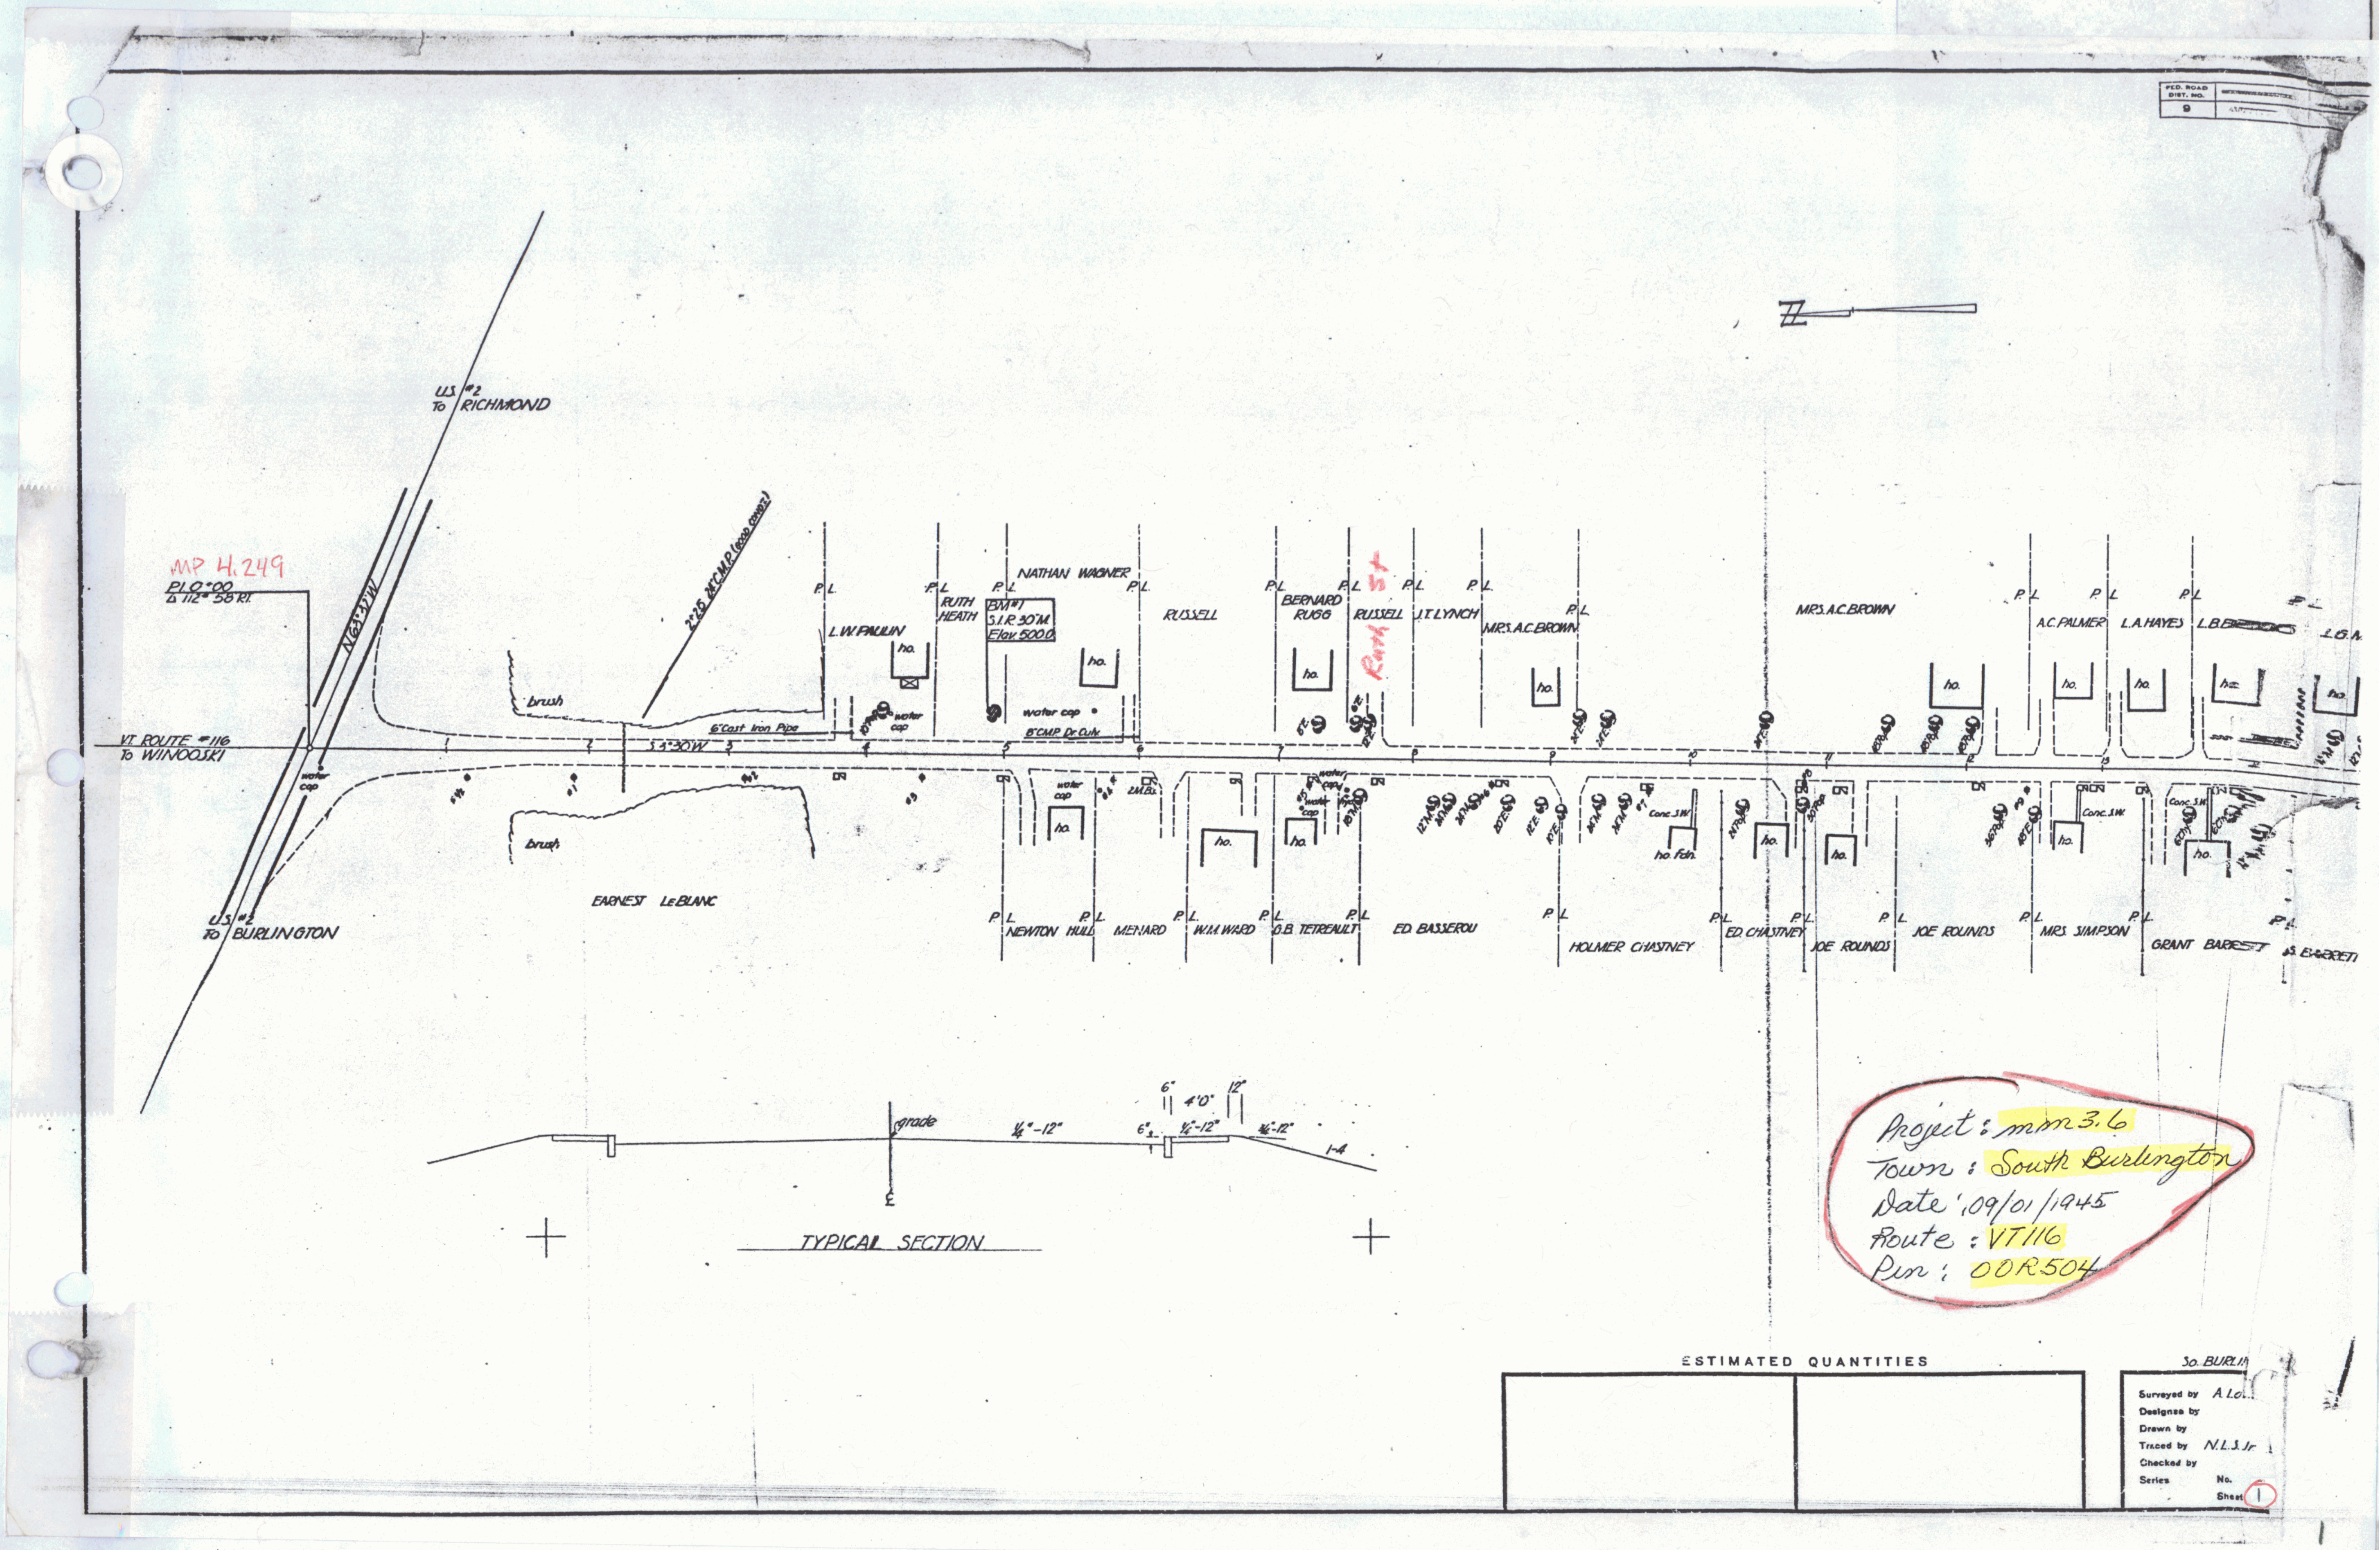

U.S. #2
To RICHMOND
MP 4.249
P.I. 0+00
VT ROUTE #116
To WINOOSKI
U.S. #2
To BURLINGTON
brush
6" Cast Iron Pipe
water cap
L.W. PAULIN
RUTH HEATH
NATHAN WAGNER
RUSSELL
BERNARD RUGG
RUSSELL
Ruth St
J.T. LYNCH
MRS. A.C. BROWN
MRS. A.C. BROWN
A.C. PALMER
L.A. HAYES
P.L
ho.
EARNEST LeBLANC
NEWTON HULL
MENARD
W.M. WARD
D.B. TETREAULT
ED. BASSEROU
HOLMER CHASTNEY
ED. CHASTNEY
JOE ROUNDS
JOE ROUNDS
MRS. SIMPSON
GRANT BABEST
Conc. S.W.
ho. Fdn.
grade
TYPICAL SECTION
Project: mm 3.6
Town: South Burlington
Date: 09/01/1945
Route: VT116
Pin: 00R504
ESTIMATED QUANTITIES
So. BURL
Surveyed by A.L.
Designed by
Drawn by
Traced by N.L.S. Jr
Checked by
Series
No.
Sheet 1