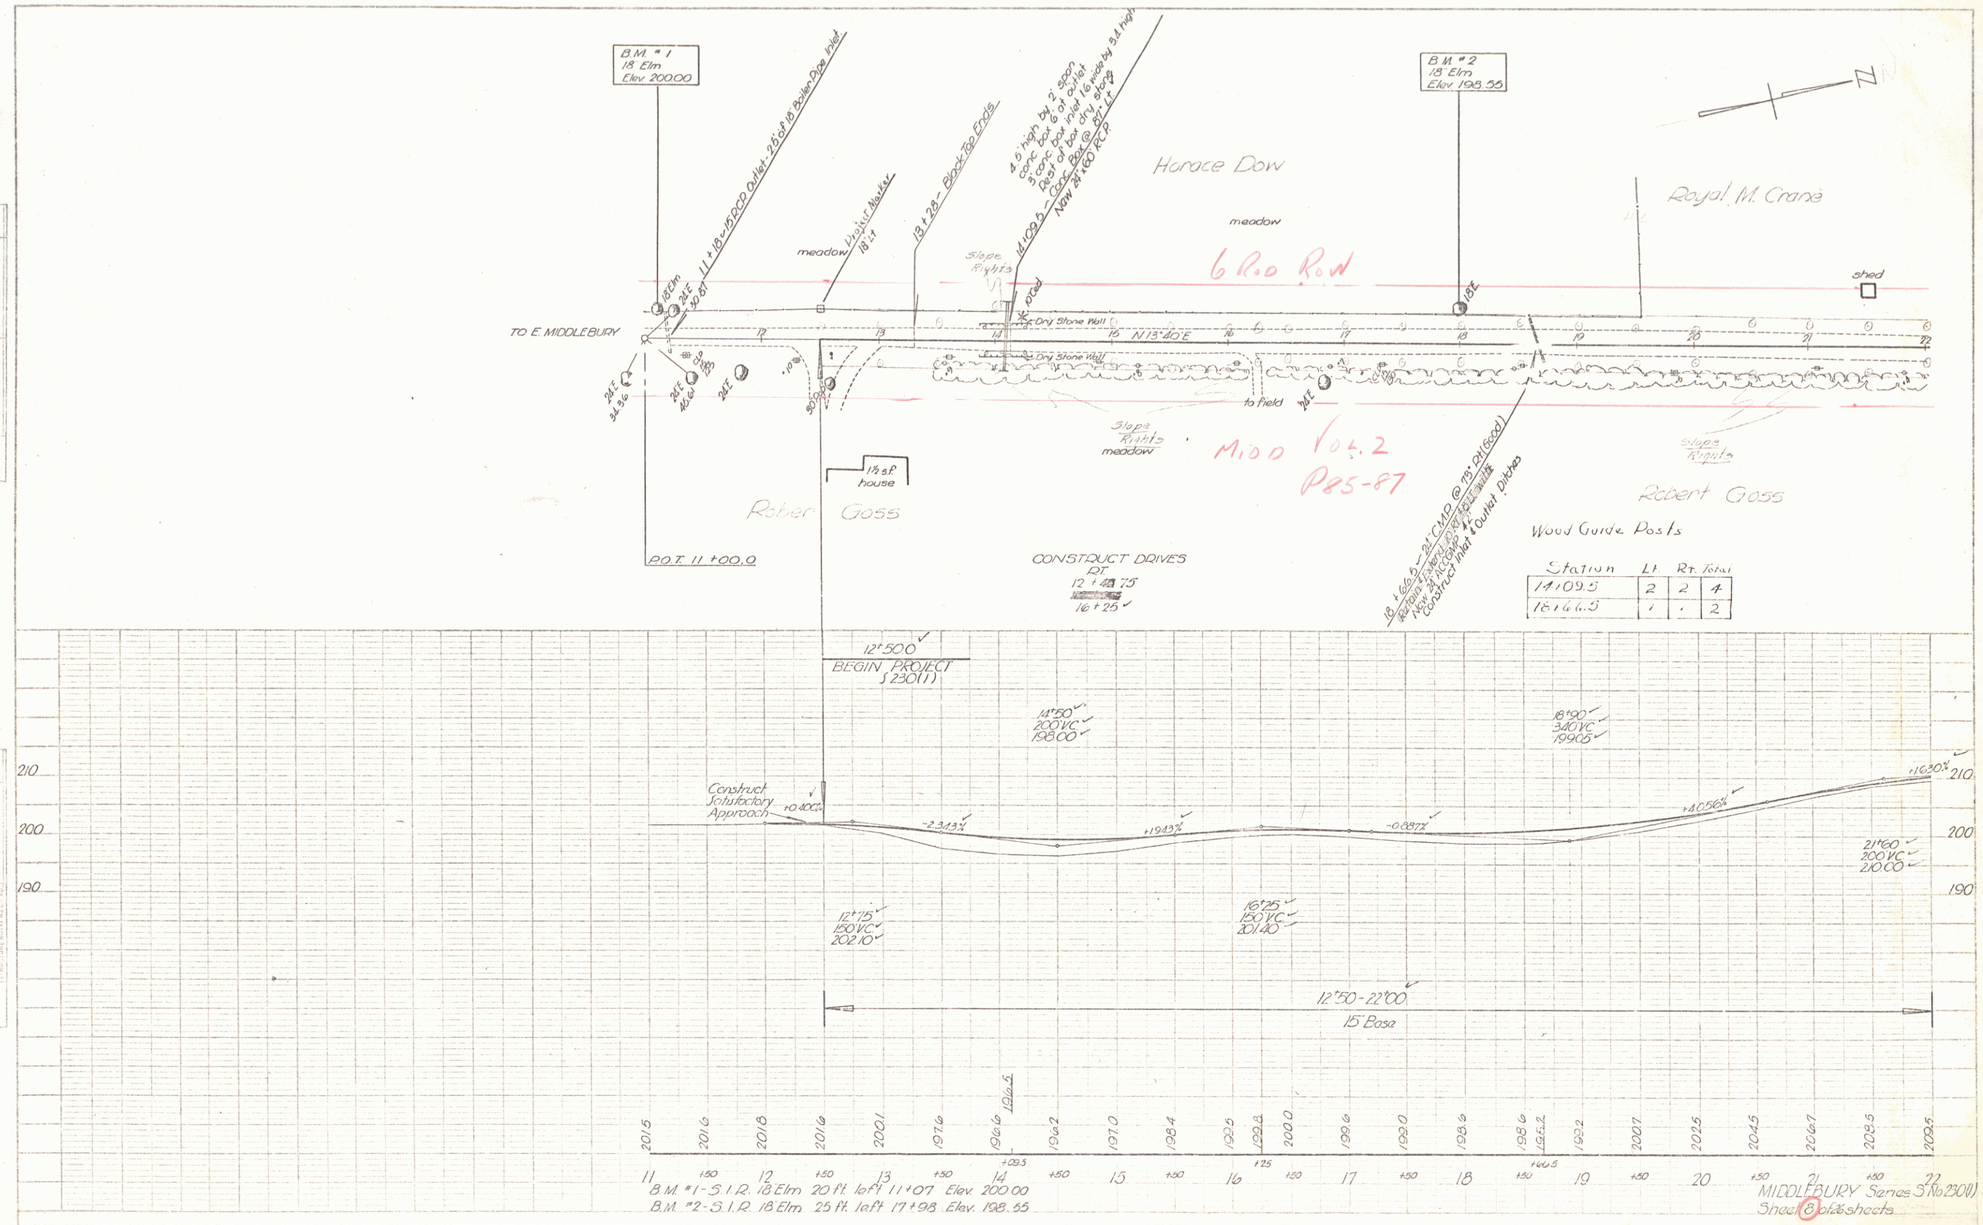
B.M. #1
18" Elm
Elev 200.00
B.M. #2
18" Elm
Elev 198.55
N
Horace Dow
meadow
6 Rod Row
Royal M. Crane
shed
TO E. MIDDLEBURY
N 13°40' E
Dry Stone Wall
to field
Slope Rights
meadow
Robert Goss
1½ sf house
P.O.T. 11+00.0
CONSTRUCT DRIVES
PT.
12+48.75
16+25
Wood Guide Posts
Station | Lt. | Rt. | Total
14+09.5 | 2 | 2 | 4
16+66.5 | 1 | 1 | 2
12+50.0
BEGIN PROJECT
S 230(1)
14+50
200 VC
198.00
18+90
340 VC
199.05
Construct Satisfactory Approach
+0.40%
-2.343%
+1.943%
-0.887%
+0.56%
+1.630%
21+60
200 VC
210.00
12+75
150 VC
202.10
16+25
150 VC
201.40
12+50 - 22+00
15' Base
201.5 201.6 201.8 201.6 200.1 197.6 196.6 196.5 196.2 197.0 198.4 199.5 199.2 200.0 199.6 199.0 198.6 198.6 198.2 199.2 200.7 202.5 204.5 206.7 208.5 209.5
11 +50 12 +50 13 +50 14 +50 15 +50 16 +50 17 +50 18 +50 19 +50 20 +50 21 +50 22
+25 +25 +66.5
B.M. #1 - S.I.R. 18" Elm 20 ft. left 11+07 Elev. 200.00
B.M. #2 - S.I.R. 18" Elm 25 ft. left 17+98 Elev. 198.55
MIDDLEBURY Series S No. 230(1)
Sheet 8 of 8 sheets
Mod Vol. 2
P85-87

2