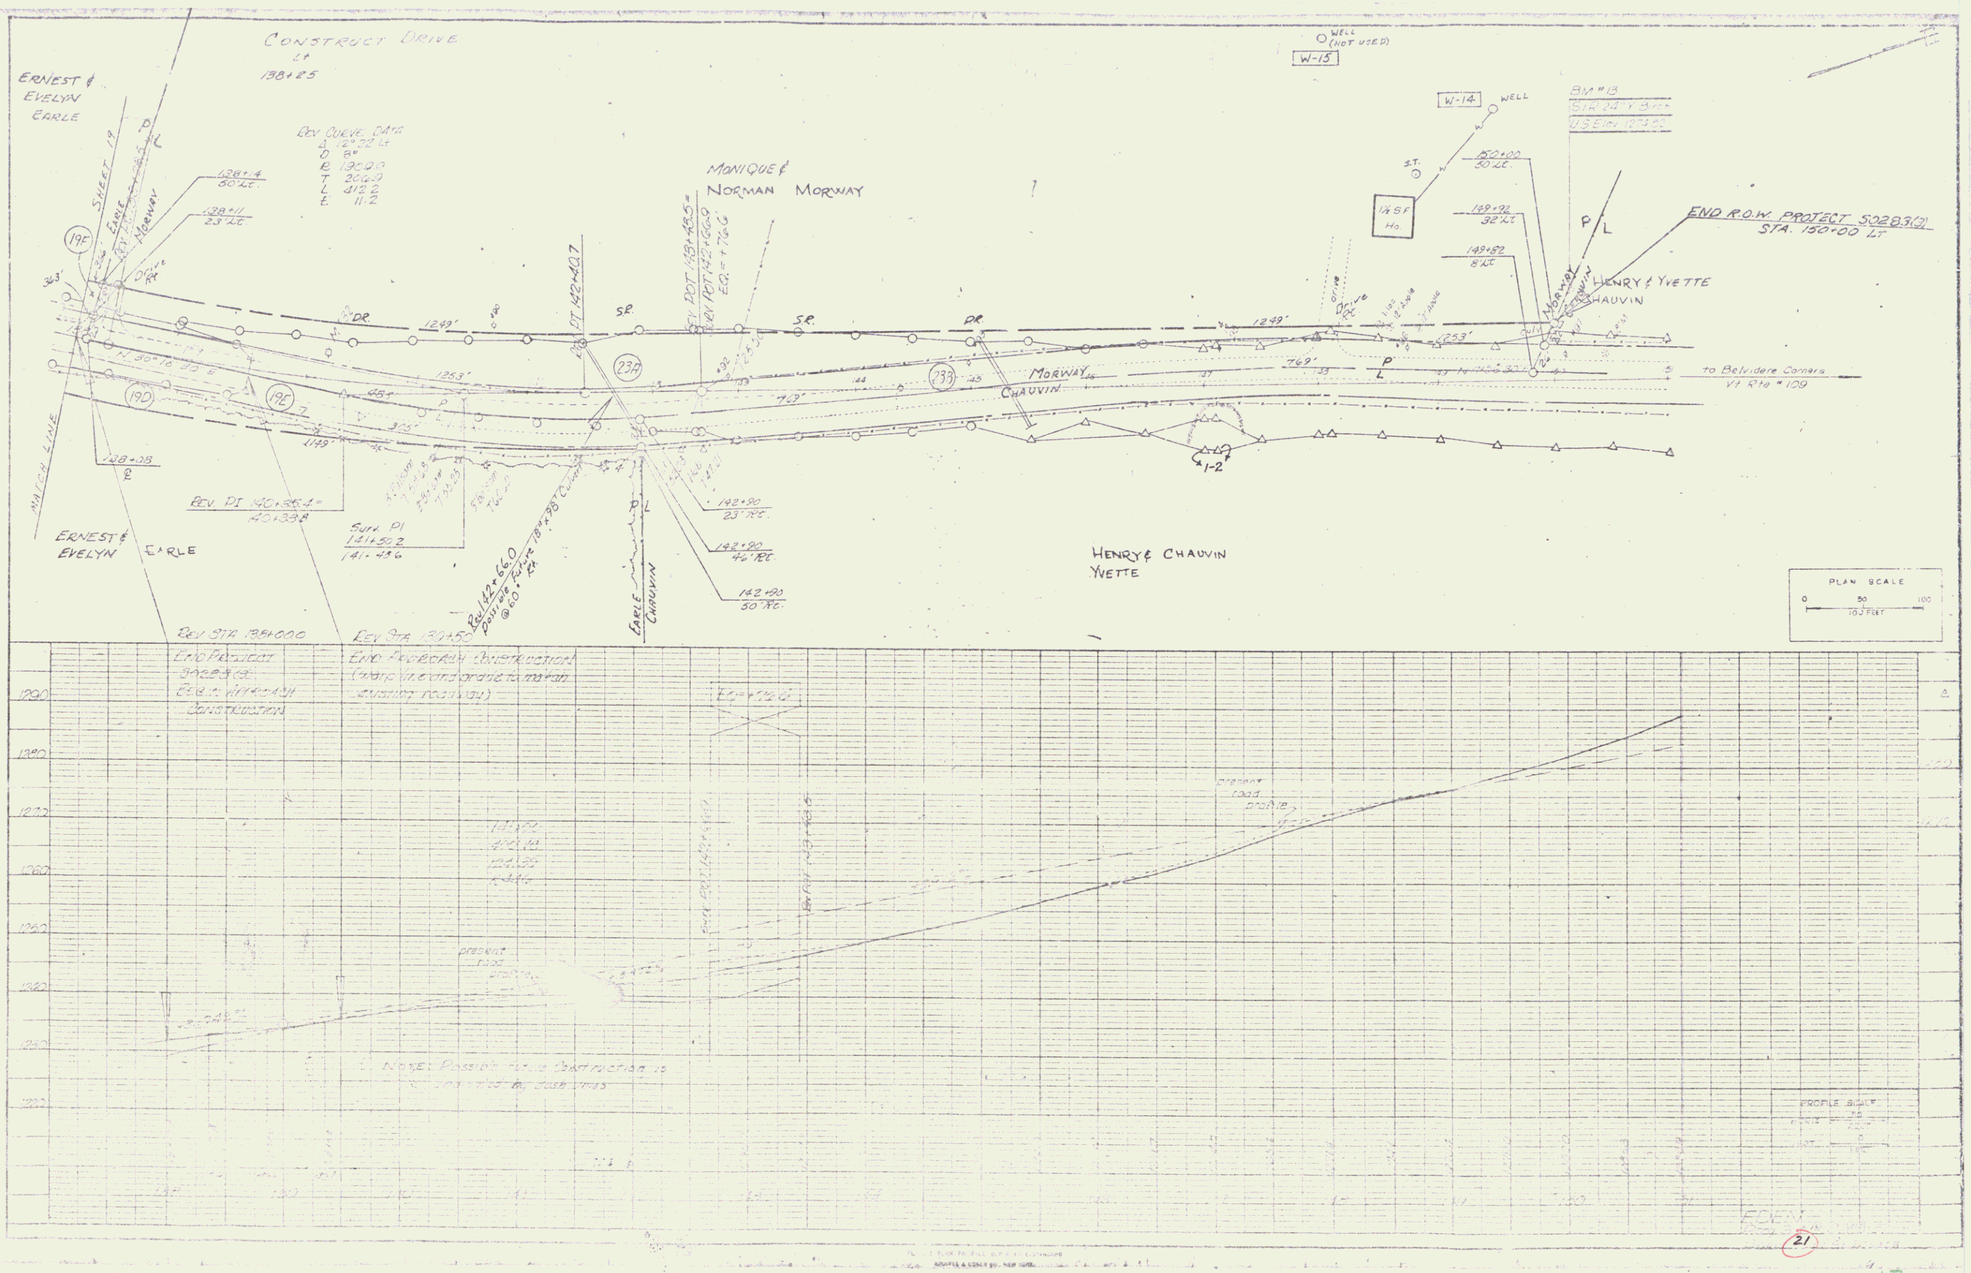
CONSTRUCT DRIVE
LT
138+25
ERNEST & EVELYN EARLE
REV CURVE DATA
Δ 12°22' LT
D 8°
R 190.0
T 20.6.0
L 41.2.2
E 11.2
MANIQUE & NORMAN MORWAY
WELL (NOT USED)
W-15
W-14
WELL
ST.
1½ SF Ho.
BM #13
END R.O.W. PROTECT 5028.3(2)
STA. 150+00 LT
HENRY & YVETTE CHAUVIN
to Belvidere Corners
Vt Rte #109
MORWAY
CHAUVIN
EARLE
MATCH LINE
REV. PI 140+36.4 = 401338
Surv PI 141+50.2 141+43.6
142+90 23' RT.
142+90 46' RT.
142+90 50' RT.
HENRY & CHAUVIN YVETTE
PLAN SCALE
0 50 100
10 FEET
REV STA 138+00.0
END PROJECT 5028.3(2) ELEV IN ACCORDANCE CONSTRUCTION
REV STA 138+50
END PROVISIONAL CONSTRUCTION (MATCH LINE AND GRADE TO MATCH EXISTING ROADWAY)
EXISTING
PROPOSED GRADE PROFILE
PROFILE SCALE
21
17