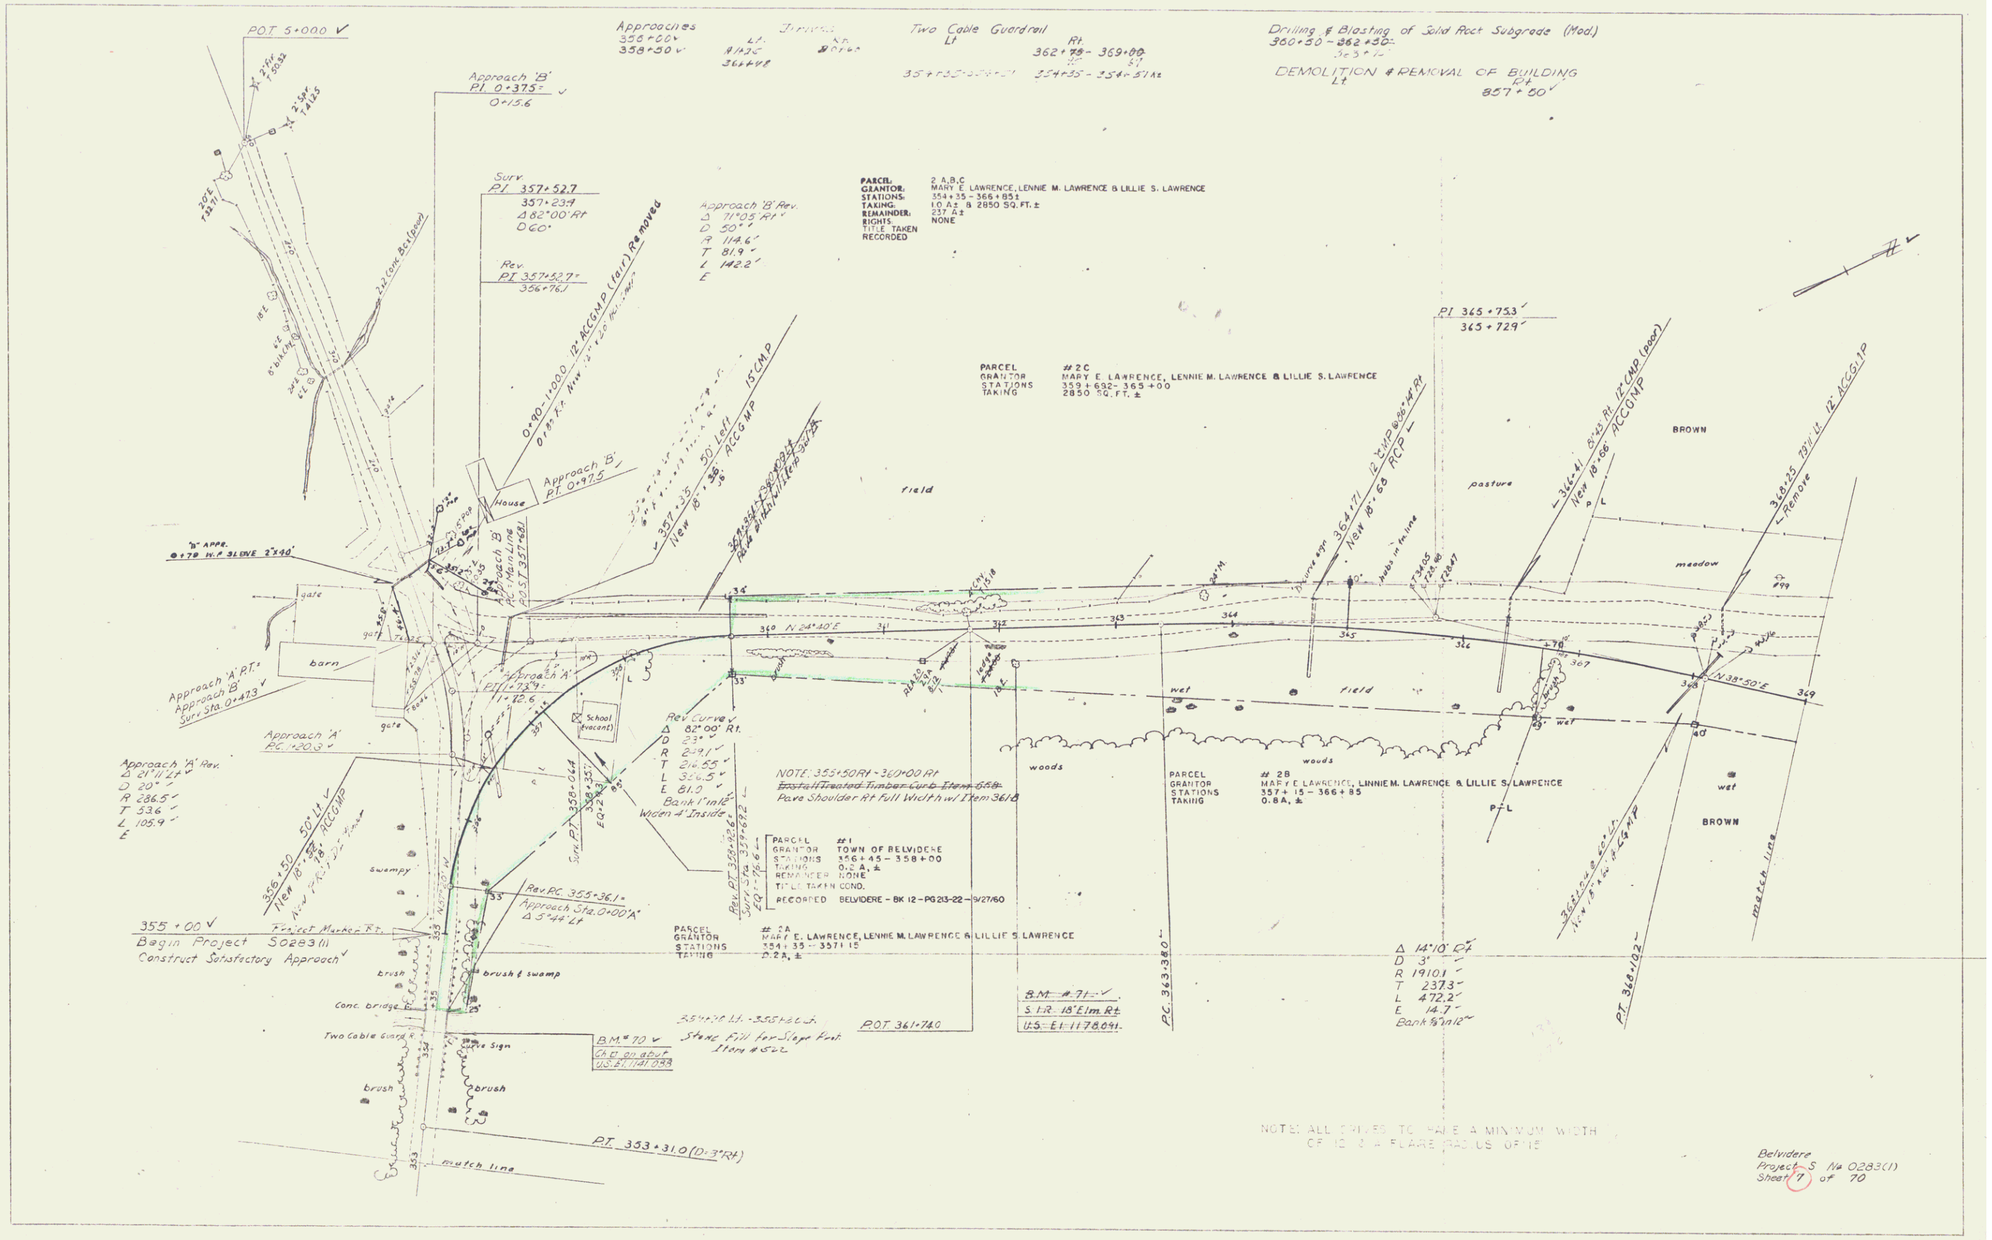
POT 5+000
Approaches
355+00
358+50
Two Cable Guardrail
Lt
Rt
362+00 - 369+00
Drilling & Blasting of Solid Rock Subgrade (Mod.)
360+50 - 362+50
DEMOLITION & REMOVAL OF BUILDING
Lt
Rt
357+50
Approach 'B'
PI 0+375
0+15.6
Surv.
PI 357+52.7
357+23.9
Δ 82°00' Rt
D 60°
Rev.
PI 357+52.7
356+76.1
Approach 'B' Rev.
Δ 71°05' Rt
D 50°
R 114.6'
T 81.9'
L 142.2'
E
PARCEL:
GRANTOR:
STATIONS:
TAKING:
REMAINDER:
RIGHTS:
TITLE TAKEN
RECORDED
2, A, B, C
MARY E. LAWRENCE, LENNIE M. LAWRENCE & LILLIE S. LAWRENCE
354+35 - 366+85±
1.0 Ac & 2850 SQ. FT. ±
2.37 Ac±
NONE
PI 365+753
365+729
PARCEL
GRANTOR
STATIONS
TAKING
#2C
MARY E. LAWRENCE, LENNIE M. LAWRENCE & LILLIE S. LAWRENCE
359+692 - 365+00
2850 SQ. FT. ±
0+90 - 1+00.0 12" ACCGMP (rail) Rt moved
0+88.75 New 12" ACCGMP
15" CMP
50' Left
New 18" x 58' ACCGMP
House
Approach 'B'
PI 0+97.5
Approach 'B' Rev. Main Line
PI 357+68.1
"B" APPR.
0+78 W.F. 3' LOWE 2'+40'
barn
gate
Approach 'A' P.T.
Approach 'B'
Surv. Sta. 0+47.3
Approach 'A'
PC 1+20.3
Approach 'A' Rev.
Δ 21°11' Lt
D 20°
R 286.5'
T 53.6'
L 105.9'
E
356+50
New 18" x 58' ACCGMP
New 24" x 58' Flare
swampy
Project Marker Rt.
355+00
Begin Project S0283(1)
Construct Satisfactory Approach
brush & swamp
Conc. bridge
Two Cable Guard
Curve Sign
brush
match line
P.T. 353+31.0 (D=3° Rt)
Approach 'A'
PI 1+73.4
11+32.6
School (vacant)
Rev. Curve
Δ 82°00' Rt.
D 53°
R 218.1'
T 214.55'
L 326.5'
E 61.0'
Bank 1' in 12'
Widen 4' Inside
Sur. P.T. 358+64.4
358+35.1
EQ 0+29.3
Rev. P.C. 355+36.1
Approach Sta. 0+00 "A"
Δ 5°44' Lt
NOTE: 355+50 Rt - 360+00 Rt
~~Install Treated Timber Curb Item 656~~
Pave Shoulder Rt full Width w/ Item 361B
PARCEL
GRANTOR
STATIONS
TAKING
REMAINDER
TITLE TAKEN COND.
RECORDED
#1
TOWN OF BELVIDERE
356+45 - 358+00
0.2 A. ±
NONE
BELVIDERE - BK 12 - PG 23-22 - 9/27/60
PARCEL
GRANTOR
STATIONS
TAKING
#2A
MARY E. LAWRENCE, LENNIE M. LAWRENCE & LILLIE S. LAWRENCE
354+35 - 357+15
0.2 A. ±
B.M. #70
Chiseled on abut
US El. 1141.093
354+70 Lt. - 355+62 Lt.
Stone Fill for Slope Prot.
Item #502
POT 361+74.0
B.M. #71
S.I.R. 18" Elm. Rt.
US El. 1178.041
PC 363+38.0
PARCEL
GRANTOR
STATIONS
TAKING
#2B
MARY E. LAWRENCE, LINNIE M. LAWRENCE & LILLIE S. LAWRENCE
357+15 - 366+85
0.8 A. ±
Δ 14°10' Rt
D 3°
R 1910.1'
T 237.3'
L 472.2'
E 14.7'
Bank 1' in 12'
P.T. 364+10.2
Station 364+70
New 18" x 40' ACCGMP
match line
pasture
field
meadow
wet
woods
BROWN
N 24°40'E
N 33°50'E
NOTE: ALL CULVERTS TO HAVE A MINIMUM WIDTH OF 10' & FLARE RADIUS OF 15'
Belvidere
Project S № 0283(1)
Sheet 7 of 70

2