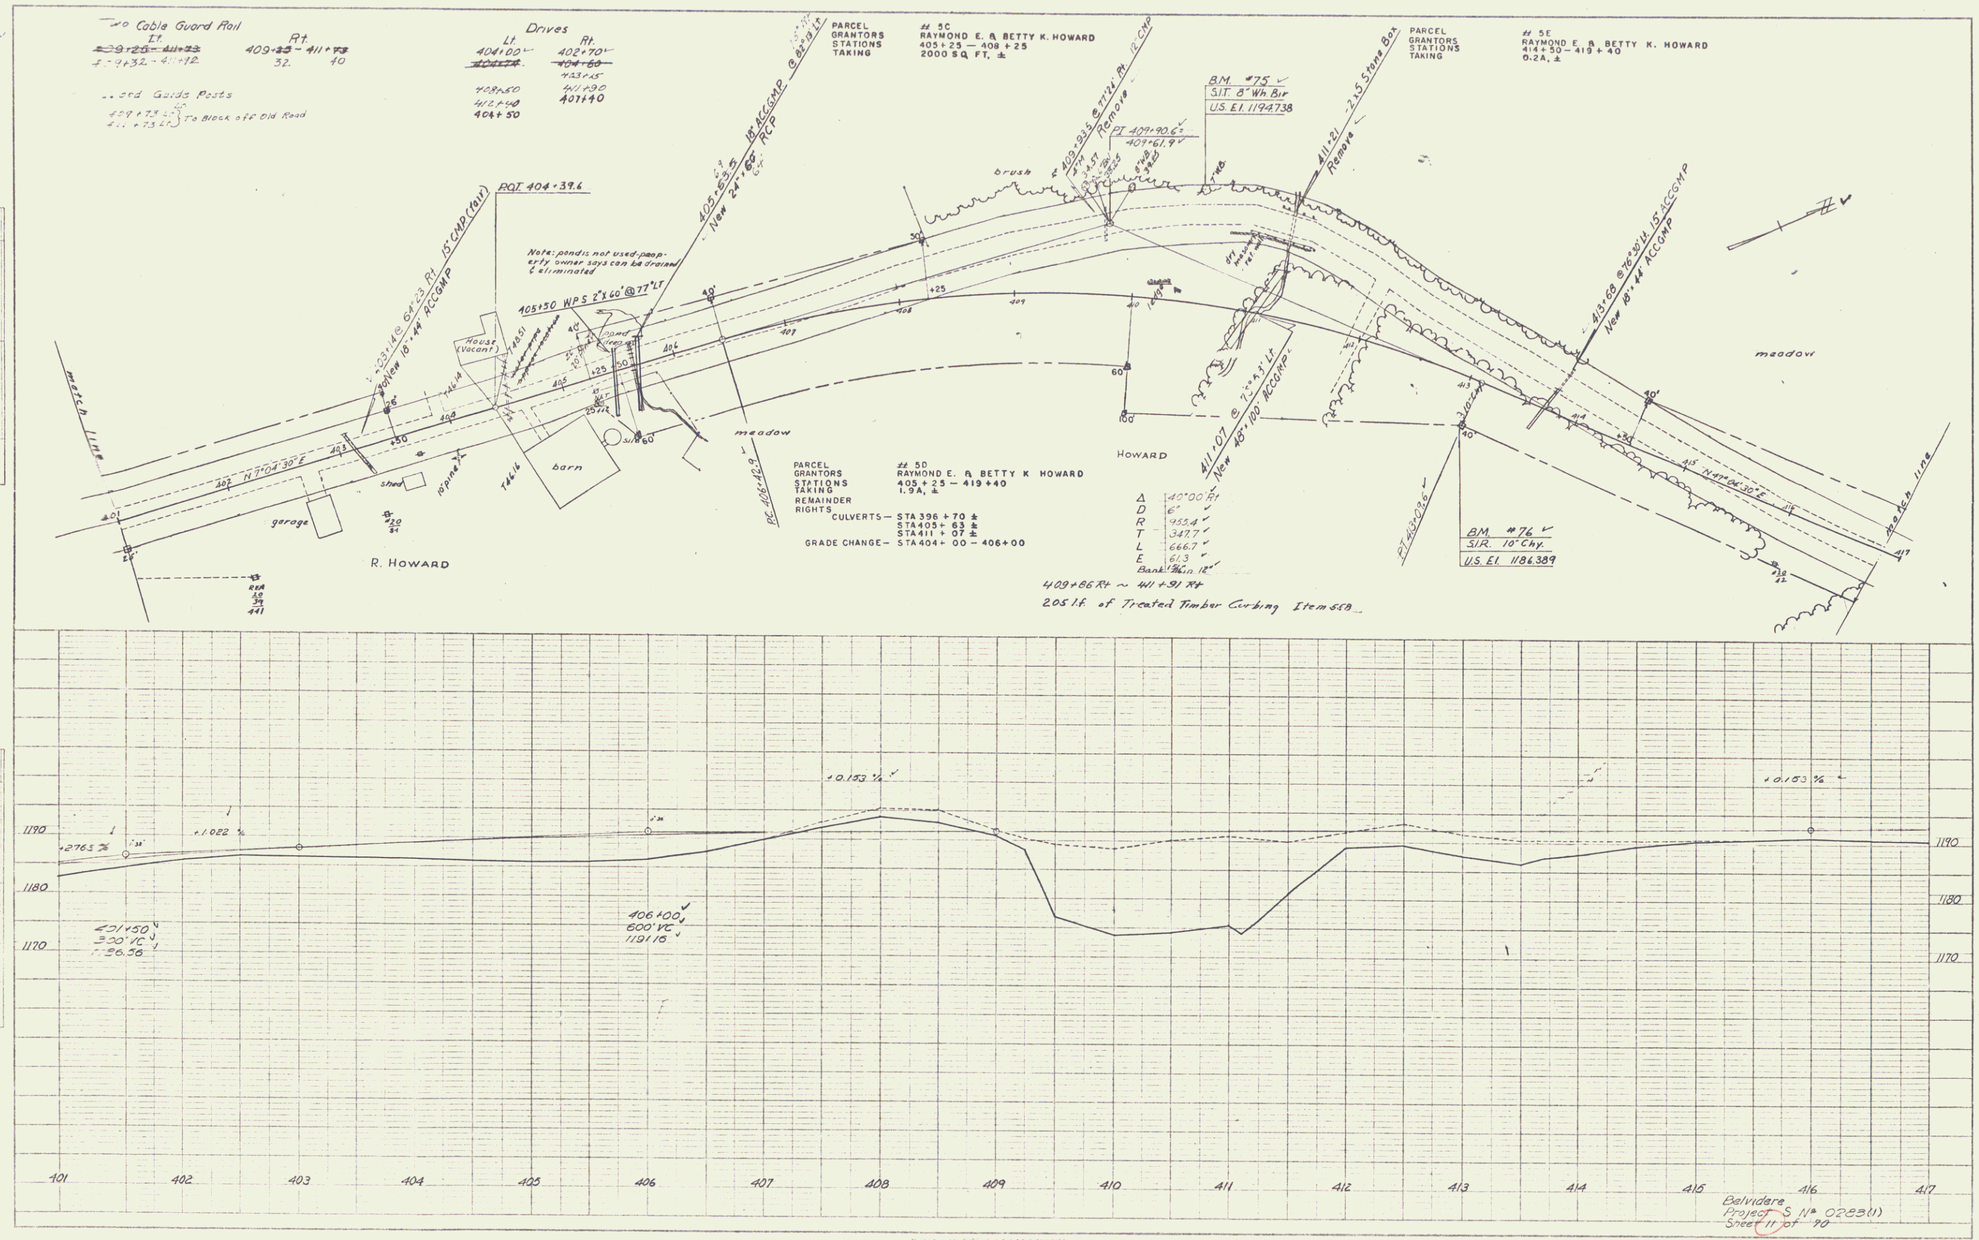
To Cable Guard Rail
Lt. Rt.
~~409+25 – 411+73~~ 409+~~25~~ – 411+73
~~1 – 9+32 – 41+12~~ 32. 40
Lt. Rt.
404+00 408+70
~~404+50~~ ~~404+50~~
408+50 ~~408+50~~
412+40 404+50
~~433+15~~
411+90
407+40
PARCEL
GRANTORS
STATIONS
TAKING
3C
RAYMOND E. & BETTY K. HOWARD
405+25 — 408+25
2000 SQ. FT. ±
PARCEL
GRANTORS
STATIONS
TAKING
5E
RAYMOND E. & BETTY K. HOWARD
414+50 — 419+40
0.2A. ±
BM. #75
S.I.T. 8" Wh. Bir
U.S. El. 1194.738
PI 409+90.6
409+61.9
411+21 – 2.5' Stone Box
Remove
brush
meadow
barn
garage
shed
House (Vacant)
R. HOWARD
HOWARD
PARCEL
GRANTORS
STATIONS
TAKING
REMAINDER
RIGHTS
5D
RAYMOND E. & BETTY K. HOWARD
405+25 — 419+40
1.9A. ±
CULVERTS — STA 396+70 ±
STA 405+63 ±
STA 411+07 ±
GRADE CHANGE — STA 404+00 — 406+00
Δ 40°00' Rt
D 6°
R 955.4'
T 347.7'
L 666.7'
E 61.3'
Bank Width 18'
409+86 Rt ~ 411+91 Rt
205 l.f. of Treated Timber Curbing Item 568
BM. #76
S.I.R. 10" Chy.
U.S. El. 1186.389
match line
meadow
1190
1180
1170
+2.765 %
+1.022 %
+0.153 %
+0.153 %
401+50
300' VC
-26.58
406+00
600' VC
1191.18
401 402 403 404 405 406 407 408 409 410 411 412 413 414 415 416 417
Belvidere
Project S N° 0283(1)
Sheet 11 of 90
5