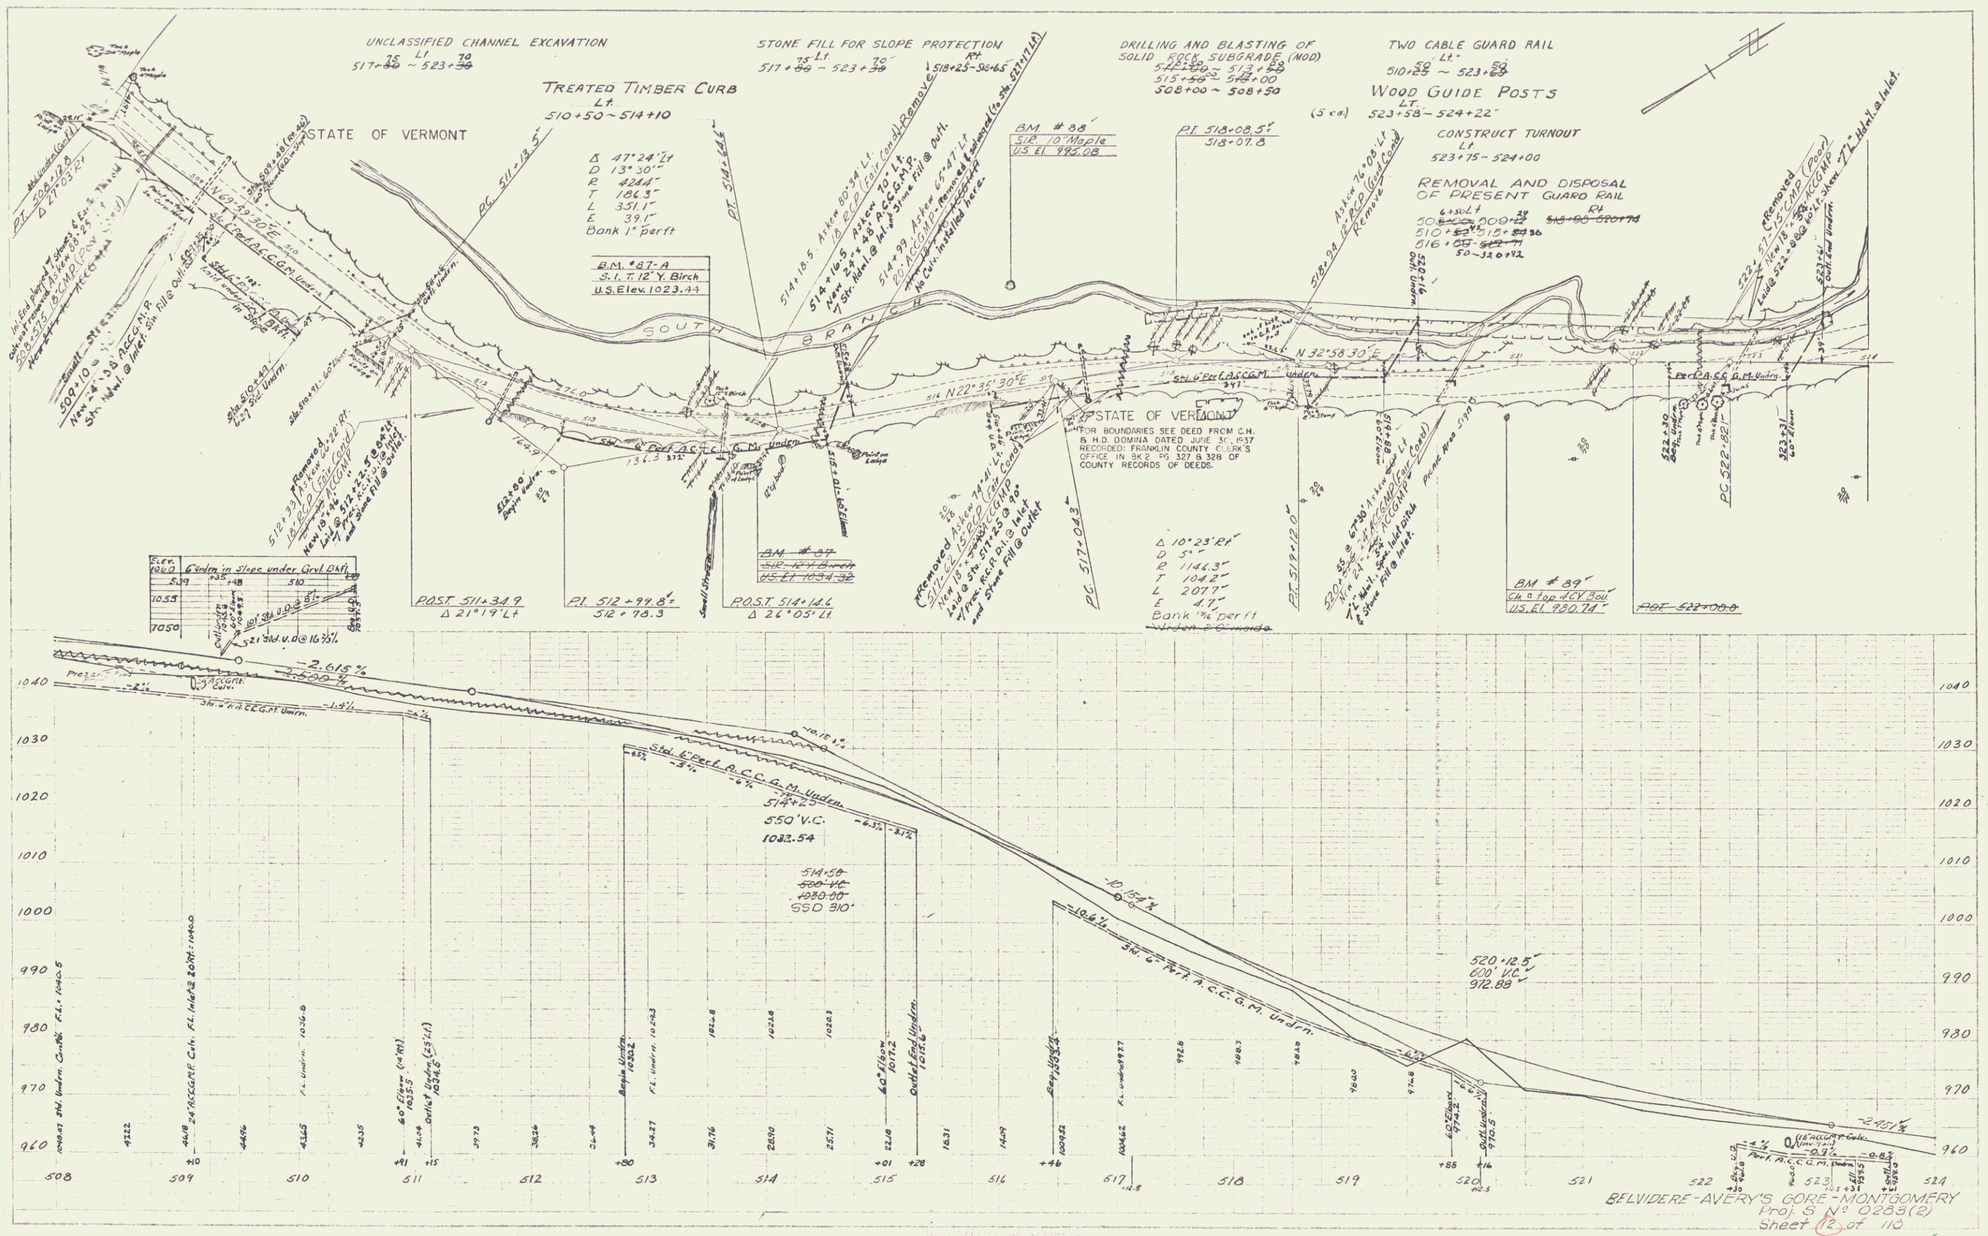
UNCLASSIFIED CHANNEL EXCAVATION
517+75 Lt ~ 523+70
STONE FILL FOR SLOPE PROTECTION
517+75 Lt ~ 523+70
DRILLING AND BLASTING OF SOLID ROCK SUBGRADE (MOD)
TWO CABLE GUARD RAIL
510+50 Lt ~ 523+50
WOOD GUIDE POSTS
523+58 ~ 524+22
(5 ea)
TREATED TIMBER CURB
Lt
510+50 ~ 514+10
STATE OF VERMONT
CONSTRUCT TURNOUT
Lt
523+75 ~ 524+00
REMOVAL AND DISPOSAL OF PRESENT GUARD RAIL
Rt
BM # 88
512 10" Maple
U.S. El 995.08
PI 518+08.5
518+07.8
B.M. #87-A
S.I.T. 12" Y. Birch
U.S. Elev. 1023.44
SOUTH BRANCH
N 32°58'30"E
N 22°35'30"E
STATE OF VERMONT
FOR BOUNDARIES SEE DEED FROM C.H. & H.D. DOMINA DATED JUNE 30, 1937 RECORDED: FRANKLIN COUNTY CLERK'S OFFICE IN BK 2 PG 327 & 328 OF COUNTY RECORDS OF DEEDS.
Δ 10°23' Rt
D 5°
R 1141.3'
T 104.2'
L 207.7'
E 4.7'
Bank 1½" perft
BM # 89
Ch. @ top of CV 3 ow
U.S. El 930.74
POST 511+34.9
Δ 21°19' Lt
PI 512+99.8
512+78.3
POST 514+14.6
Δ 26°05' Lt
PC 517+04.3
PT 519+12.0
PC 522+82.1
POST 522+00.0
Elev. 1060.0
6" Undrn. in Slope under Grvl. Dkt.
1055
1050
2.615 %
514+25
550' V.C.
1023.54
514+54
550 910'
520+12.5
600' V.C.
912.88
1040
1030
1020
1010
1000
990
980
970
960
508
509
510
511
512
513
514
515
516
517
518
519
520
521
522
523
524
BELVIDERE-AVERY'S GORE-MONTGOMERY
Proj. S No 0285(2)
Sheet 12 of 110

5