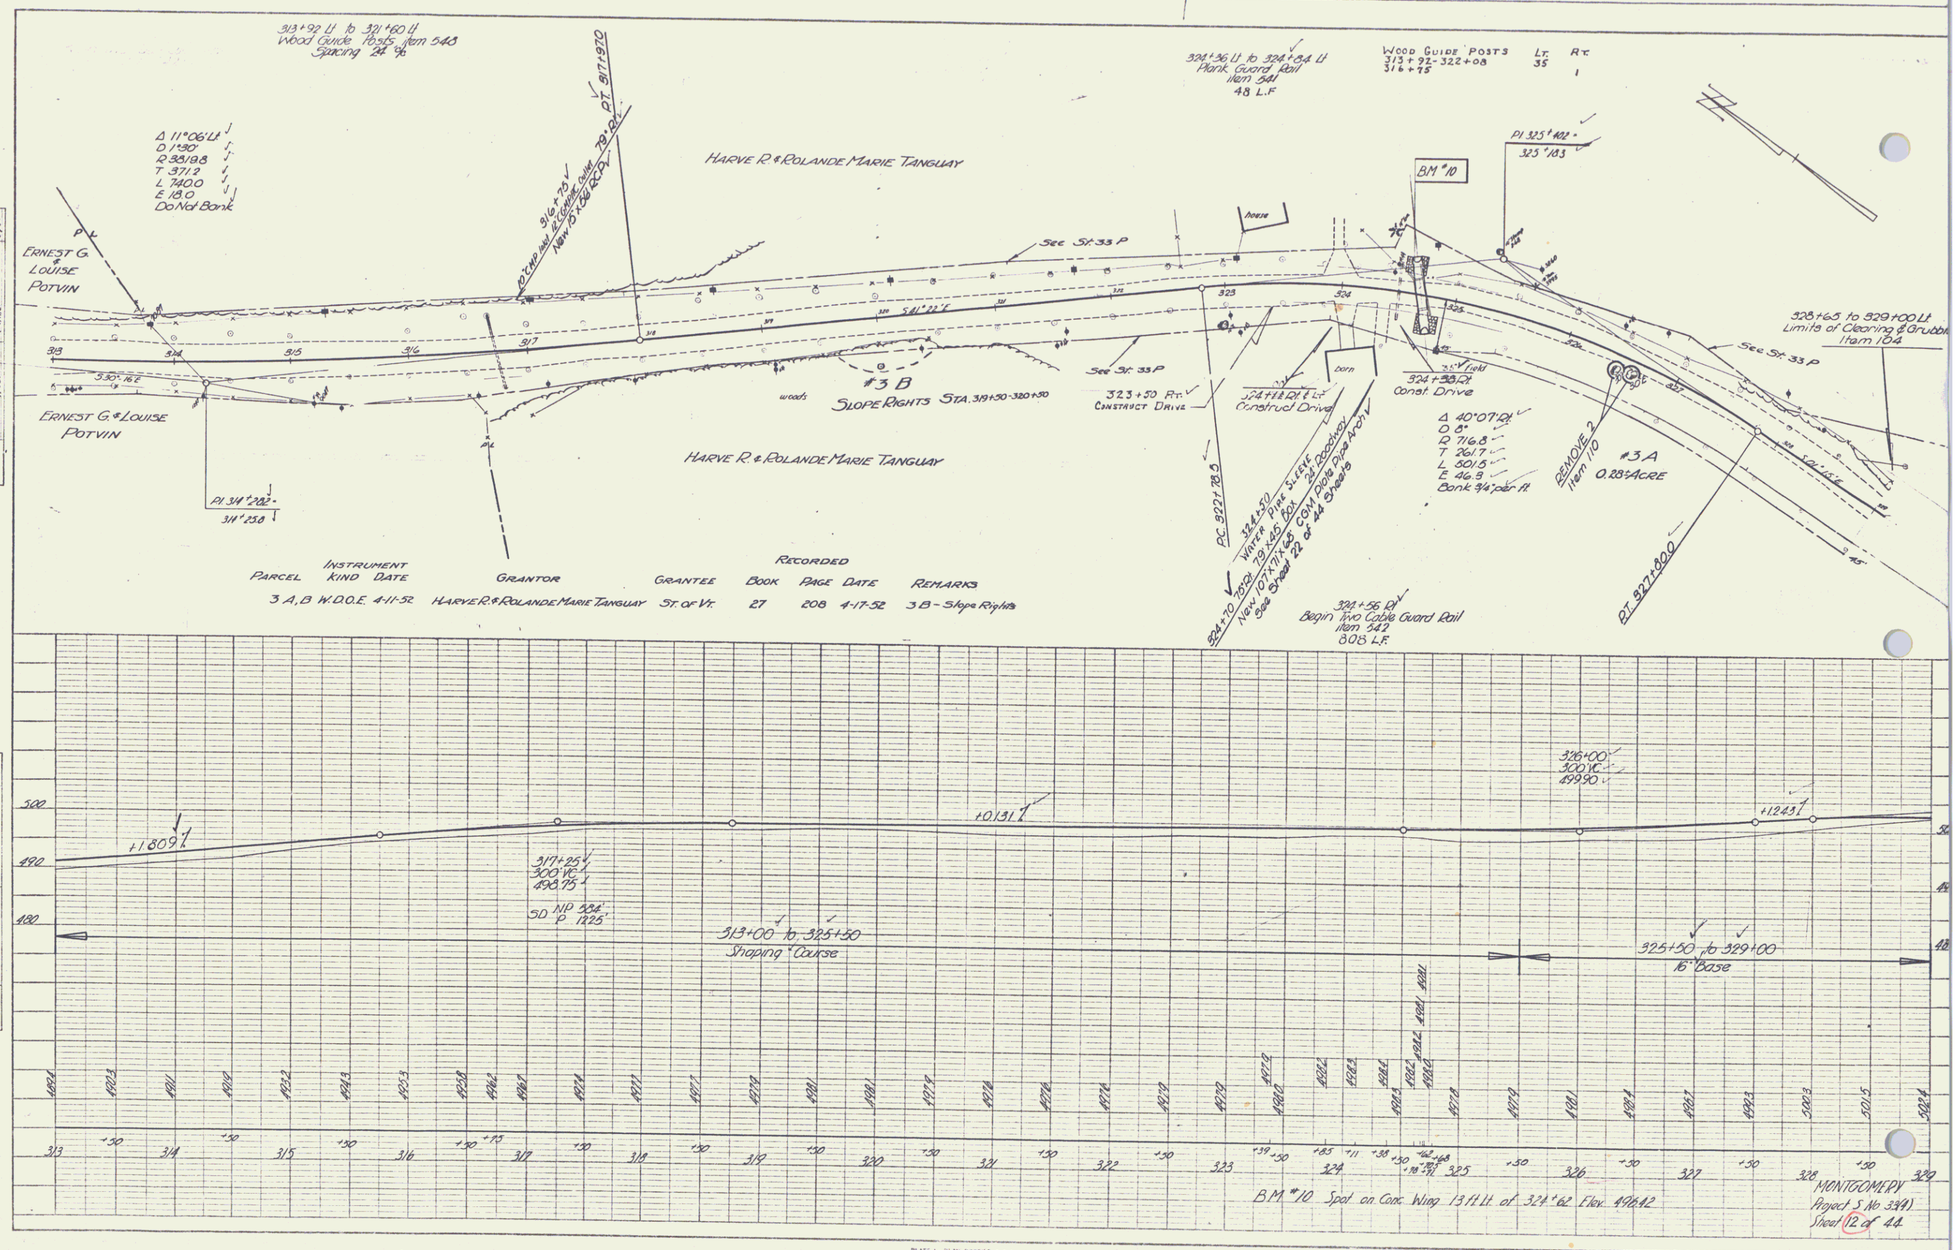

PLATE 1 - PLAN-PROFILE O.P.R.&R.E. STANDARD
HOUPT & EARLE COLLEGE YORK
A.&F. CO. NO. DARLINGTON