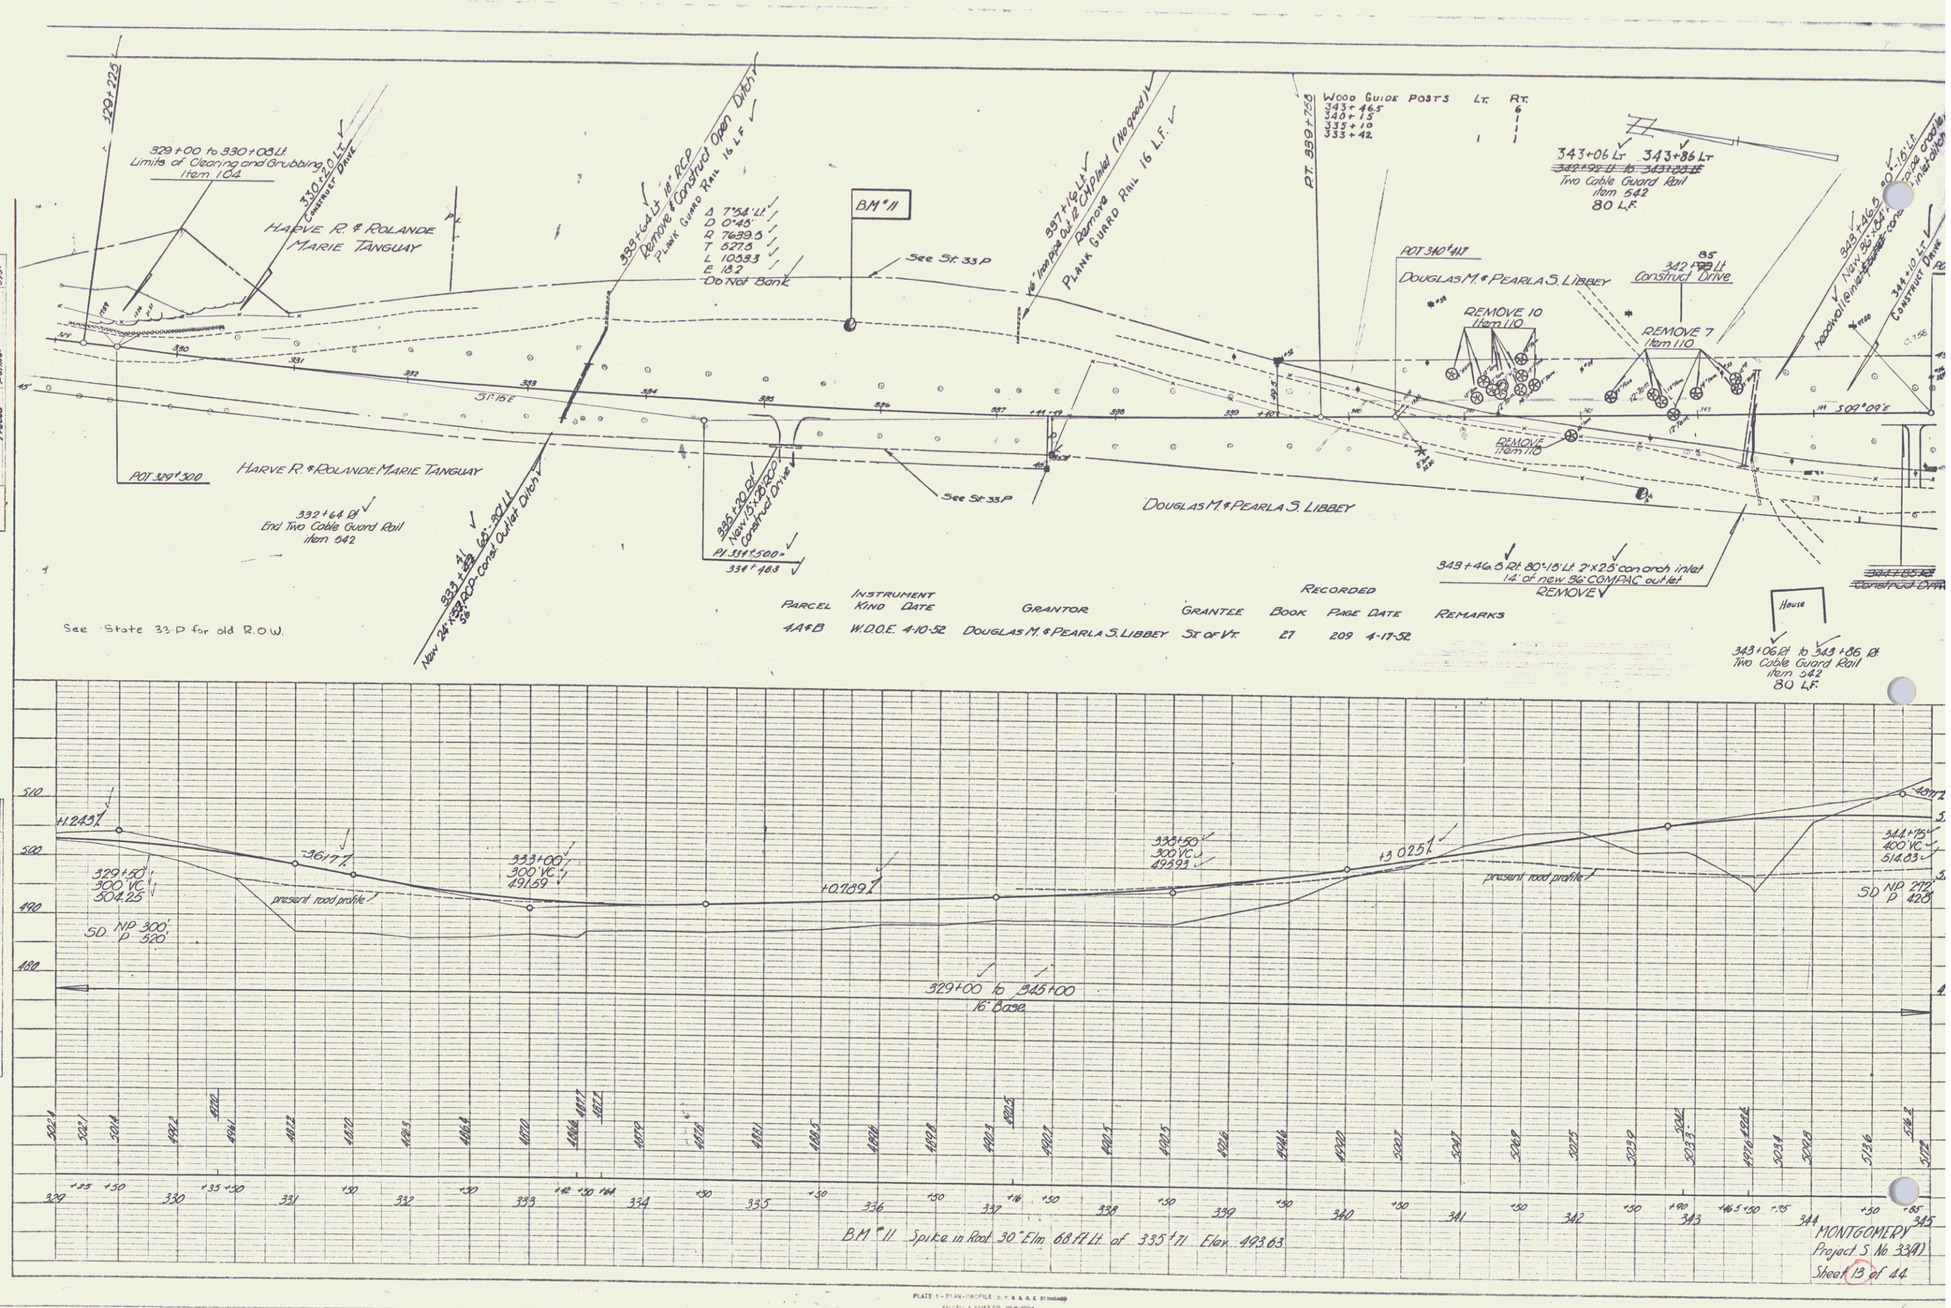
329+00 to 330+08 Lt
Limits of Clearing and Grubbing
Item 104
330+20 Lt
Construct Drive
HARVE R. & ROLANDE MARIE TANGUAY
Remove & Construct Open Ditch
Plank Guard Rail 16 L.F.
Δ 7°54' Lt
D 0°45'
R 7639.3
T 527.5
L 1053.3
E 18.2
Do Not Back
BM #11
See St. 33 P
337+16 Lt
18" Inlet pipe out & Cut Inlet (No pay)
Remove
Plank Guard Rail 16 L.F.
PT. 339+75
Wood Guide Posts Lt. Rt.
343+46.5
340+15
339+10
338+42
343+06 Lt 343+86 Lt
Two Cable Guard Rail
Item 542
80 L.F.
POT 340+41.7
DOUGLAS M. & PEARLA S. LIBBEY
REMOVE 10
Item 110
342+79 Lt
Construct Drive
REMOVE 7
Item 110
REMOVE
Item 110
343+46.5 Lt
Construct Drive
S 02°00'E
POT 329+300
HARVE R. & ROLANDE MARIE TANGUAY
332+64 Rt
End Two Cable Guard Rail
Item 542
333+60 Rt
New 24" x 30' RCP
Cond. Outlet Ditch
338+30 Rt
New 15" x 20' RCP
Construct Drive
PI 331+500=
331+483
See St. 33 P
DOUGLAS M. & PEARLA S. LIBBEY
343+46.5 Rt 80'-15' Lt 2'x2.5' con arch inlet
14' of new 36" COMPAC outlet
REMOVE
Construct Drive
House
343+06 Rt to 343+86 Rt
Two Cable Guard Rail
Item 542
80 L.F.
See State 33 P for old R.O.W.
PLAN
SCALE 1" = 50'
DATE 12-5-51
SURVEYED Jankelevich
PLOTTED Palmer
NOTE BOOK
LAYOUT CHECKED
RT. OF WAY CHECKED
PROFILE
SCALE H 1" = 50'
V 1" = 5'
DATE 12-3-51
SURVEYED
PLOTTED
NOTE BOOK
LAYOUT CHECKED
R. M. S. NOTED
NO.
TOPOGRAPHY TRIALS ON CARD
510
500
490
480
+12.43
-36.17
+07.89
+13.02
329+50
300' VC
504.25
SD NP 300'
P 520'
333+00
300' VC
491.59
330+50
300' VC
493.93
present road profile
329+00 to 345+00
16' Base
344+75
400' VC
514.03
SD NP 270'
P 420'
329 +25 +50 330 +35 +50 331 +50 332 +50 333 +42 +50 +64 334 +50 335 +50 336 +50 337 +16 +50 338 +50 339 +50 340 +50 341 +50 342 +50 343 +90 +46.5 +50 +75 344 +50 +85 345
B.M. #11 Spike in Root 30" Elm 68'±Lt of 335+11 Elev. 493.63
PARCEL 1A & B
INSTRUMENT KIND W.D.O.E. DATE 4-10-52
GRANTOR DOUGLAS M. & PEARLA S. LIBBEY
GRANTEE St. of Vt.
RECORDED BOOK 27 PAGE 209 DATE 4-17-52
REMARKS
MONTGOMERY
Project S No. 3391
Sheet 13 of 44
PLATE 1 — PLAN-PROFILE O. P. R. & A. E. STANDARD
HAUPT & EVANS CO., NEW YORK
N.A.E.C. No. 3481-1 58052