| PARCEL | INSTRUMENT | DATE | GRANTOR | GRANTEE | RECORDED MONTGOMERY BOOK | PAGE | DATE | REMARKS |
|---|---|---|---|---|---|---|---|---|
| B | W.D.O.E | 11-6-60 | ERNEST J. MARTIN | ST. OF VT. | 25 | 35-36 | 11-9-60 | 1 CULV |

State
33P (1) 1940 + 23
Ext.

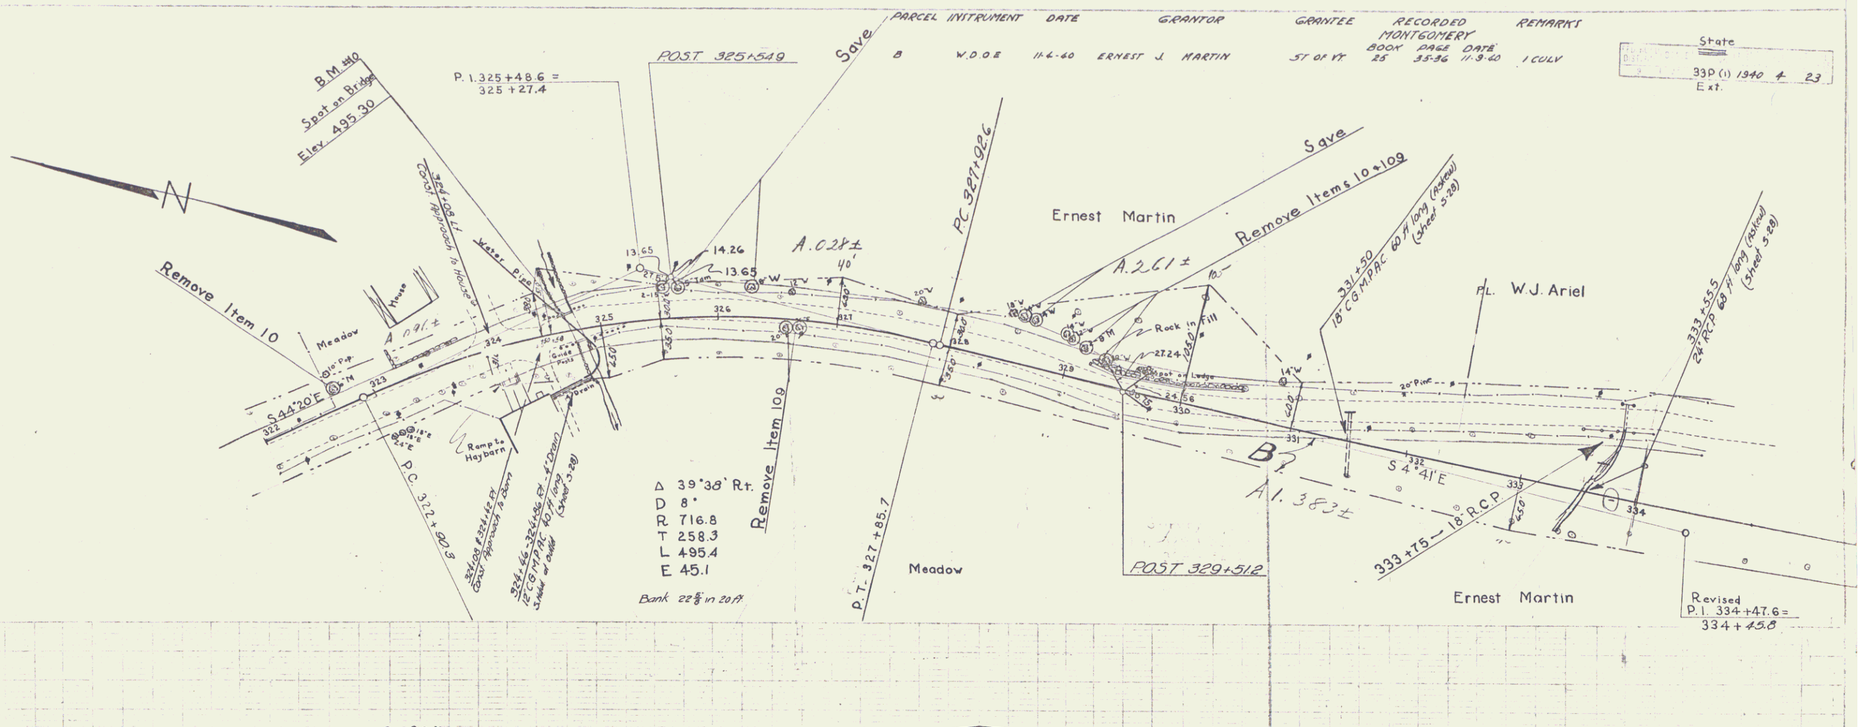


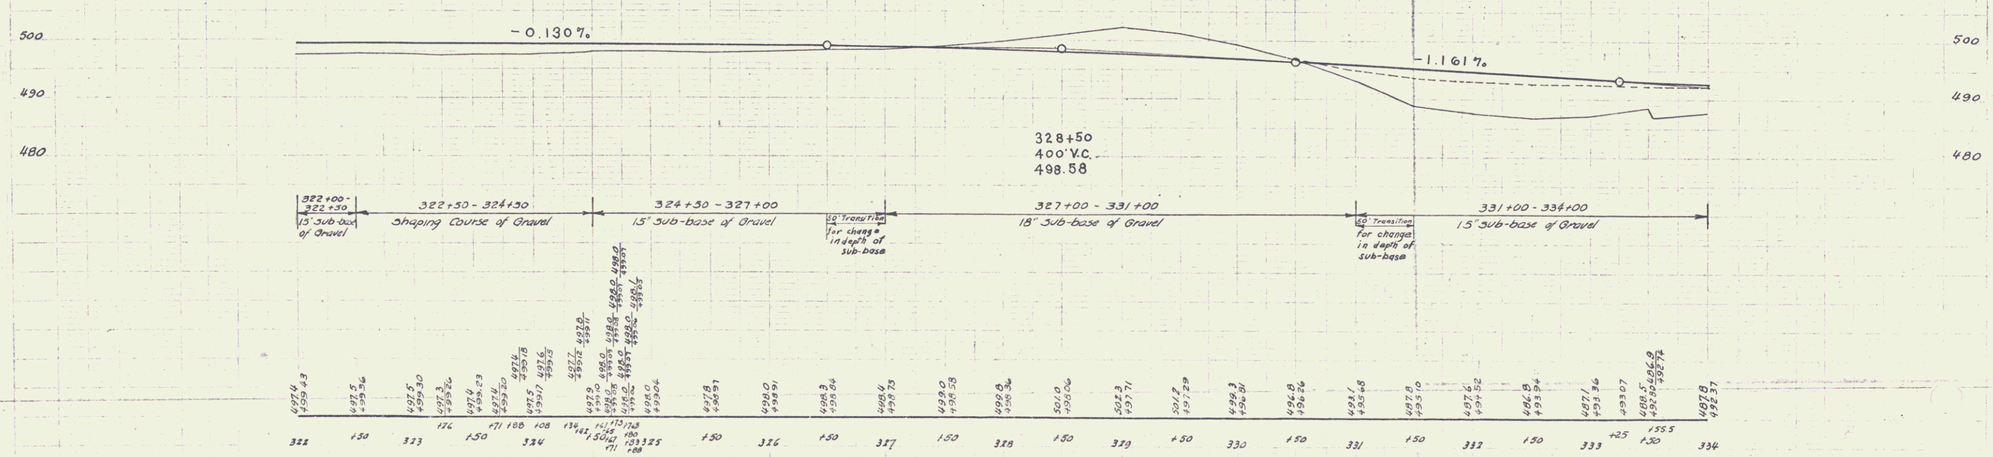


B.M. #10 Spot on bridge Lt. 13.5 ft at Sta. 324+72 Elev. 495.30

Montgomery 33-P.1 Ext.
Sheet 4 of 23 Sheets

10