INSTRUMENT	DATE	GRANTOR	GRANTEE	RECORDED MONTGOMERY BOOK	PAGE	DATE	REMARKS
W.D.O.E.	3-22-49	HORACE & DONALD RUSHFORD	ST. OF VT.	27	93	3-29-49	(SEE SW.13 FOR PART OF "A")
W.D.O.E.	3-23-49	CHARLES H. KENNITH	DI. 49+726 - -	"	90	3-29-49	(" " 15 " " " "C")

FED. ROAD DIST. NO.	STATE	S PROJ. NO.	FISCAL YEAR	SHEET NO.
9	VT.	330		14

POST WAR F A SEC

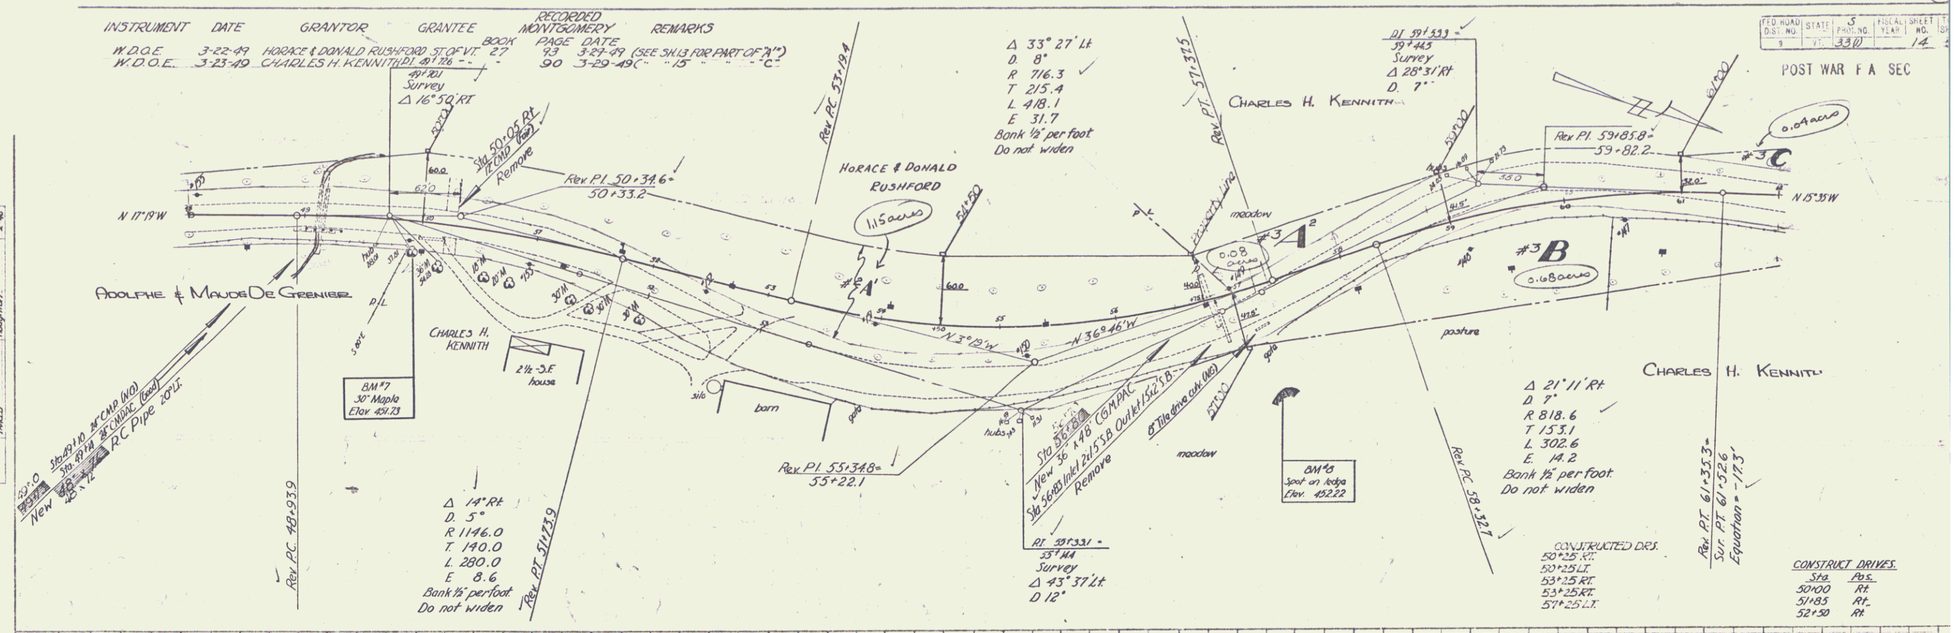

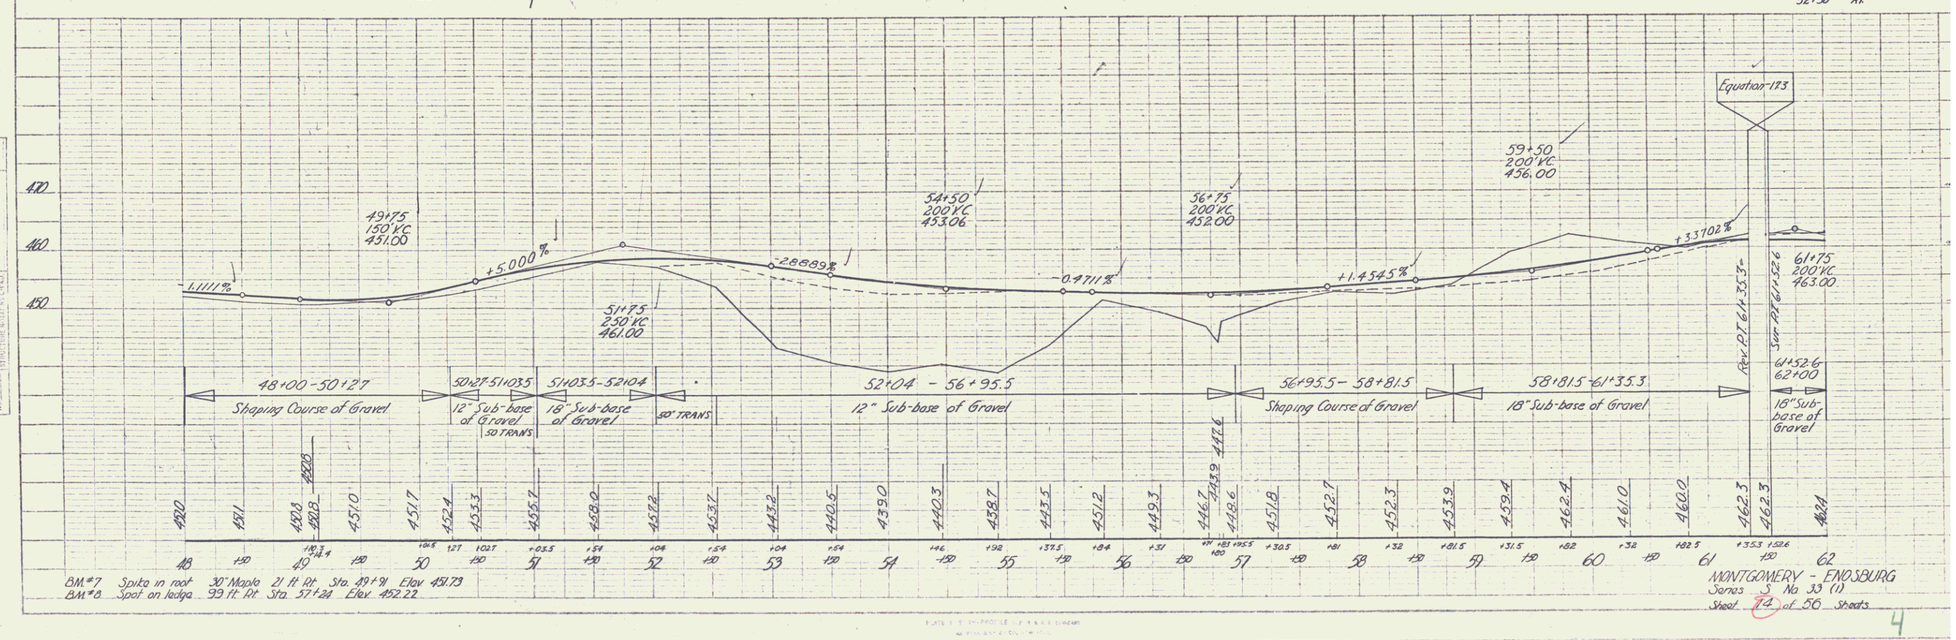

4