FED. ROAD DIST. NO.	STATE	S PROJ. NO.	FISCAL YEAR	SHEET NO.
3	VT.	3300		15

POST WAR F A SEC

PARCEL	INSTRUMENT	DATE	GRANTOR	GRANTEE	RECORDED MONTGOMERY BOOK	PAGE	DATE	REMARKS
#5-A1,B,C&D #4 3-4,3	W.D.O.E.	3-22-49	FRED WADLEIGH	ST. OF VT.	27	89	3-29-49	SEE SH. 16 FOR #5 C&D
	W.D.O.E.	3-22-49	HARRY & MYRON DUTCHBURN	" "	27	92	3-29-49	

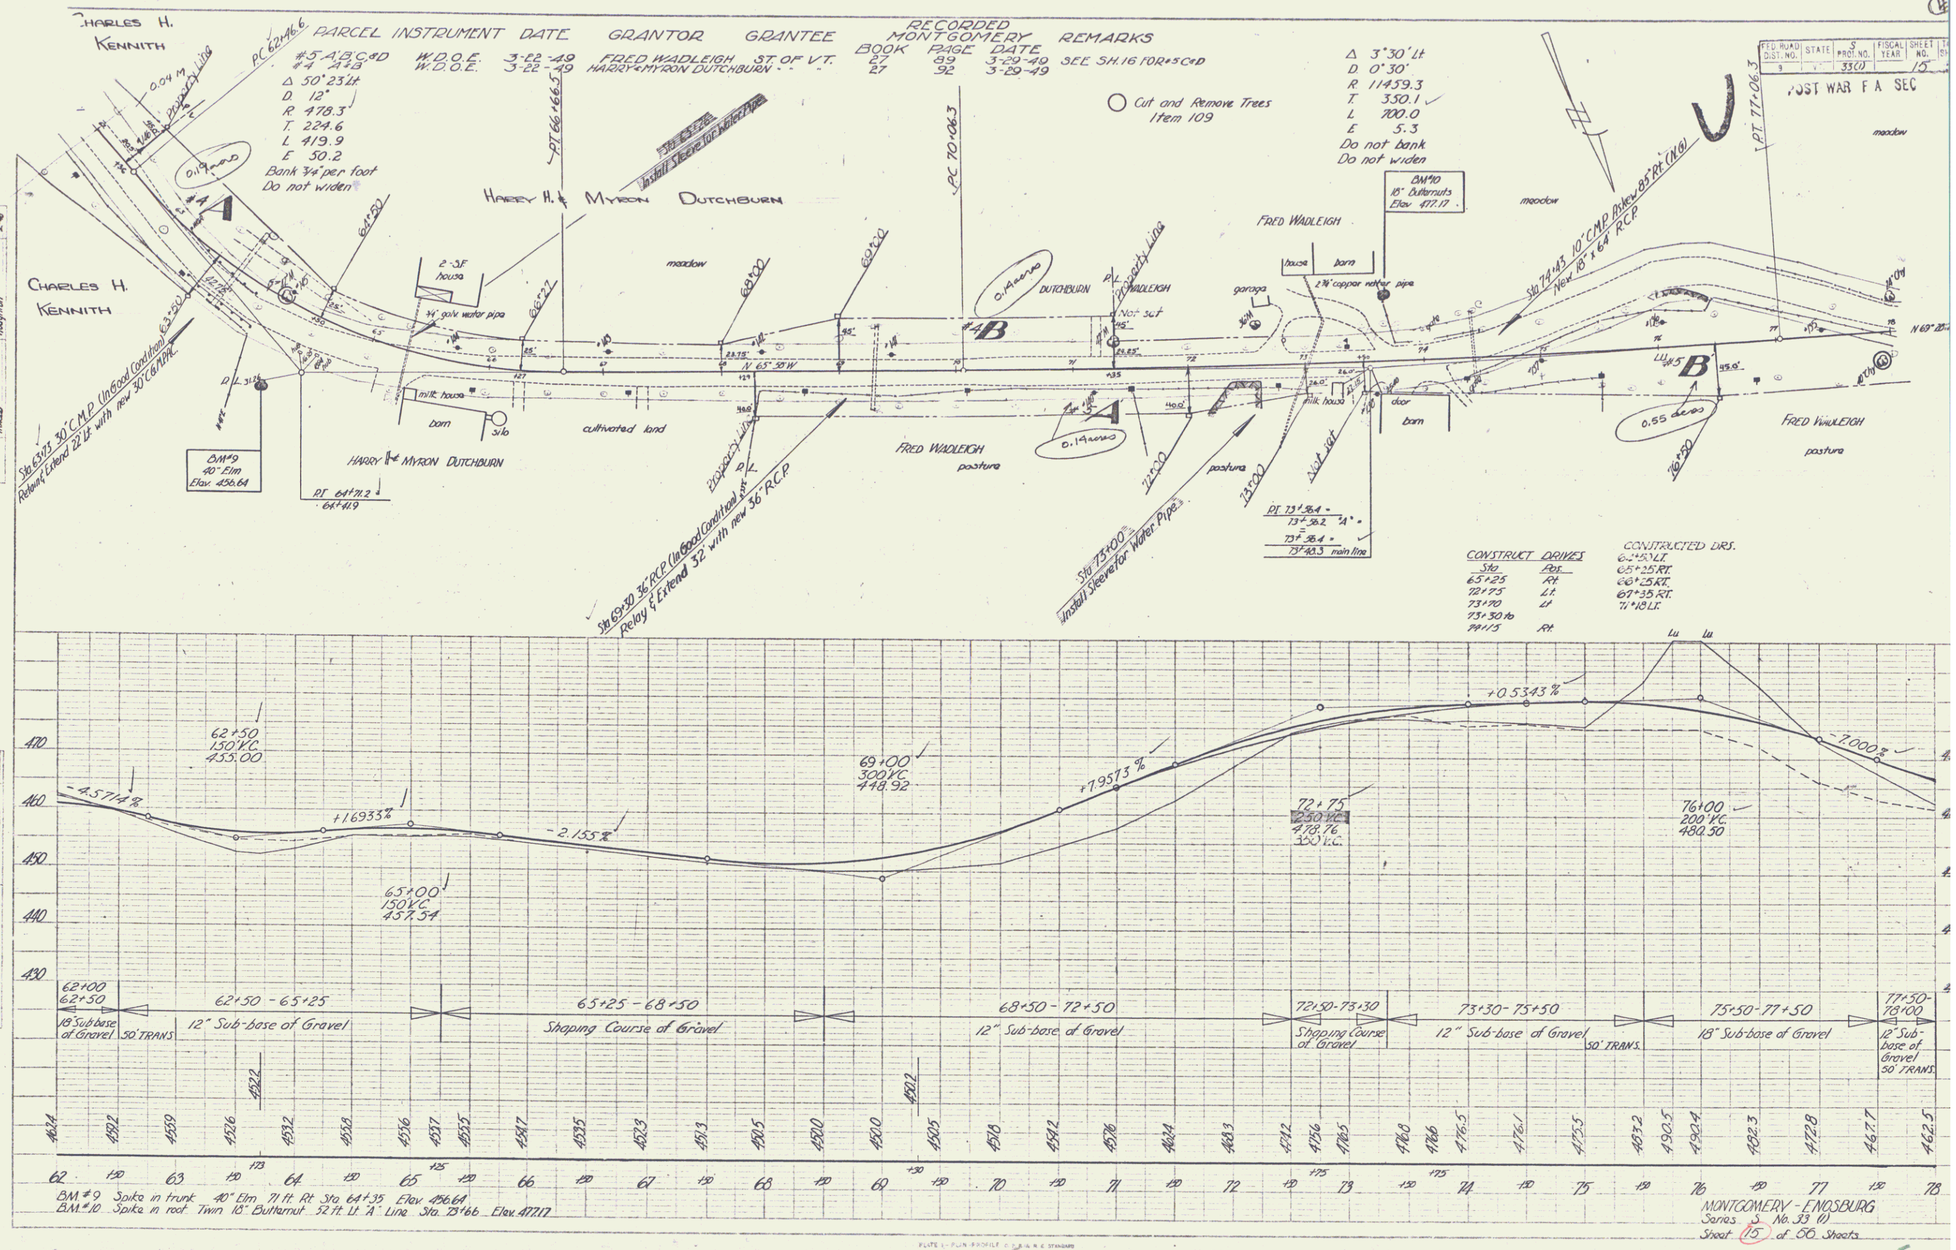

PLAN
DRAWN BY Fischer
CHECKED BY Fischer
NOTE BOOK NO. AND PAGE
ESTIMATE CHECKED
STRUCTURE
NO. STRUCTURE NOTE BOOK NO. AND PAGE
Houghton
PROFILE
DRAWN BY Fischer
CHECKED BY Fischer, Jr.
NOTE BOOK NO. AND PAGE 12-6
ESTIMATE CHECKED 12-8
STRUCTURE NOTE BOOK NO. AND PAGE 3-18
Houghton

PLATE I - PLAN-PROFILE C.P.R.&N.E. STANDARD
ESSEL & CLARK CO. NEW YORK

5