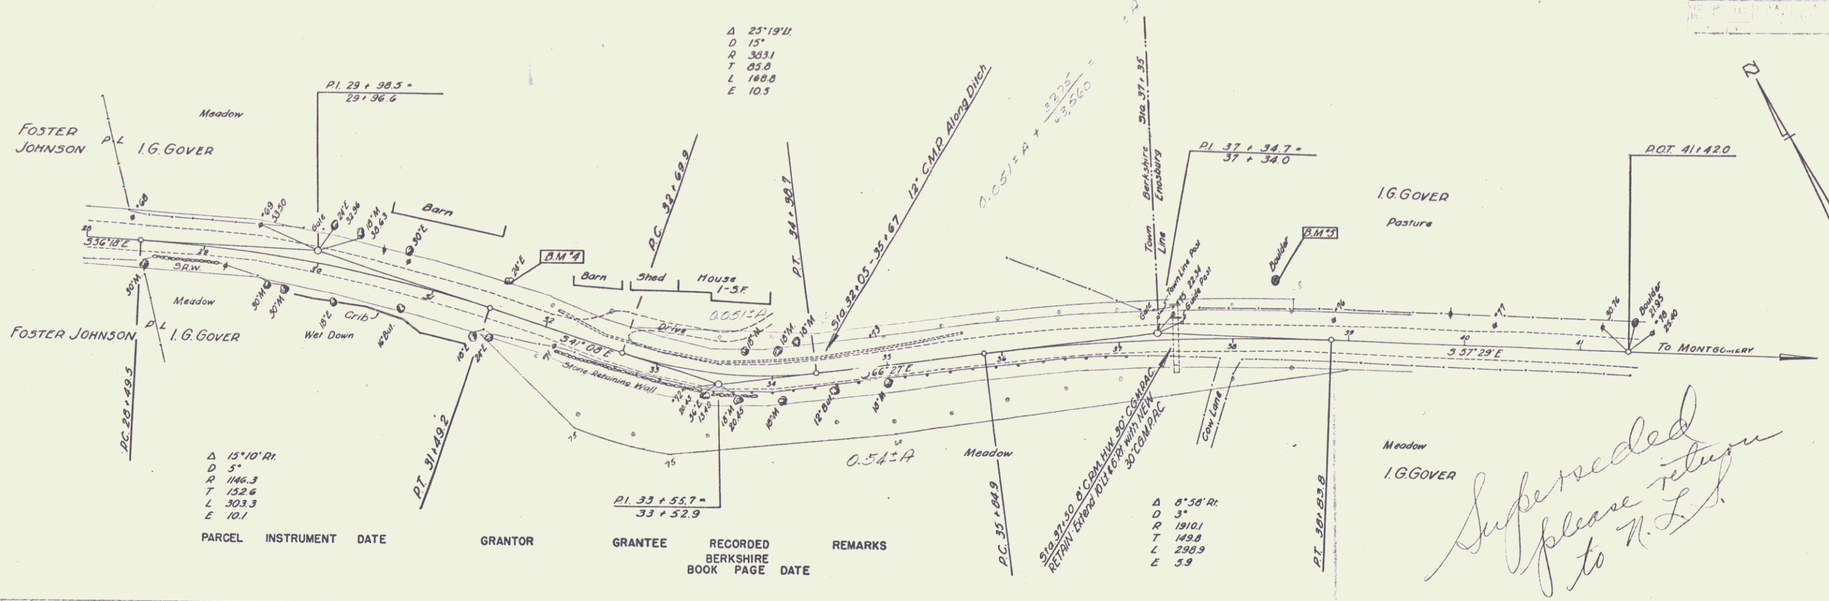

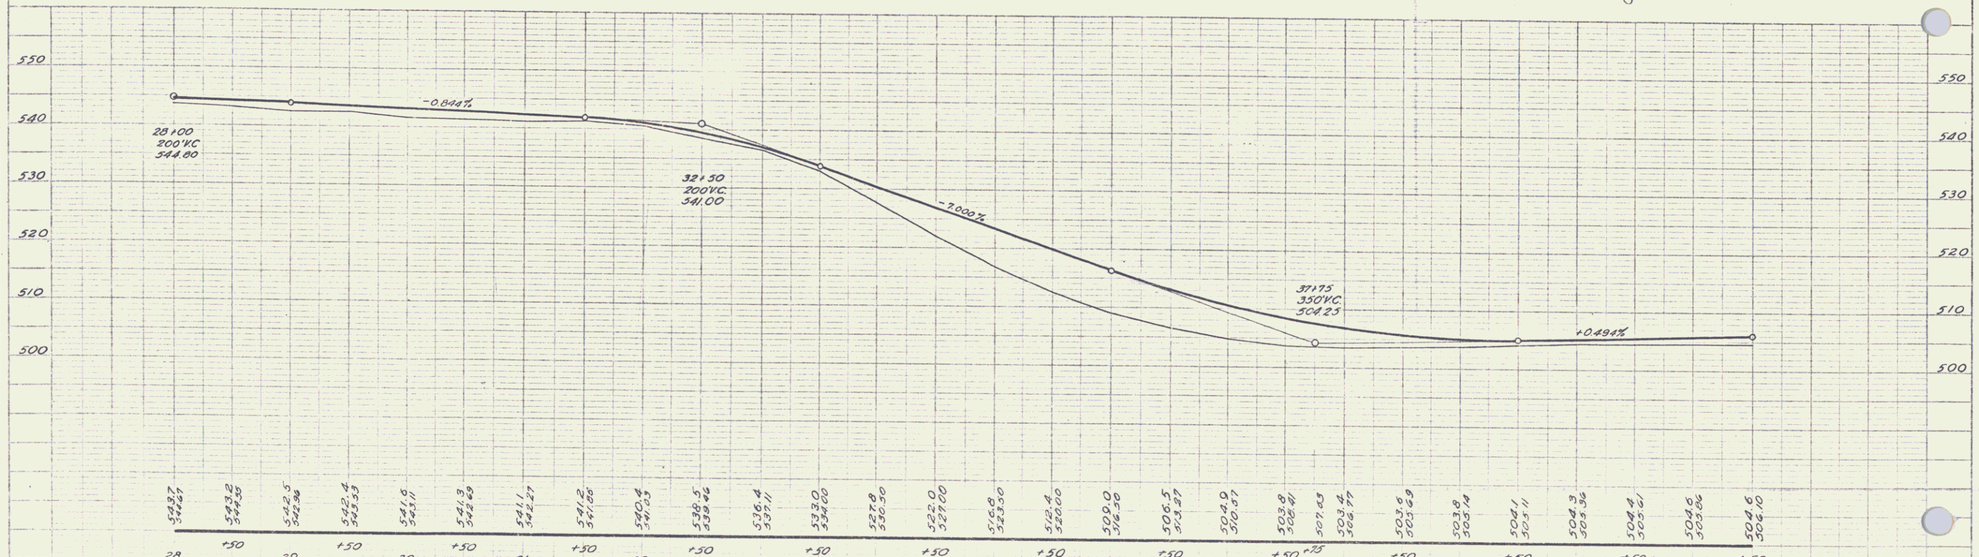

EAST BERKSHIRE

4