INDEX OF SHEETS

1 TITLE SHEET
2 TYPICAL SHEET
3 EARTHWORK, DRAINAGE & QUANTITY SHEET
4-5 PLAN AND PROFILE SHEETS
7 C-1 CURBS
8 D-1 HEADWALLS
9 E-1 BARRICADES, SIGNS AND LIGHTS
10 J-1 ERECTION OF PROJECT MARKERS
11-12 S8.5P x 18 #12 DETAILS OF ROUND PLATE PIPE
13 SIGN DESIGN SHEET
14 SIGN SUMMARY SHEET
15-16 OVERHEAD SIGN STRUCTURE
17-20 CROSS-SECTION SHEETS

PROJECT NAME & NUMBER	TYPE PAVEMENT	AREA
POWNAL ST 019-1-6501	3" BIT. CONC.	15,220 S.Y.

RECORD PLANS

MATERIALS

GRAVEL PODVAH PIT POWNAL, VT.
PAVING LAFARGE MOHAWK STONE PRED. CO. NORTH ADAMS MASS.
MATERIAL PLANT WM. DAILEY PLANT SHAFTSBURY, VT.
12" PIPE NECULVET WESTMINSTER, VT.
SEED WHITNEY SEED CO. BUFFALO, N.Y.
FERTILIZER AM. AGRIC. CHEM. CO. NO. WEYMOUTH MASS.
OVERHEAD SIGNS DELETED

CONTRACTOR W.H. MORSE CONSTR. CO. INC. BENNINGTON, VT.
RESIDENT ENGINEER J.W. STEARNS
RECORD PLANS J.A. STEARNS & S.J. WHITNEY

CONTRACT
DATED SEPT. 2, 1965
STARTED SEPT. 7, 1965
COMPLETED SEPT. 30, 1965
ACCEPTED OCT. 7, 1965

STATE OF VERMONT
DEPARTMENT OF HIGHWAYS

PROPOSED IMPROVEMENT

TOWN OF POWNAL
COUNTY OF BENNINGTON
U.S. ROUTE 7
WILLIAMSTOWN, MASS.-BENNINGTON, VT. ROAD

BEGINNING AT A POINT 0.719 MILE NORTHWESTERLY OF THE VERMONT-MASSACHUSETTS STATE LINE AND EXTENDING NORTHWESTERLY 1.081 MILES.

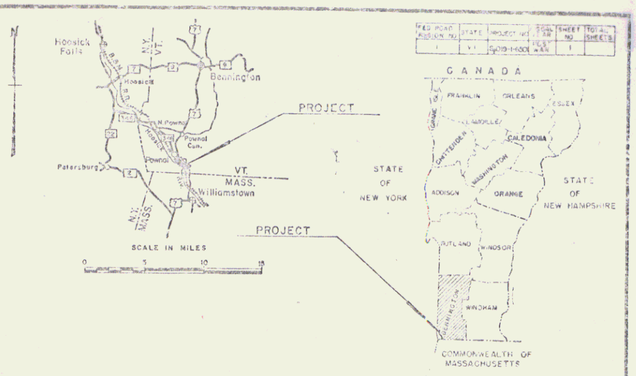

FED. ROAD REGION NO.	STATE	PROJECT NO.	TOTAL SHEETS	SHEET NO.	TOTAL SHEETS
1	VT.	S019-1-6501		1	

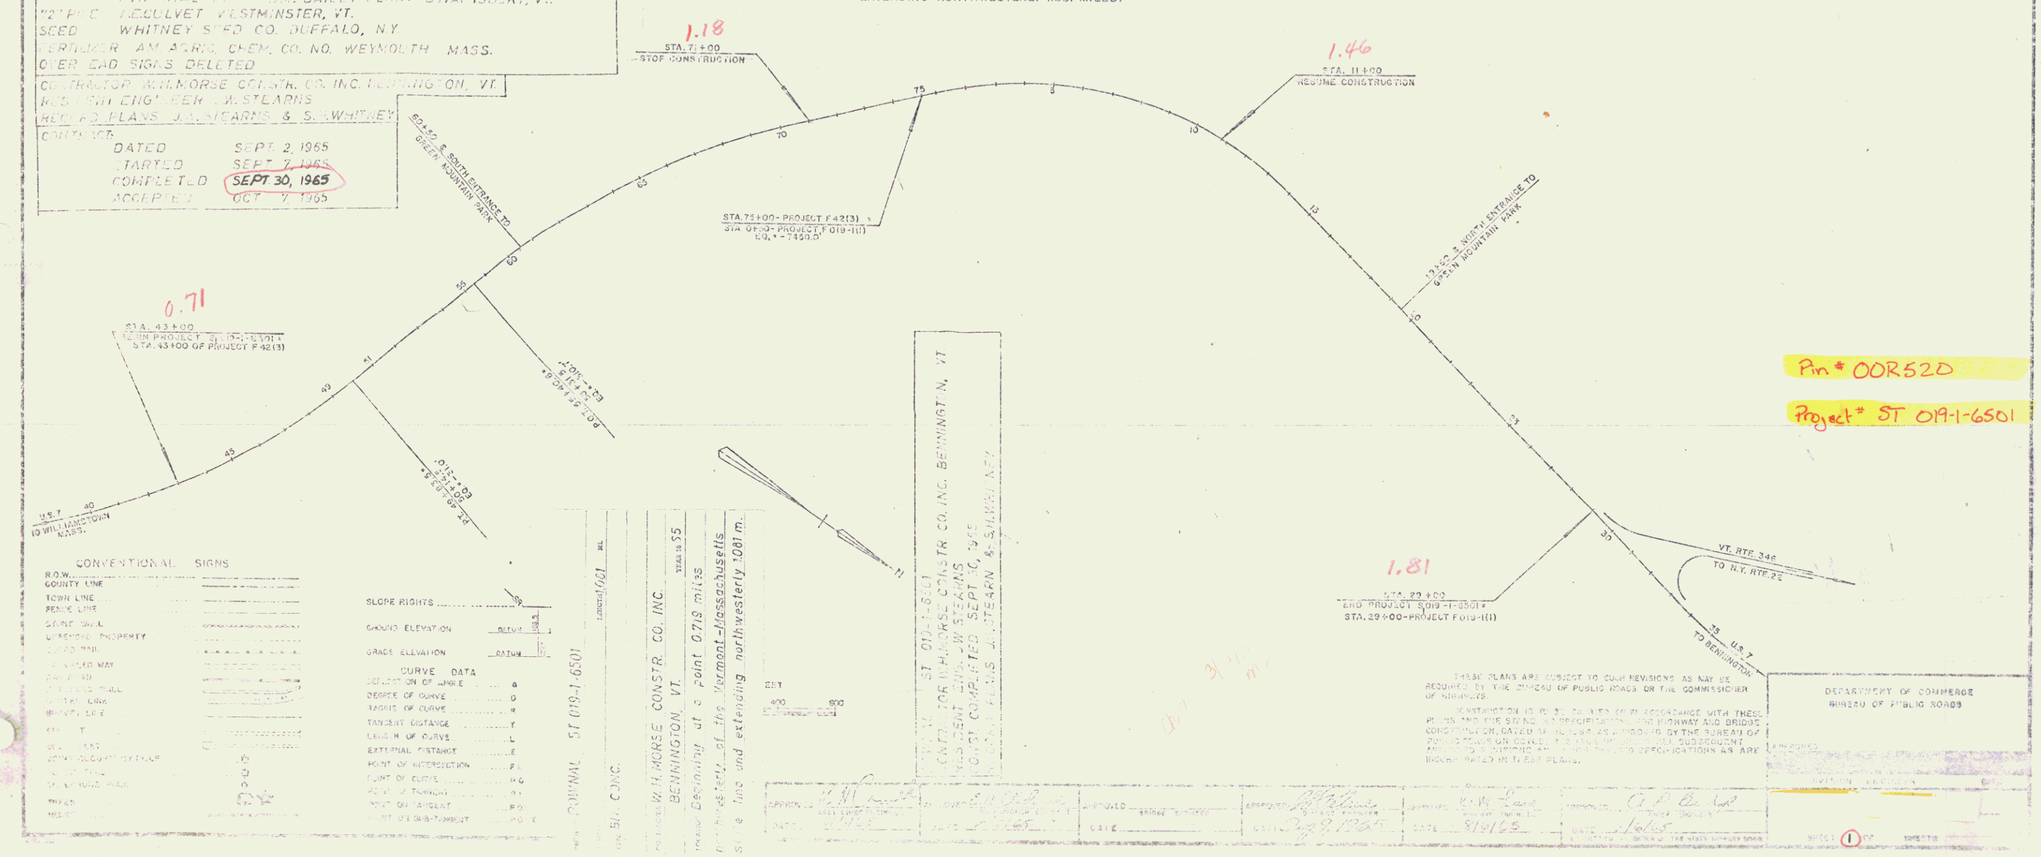

CONVENTIONAL SIGNS

R.O.W.
COUNTY LINE
TOWN LINE
FENCE LINE
CURVE SHOULDER
CONTROLLED PROPERTY
CURB
UNCONTROLLED WAY
CAR PARKING
CONCRETE WALL
CUTBACK LINE
SURVEY LINE
CATCH BASIN
CONVEX SLOPE OR EDGE
CULVERT
CONCRETE HEADWALL
TREES
SHRUBS

SLOPE RIGHTS
GROUND ELEVATION DATUM
GRADE ELEVATION DATUM

CURVE DATA

DEFLECTION OF ANGLE	Δ
DEGREE OF CURVE	D
RADIUS OF CURVE	R
TANGENT DISTANCE	T
LENGTH OF CURVE	L
EXTERNAL DISTANCE	E
POINT OF INTERSECTION	P.I.
POINT OF CURVE	P.C.
POINT OF TANGENT	P.T.
POINT ON TANGENT	P.O.T.
POINT ON SUB-TANGENT	P.O.S.T.

POWNAL ST 019-1-6501
W.H. MORSE CONSTR. CO. INC.
BENNINGTON, VT.
RESIDENT ENGINEER J.W. STEARNS
WORK COMPLETED SEPT. 7, 1965
CONTRACT PLANS J.A. STEARN & S.J. WHITNEY

POWNAL ST 019-1-6501
CONTRACTOR W.H. MORSE CONSTR. CO. INC. BENNINGTON, VT.
RESIDENT ENGINEER J.W. STEARNS
WORK COMPLETED SEPT. 7, 1965
CONTRACT PLANS J.A. STEARN & S.J. WHITNEY

THESE PLANS ARE SUBJECT TO SUCH REVISIONS AS MAY BE REQUIRED BY THE BUREAU OF PUBLIC ROADS OR THE COMMISSIONER OF HIGHWAYS.

CONSTRUCTION IS TO BE COMPLETED IN ACCORDANCE WITH THESE PLANS AND THE STANDARD SPECIFICATIONS FOR HIGHWAY AND BRIDGE CONSTRUCTION, DATED [illegible], AND ADOPTED BY THE BUREAU OF PUBLIC ROADS ON [illegible], [illegible] AND SUBSEQUENT AMENDMENTS, SUPPLEMENTARY SPECIFICATIONS AND ARE INCORPORATED IN THESE PLANS.

DEPARTMENT OF COMMERCE
BUREAU OF PUBLIC ROADS

APPROVED [illegible] DATE [illegible]
APPROVED [illegible] DATE [illegible]
APPROVED [illegible] DATE [illegible]
APPROVED [illegible] DATE 8/19/65
APPROVED [illegible] DATE [illegible]

SHEET 1 OF [illegible] SHEETS