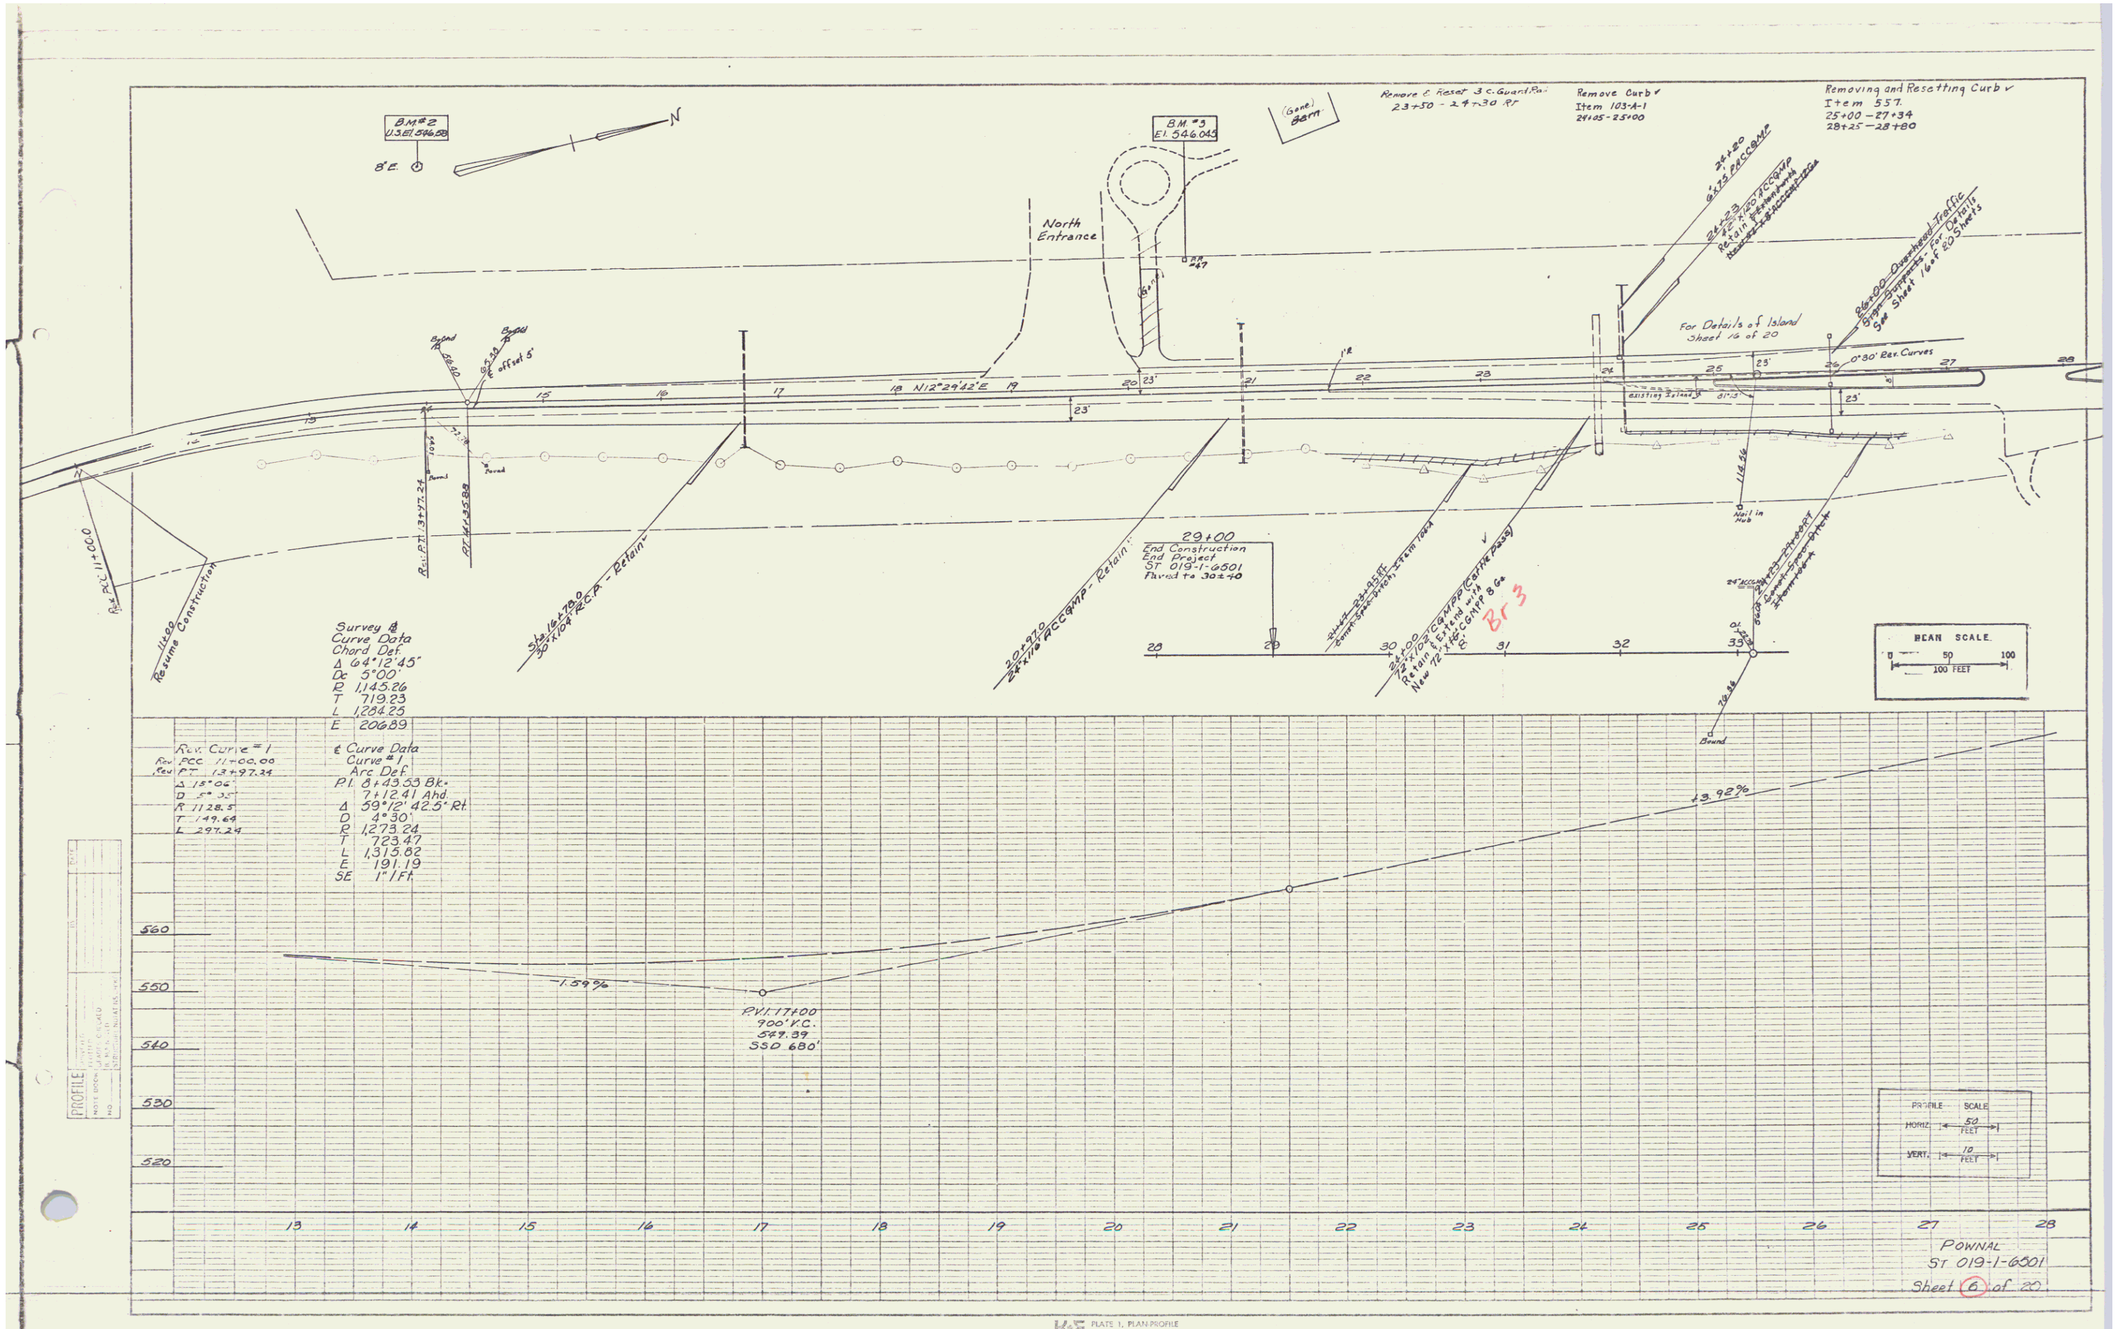

K+E PLATE 1, PLAN-PROFILE KEUFFEL & ESSER CO.

48 7012 IMPERIAL TRACING CLOTH