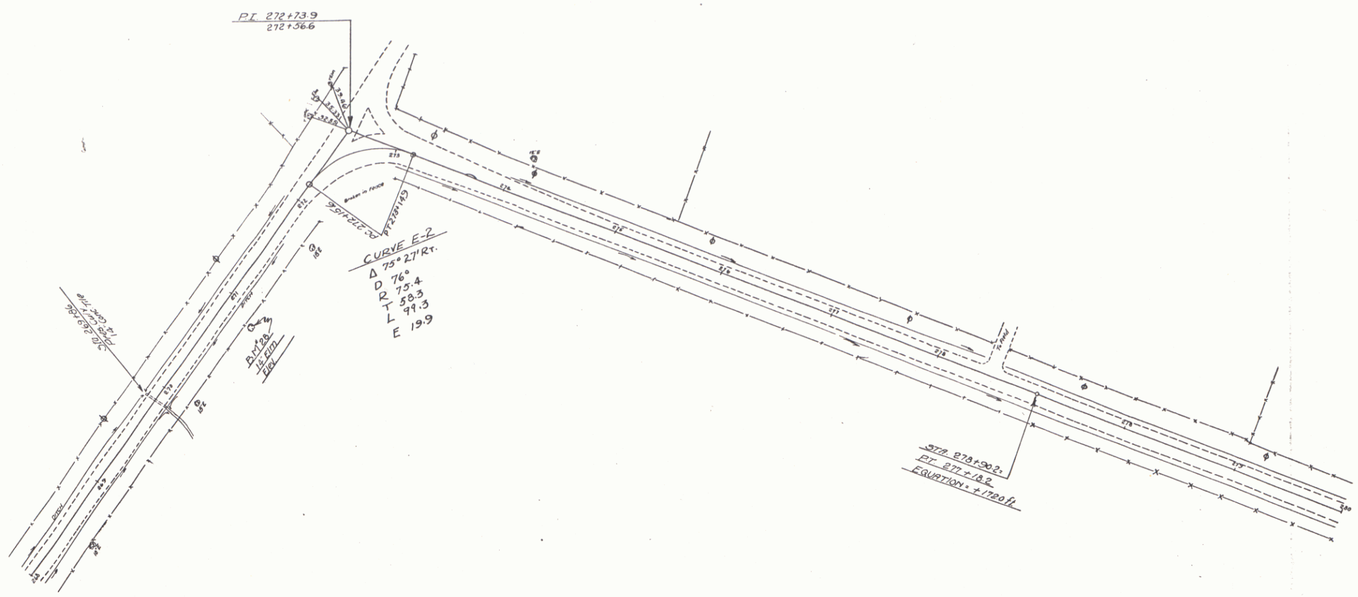


PLATE 1—PLAN—PROFILE C. P. R. & R. E. STANDARD
KEUFFEL & ESSER CO. NEW YORK