



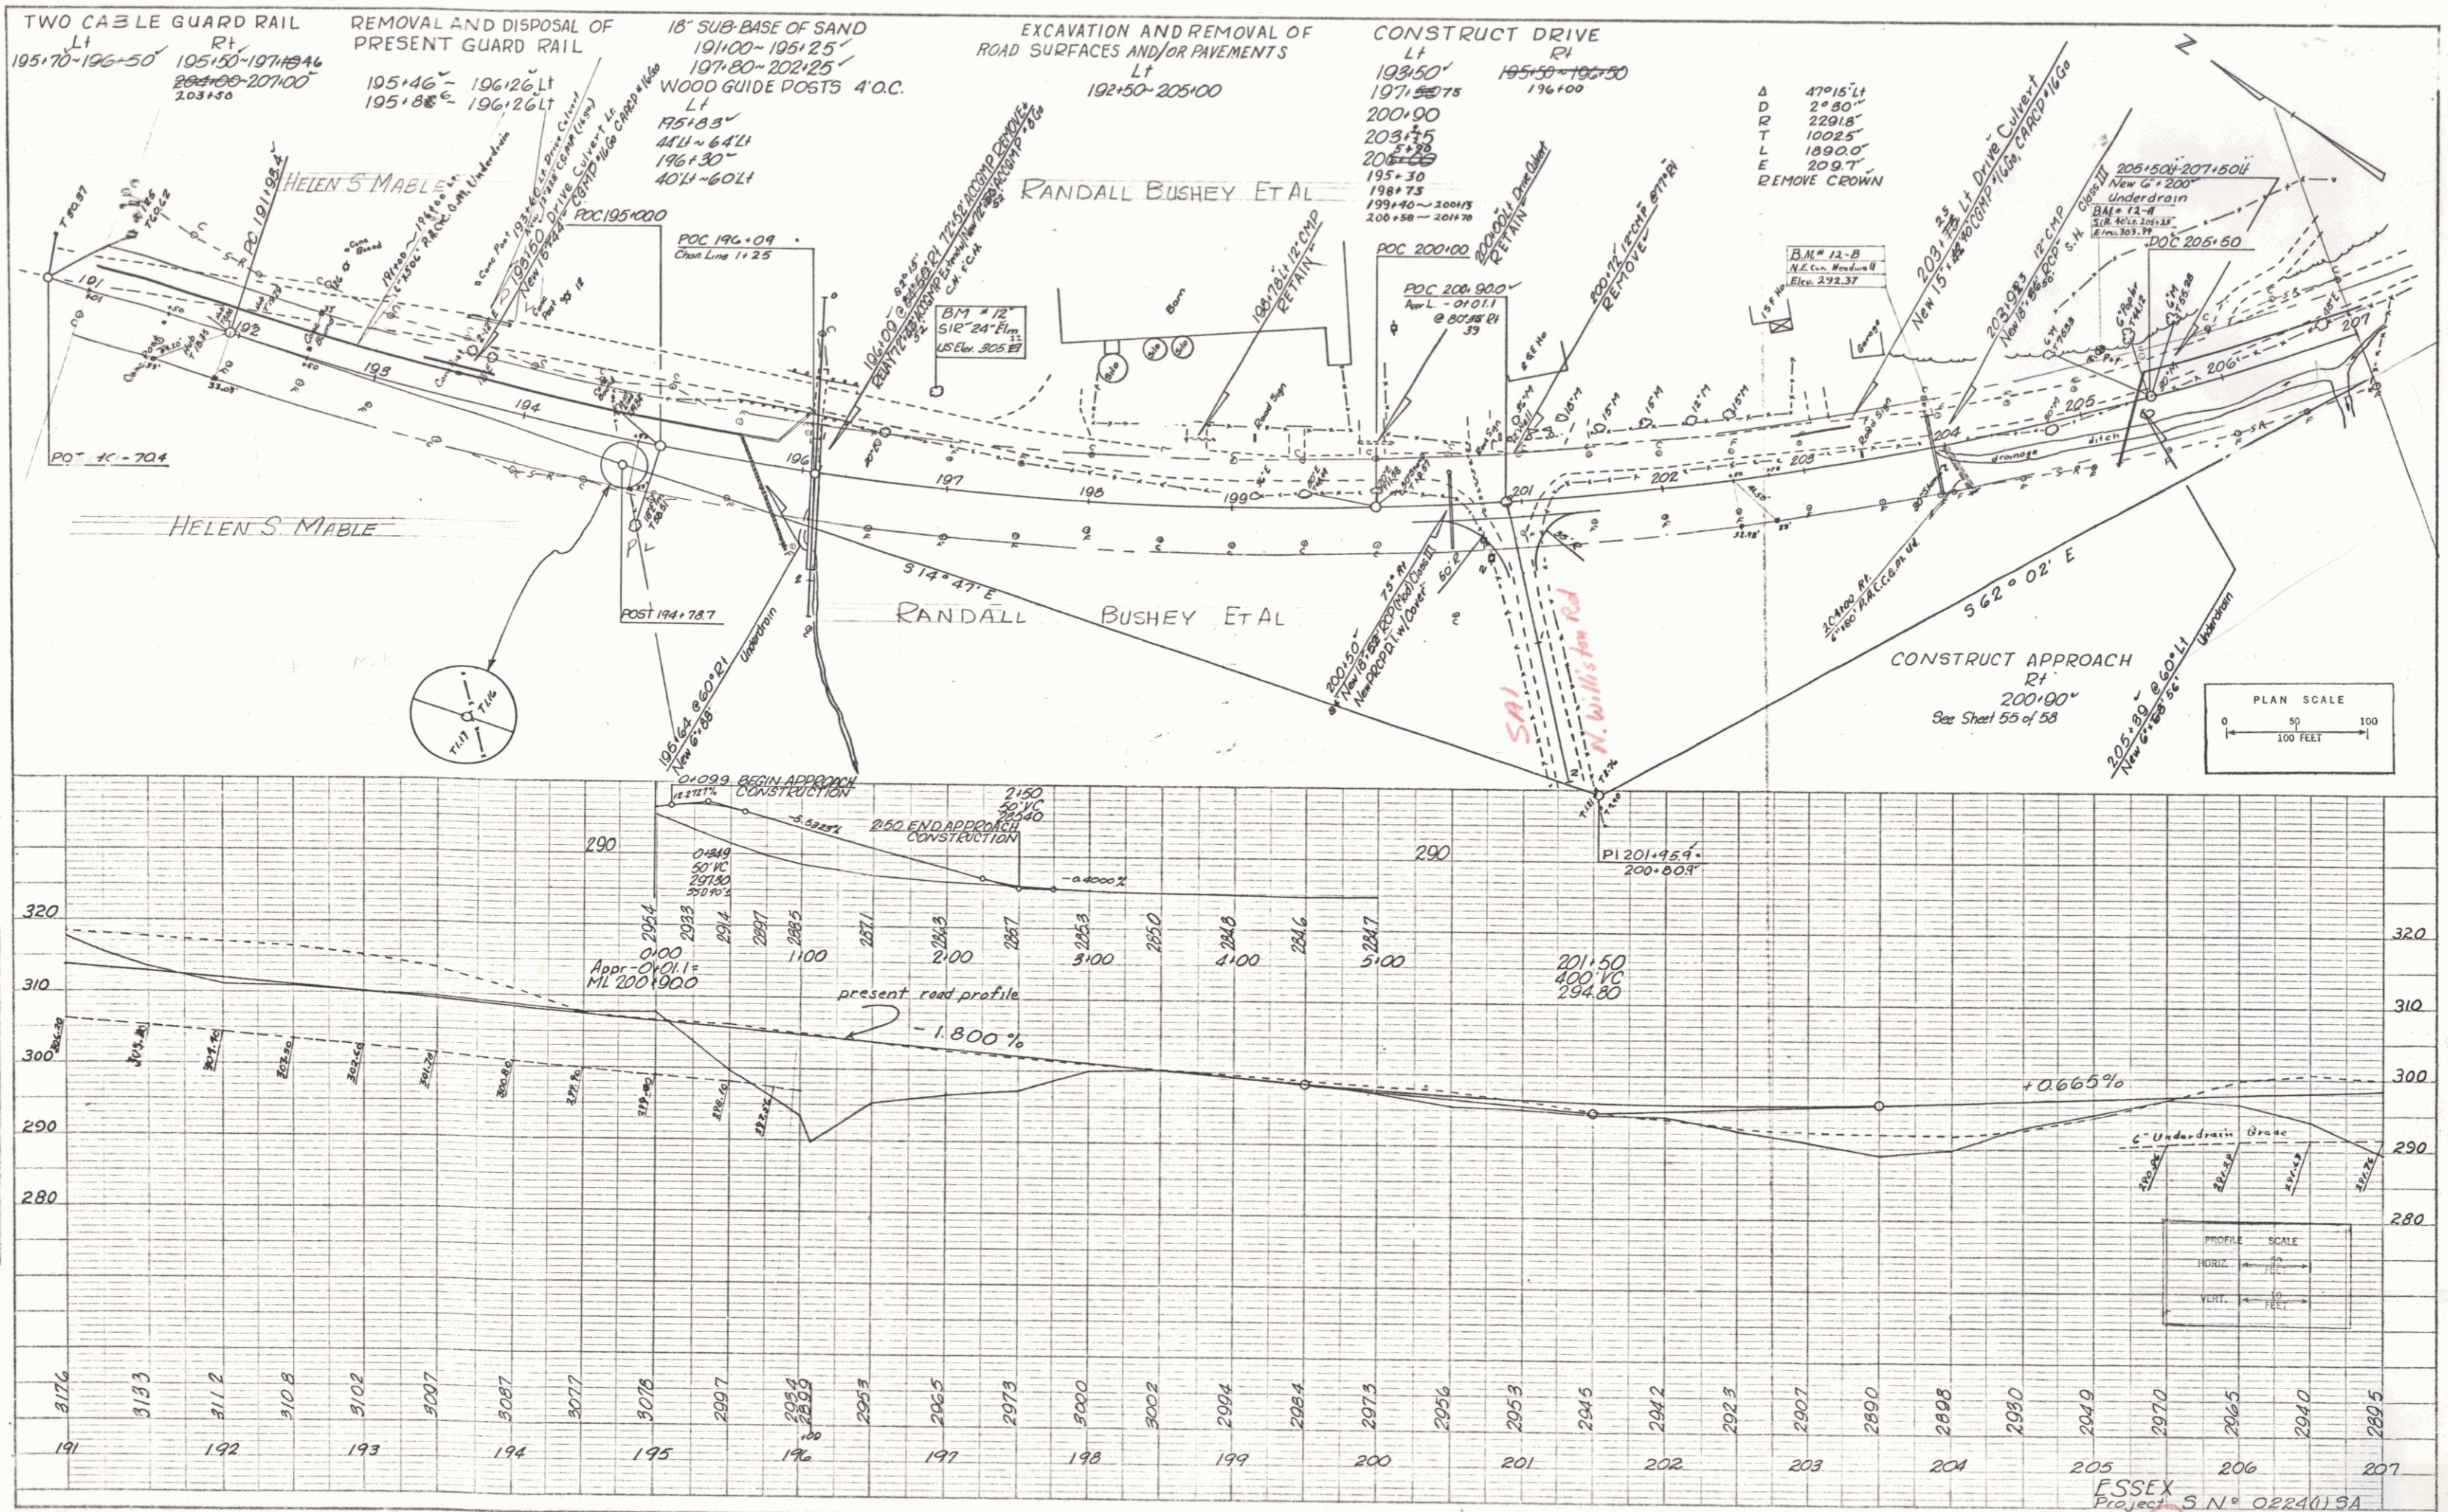



ESSEX
 Project S.N. 0224(1) SA
 Sheet 22 of 58 Sheets