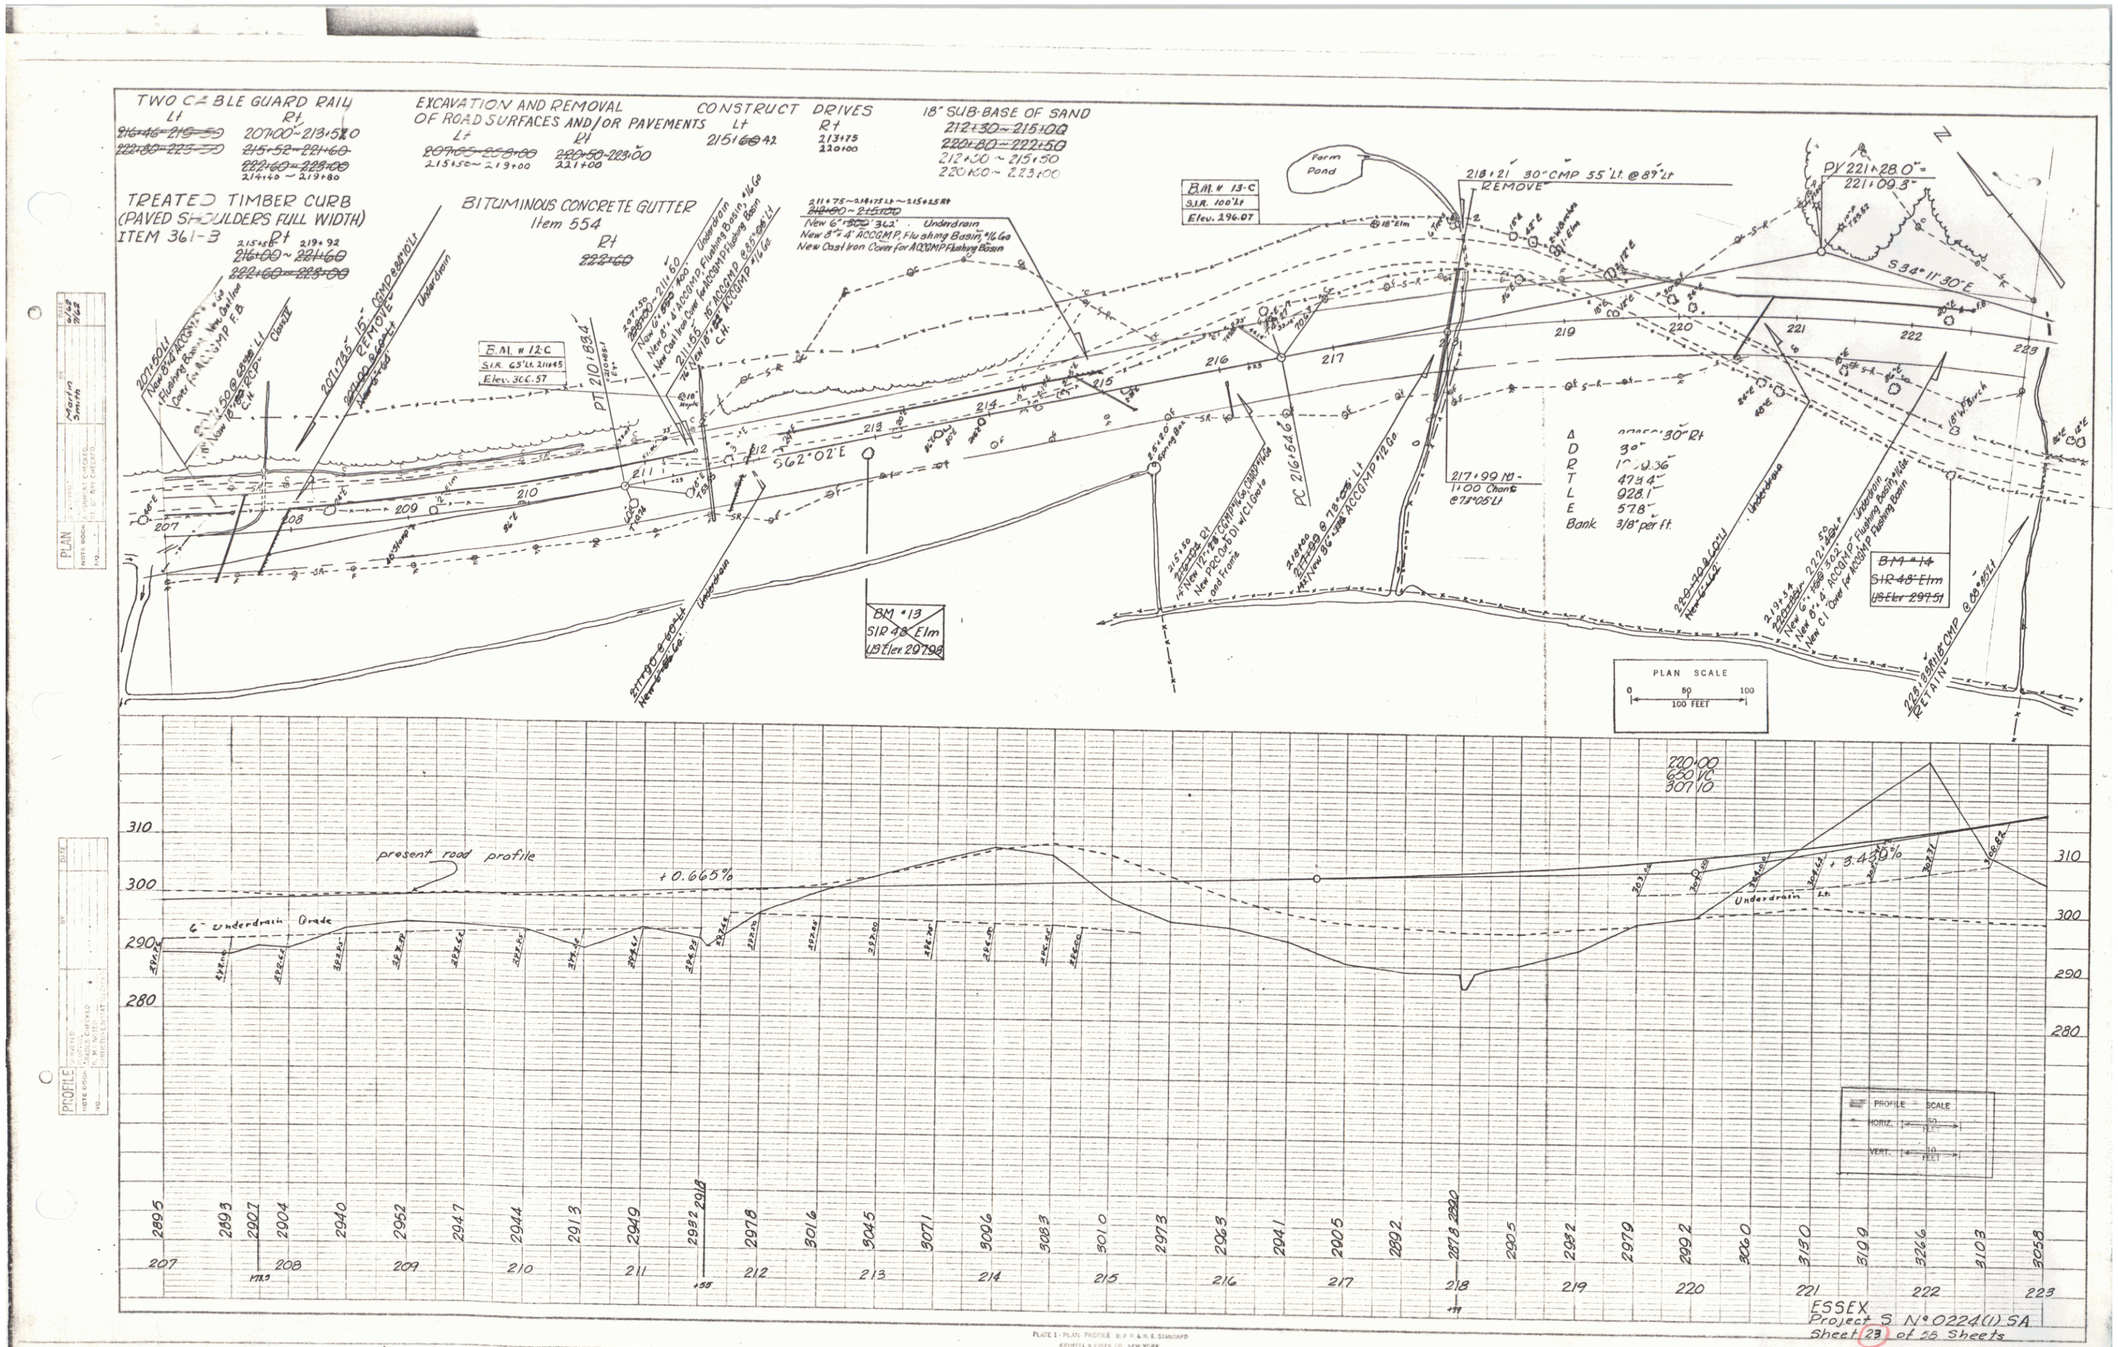

PLATE 1 - PLAN PROFILE D.P.W. & W.E. STANDARD
KEMPITE & FYFER CO. NEW YORK
W & S Co. No. 3-6-12

6