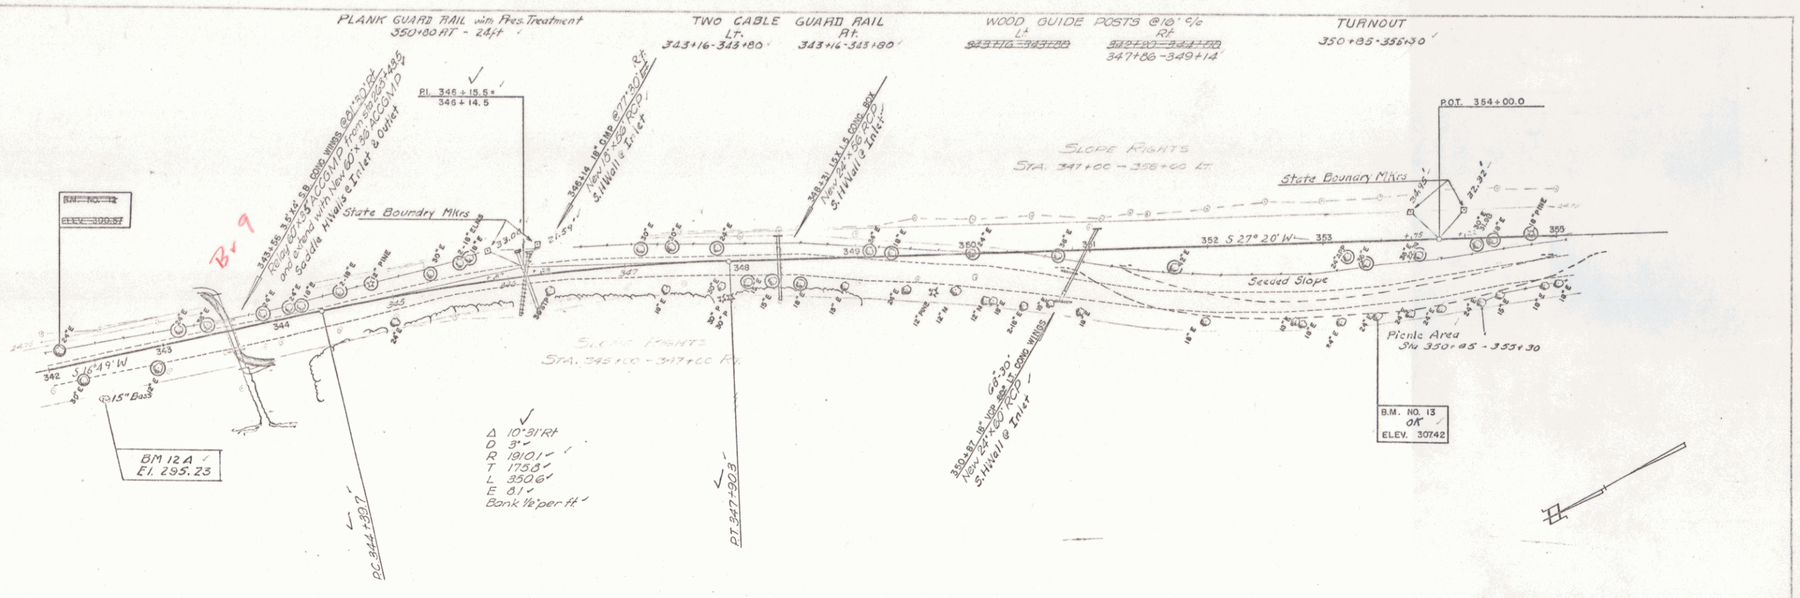

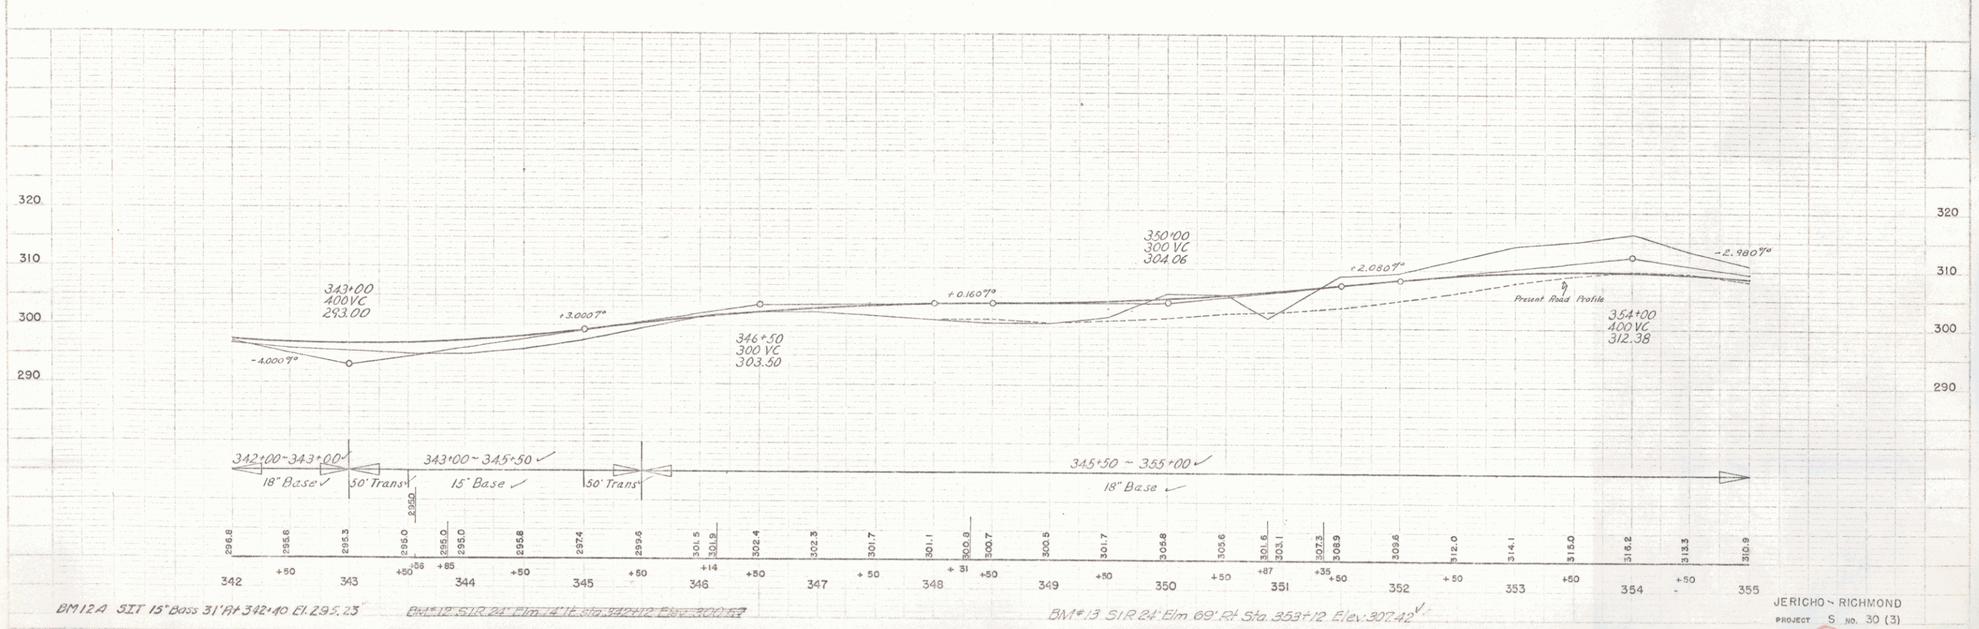

BM 12A SIT 15" Base 31' Rt Sta 342+40 El. 295.23

BM #13 S1R 24" Elm 69' Rt Sta. 353+12 Elev. 307.42

JERICHO ~ RICHMOND
PROJECT S No. 30 (3)
SHEET 18 OF 79

10