


Project PWA # UT 1092-F9
 Town Townshend
 Route Vt 30
 P. in 00R533
 Date 01/01/1929

PWA. 3 47
 PWA 20257 No. 1092-1
 03/1/2025 Bridge

PARCEL INSTRUMENT	DATE	GRANTOR	GRANTEE	RECORDED	REMARKS
B.B.	V.O.	4-11-39	LEVI JENISON	TOWNSHEND	
A	W.O.	4-26-39	H.C. SPATTON & H. BURNAP	ST. OF VT. 31	1 CONVEY 1 CONVEY

Clearing and grubbing is to be paid for under the contract and their clearing and grubbing item 13 for that section on Line A within the limits as ordered by the Engineer. The pay item for clearing and grubbing, item 13, to apply only to such locations as shown on the plans ordered by the Engineer. The item of tree removal, item 109, is modified to apply only to those areas not included in the clearing and grubbing pay item. Horizontal measurements to be used in computing area for payment.

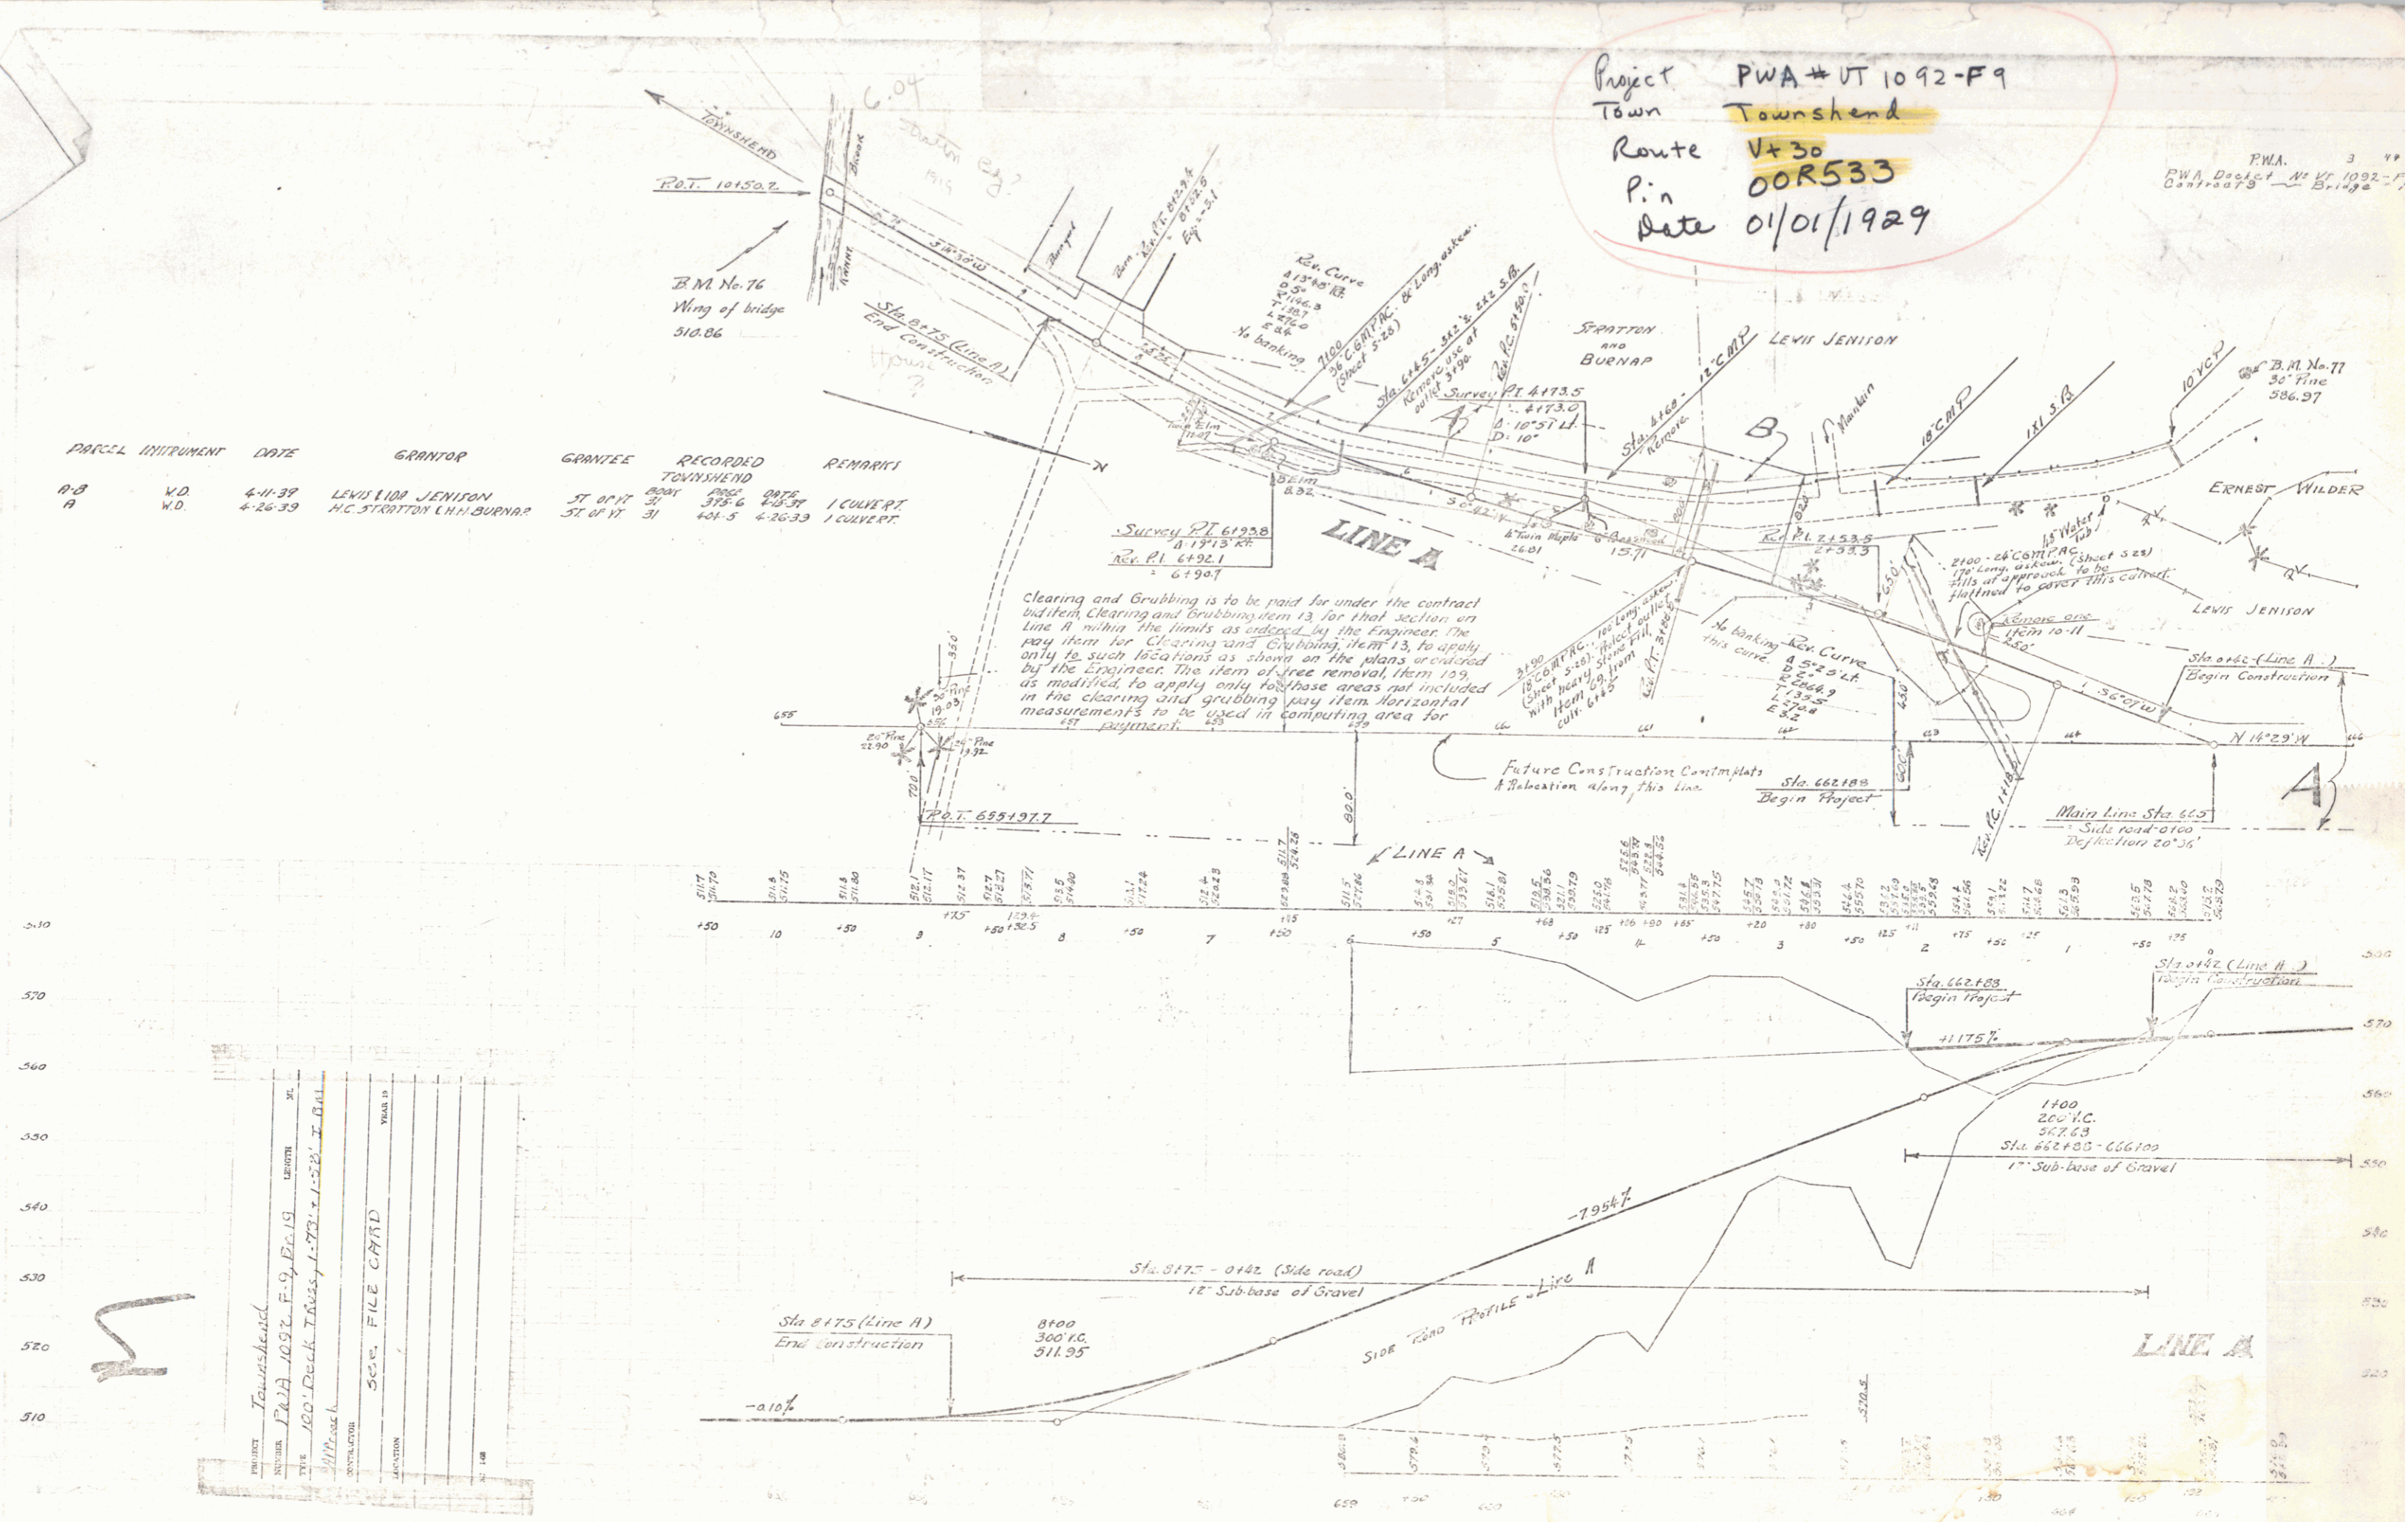


PROJECT	Townshend
NUMBER	PWA 1092-F-9, P. 19
DATE	100 Deck Truss, 1-22, 1-22, 1-22
SCALE	1" = 40'
DATE	
BY	
CHECKED	
APPROVED	
DATE	


