POOR ORIGINAL COPY
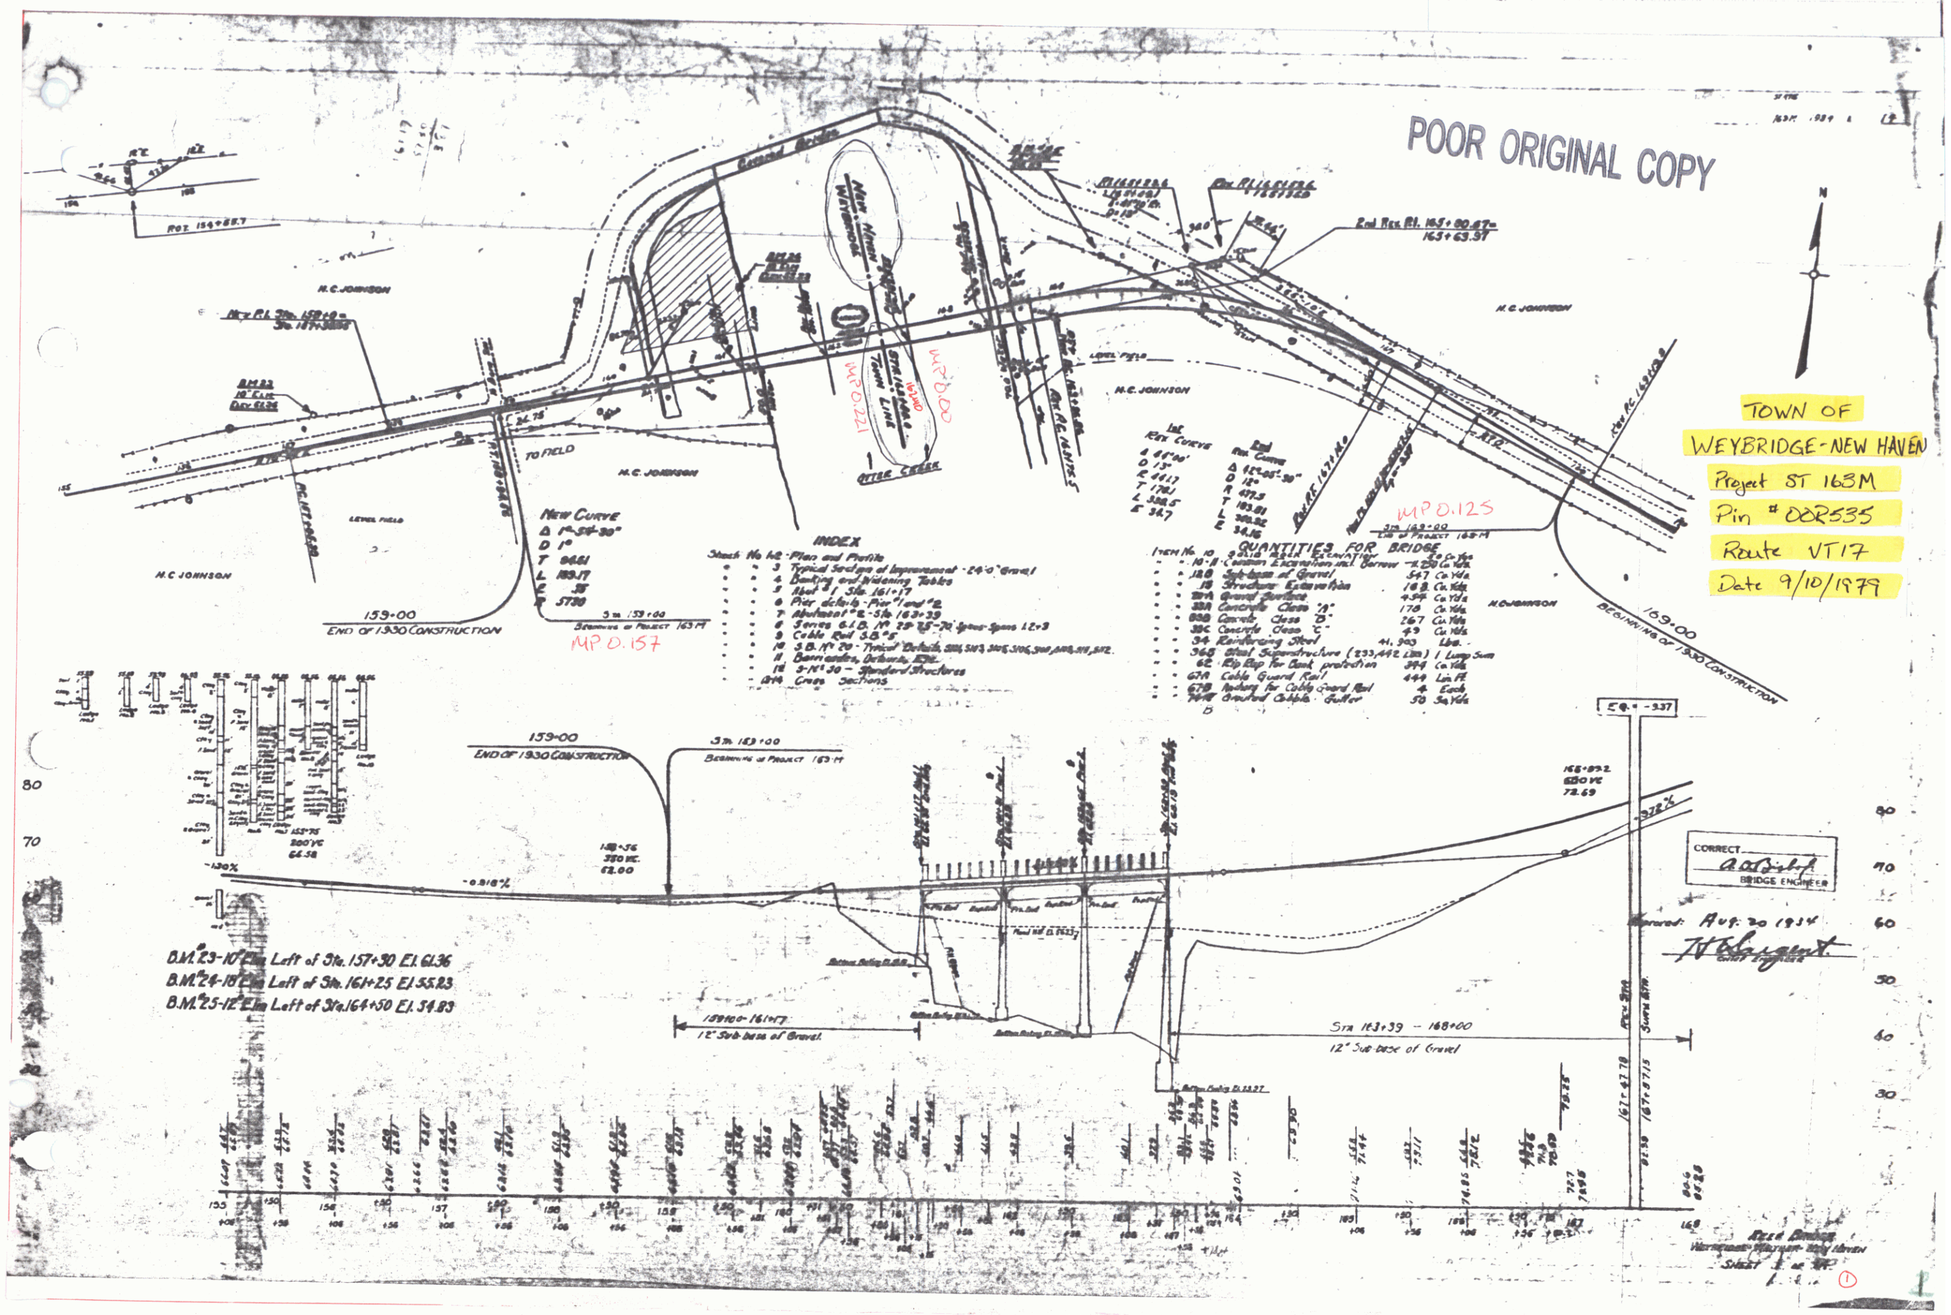
TOWN OF
WEYBRIDGE-NEW HAVEN
Project ST 163M
Pin # DOR535
Route VT17
Date 9/10/1979