



PLATE NO. 16
 SHEET 16 OF 50





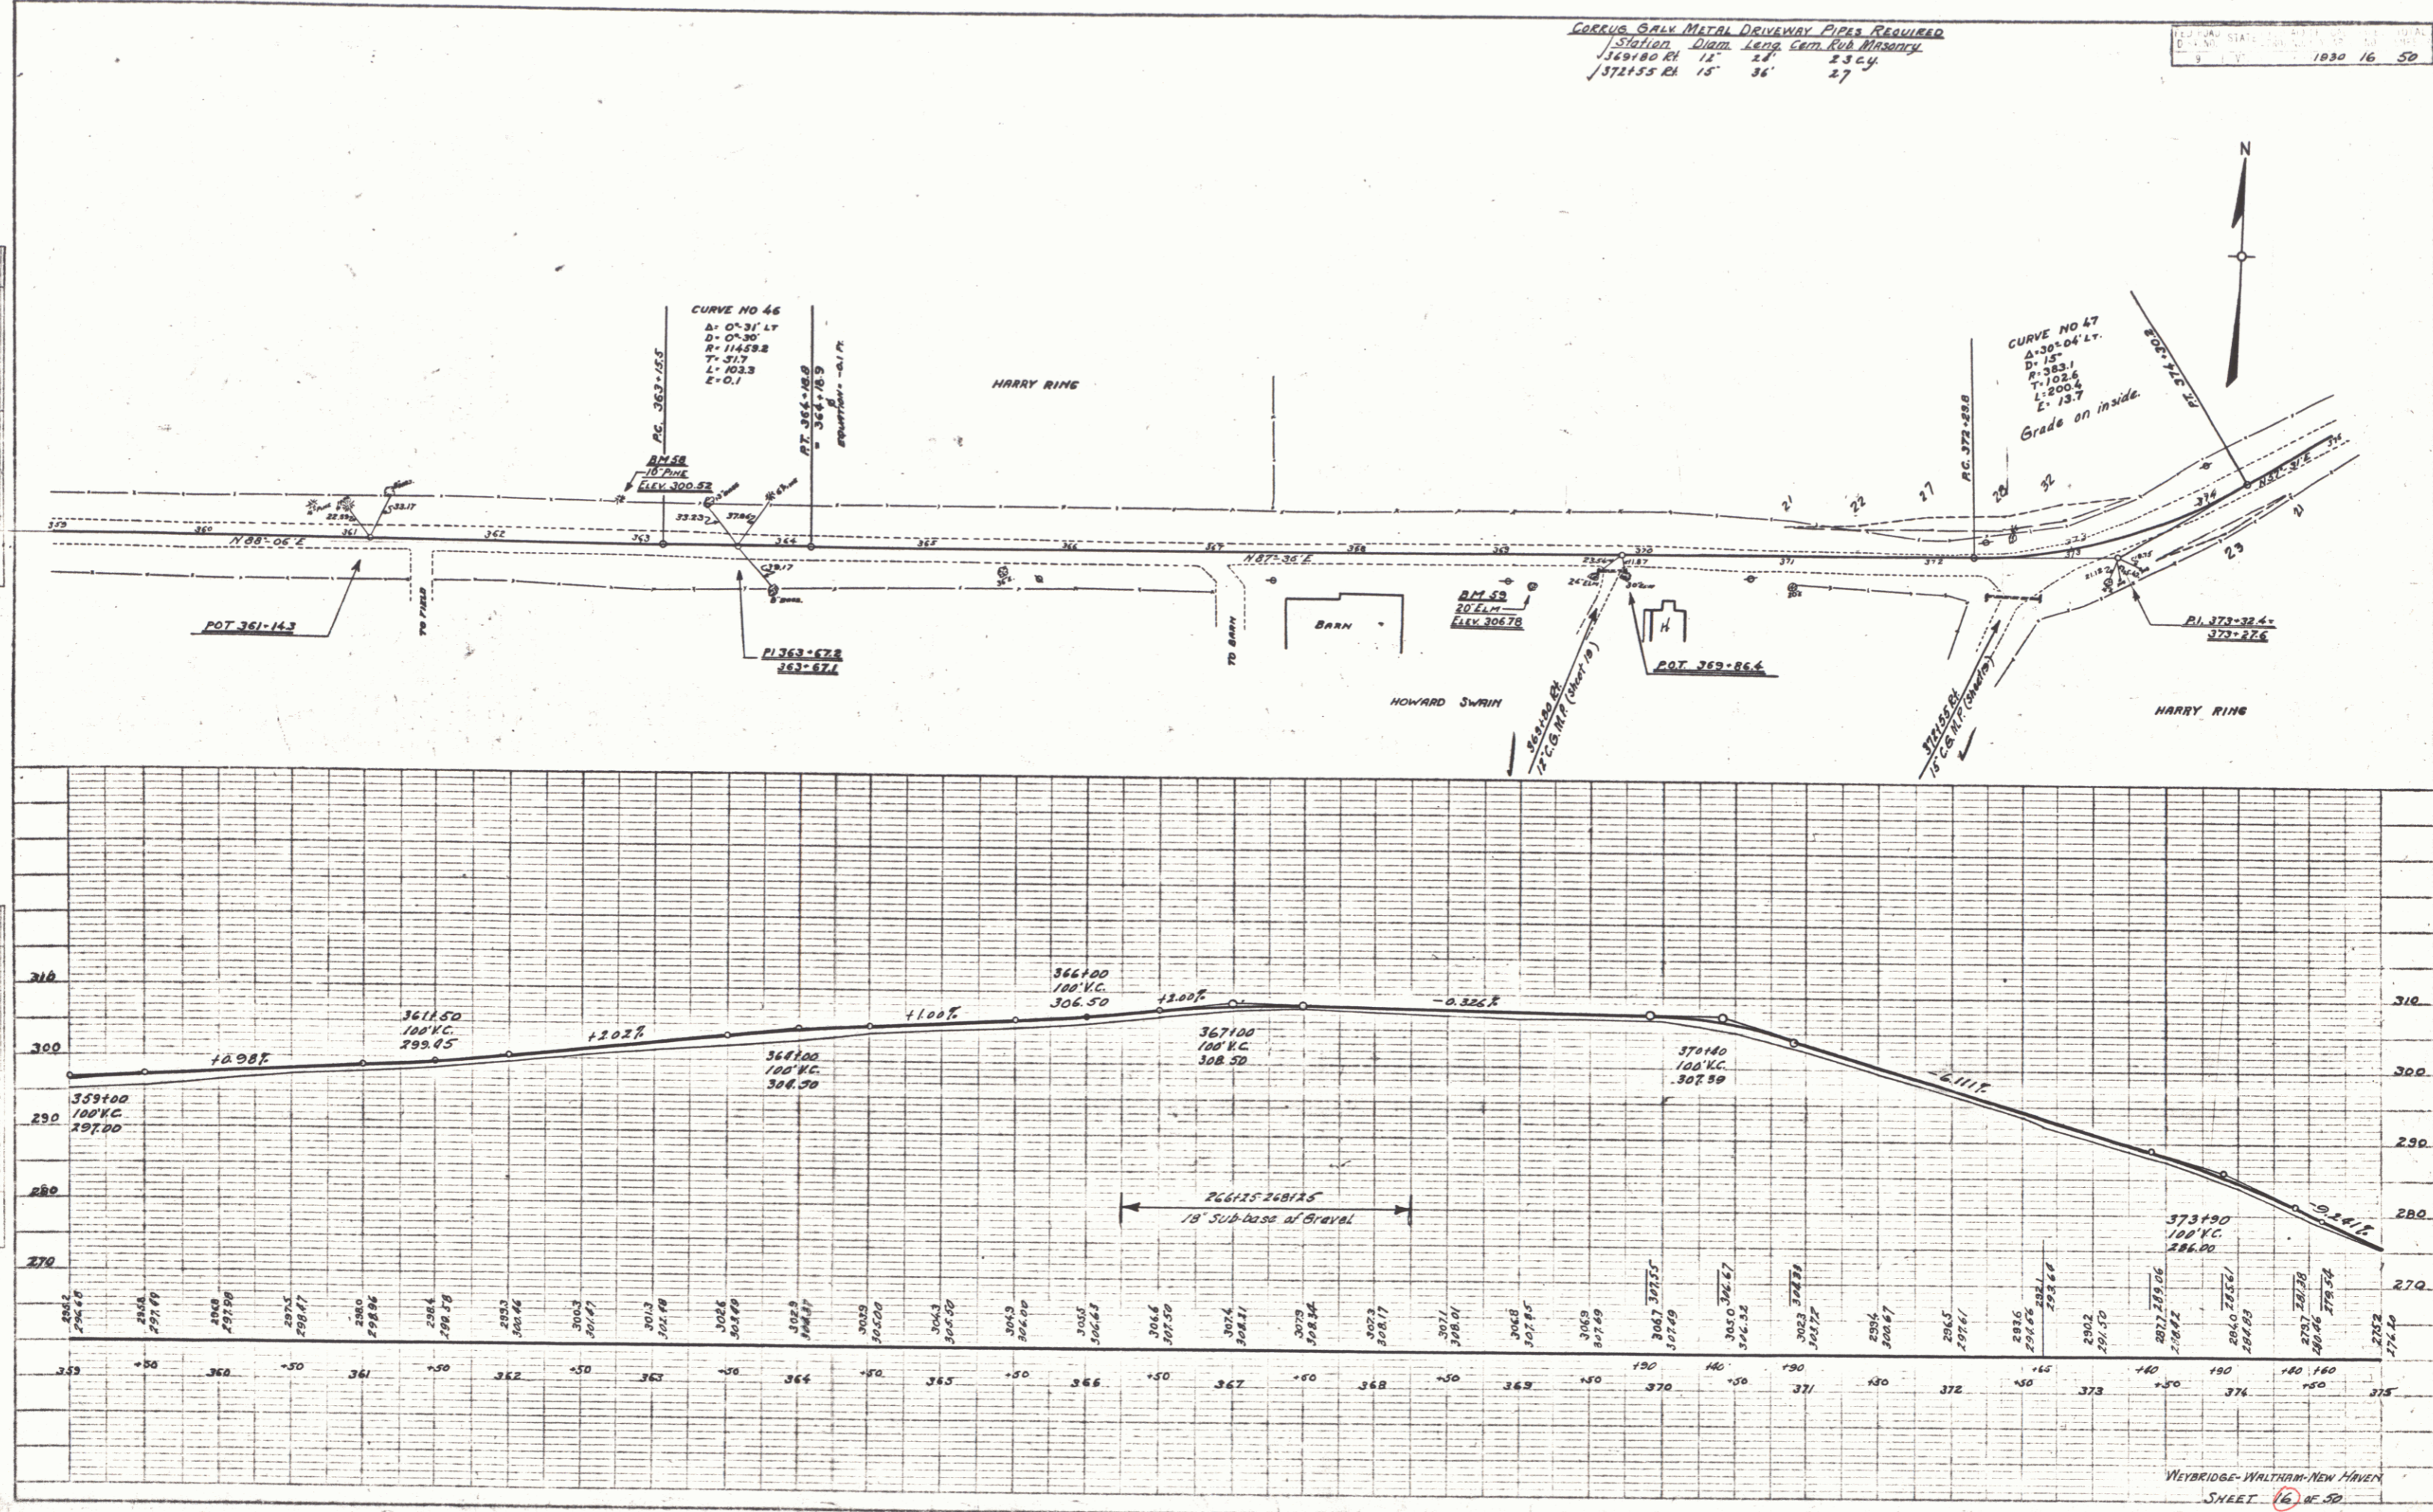

WYBRIDGE-WALTHAM-NEW HAVEN
 SHEET 16 OF 50