TREATED TIMBER CURB
17+76 ~ 22+02 LT.

UNCLASSIFIED CHANNEL EXCAVATION
18+0 LT. - 20+47 LT.
21+74 LT. - 23+44 LT.
27+70.5 LT. - 29+50 LT.

TWO CABLE GUARD RAIL (Mod.)
17+75 84 - 29+75 92 LT.
21+80 4 - 22+0 40 RT.

CONSTRUCT DRIVE
21+50 1/2 RT. ~ 22+05 RT
17+00 RT

DRILLING AND BLASTING OF SOLID ROCK SUBGRADE
26+75 - 28+75 65

PARCEL	2 STA. 16+38 - 22+03
GRANTOR	JOHN A. JR. & ELIZABETH HIZE
TAKING	0.2 A. REM.
RIGHTS, CHANNEL	18+00 - 20+50 LT.
DRAINAGE	19+09 LT., 21+34 LT., 15+50 LT.
TITLE TAKEN	
RECORDED	BK. PG. DT.

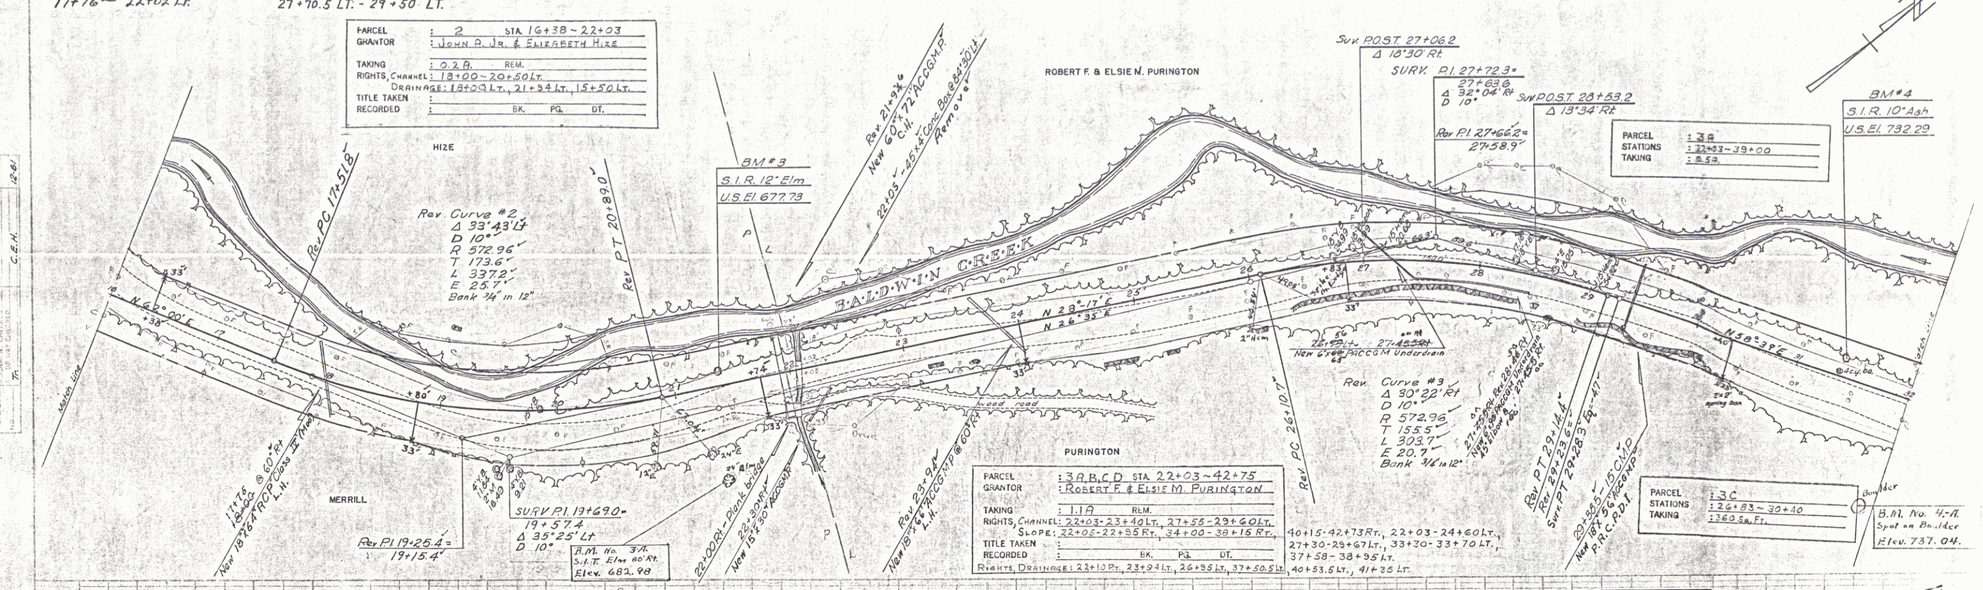

PARCEL	3 A B C D STA. 22+03 - 42+75
GRANTOR	ROBERT F. & ELSIE M. PURINGTON
TAKING	1.1 A REM.
RIGHTS, CHANNEL	22+03 - 23+40 LT., 27+55 - 29+60 LT.
SLOPE	22+06 - 22+95 RT., 34+00 - 38+15 RT., 40+15 - 42+73 RT., 22+03 - 24+60 LT., 27+30 - 29+67 LT., 33+20 - 33+70 LT., 37+58 - 38+95 LT., 40+53.5 LT., 41+35 LT.
TITLE TAKEN	
RECORDED	BK. PG. DT.
RIGHTS, DRAINAGE	22+10 RT., 23+94 LT., 26+95 LT., 37+50.5 LT.

PARCEL	3 B
STATIONS	22+05 - 24+00
TAKING	1160 SQ. FT.

PARCEL	3 A
STATIONS	22+43 - 39+00
TAKING	0.53

PARCEL	3 C
STATIONS	36+83 - 39+40
TAKING	360 SQ. FT.

BRISTOL - STARKSBORO
Project S.N.H. 0200(1) SA
Sheet 39 of 75

3