



6' SHOULDER TWO CABLE GUARD RAIL (Mod)
 LT RT LT RT
 63+29-64+89 64+15-65+55.5 63+29-64+89 64+15-65+55.5
 4' SHOULDER
 LT RT
 65+39-65+55.5 63+55-63+65

64+50+LT-66+75+LT
 DIVERT EXISTING WATER COURSE INTO OLD WATER COURSE LOCATED APPROXIMATELY 110' TO 120' LEFT OF STA. 66+75= NECESSARY EXCAVATION TO BE PAID FOR UNDER THE ITEM OF UNCLASSIFIED CHANNEL EXCAVATION, ITEM 106-C

UNCLASSIFIED CHANNEL EXCAVATION
 67+59 RT-70+63.3 RT.
 72+00 RT-75+75 RT.

STONE FILL FOR SLOPE PROTECTION
 RT
 65+25-65+75'
 67+35-70+75'
 71-25-75+75'

PLAN
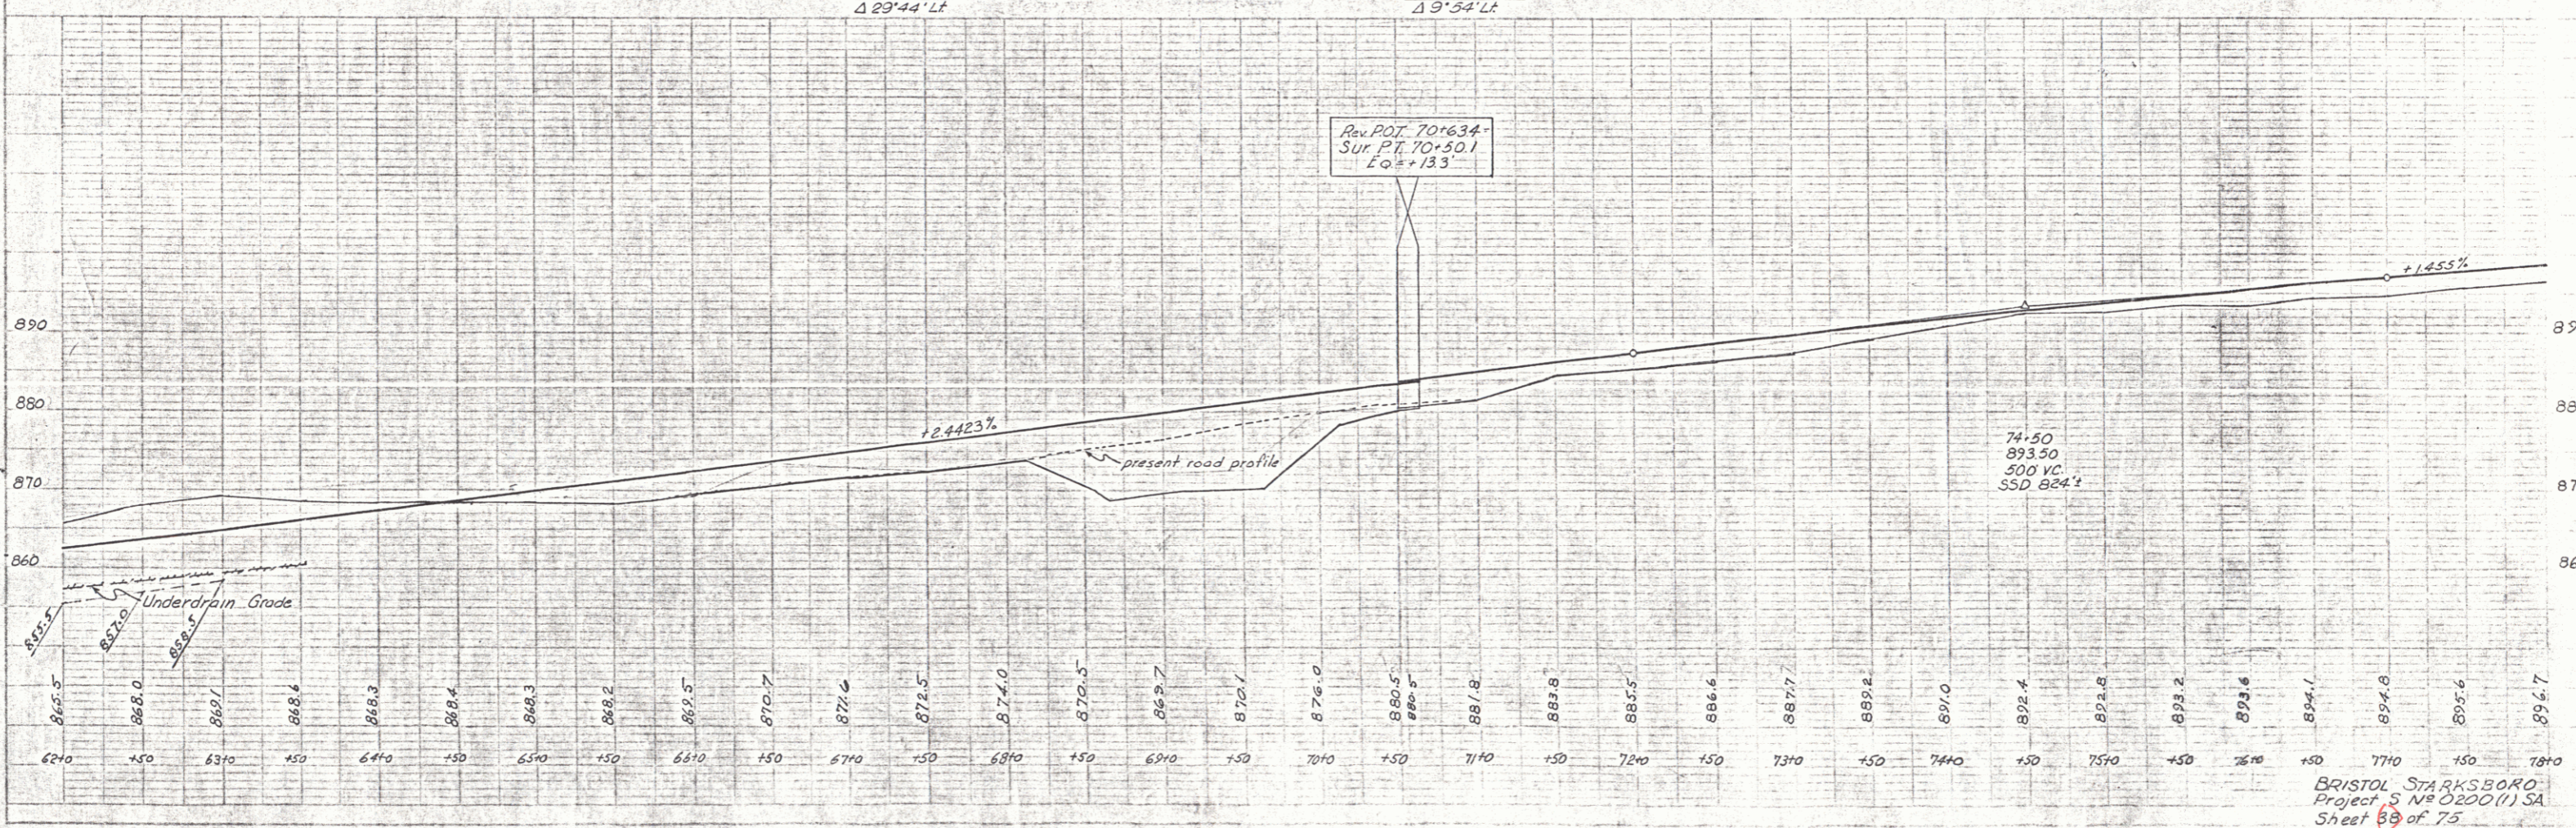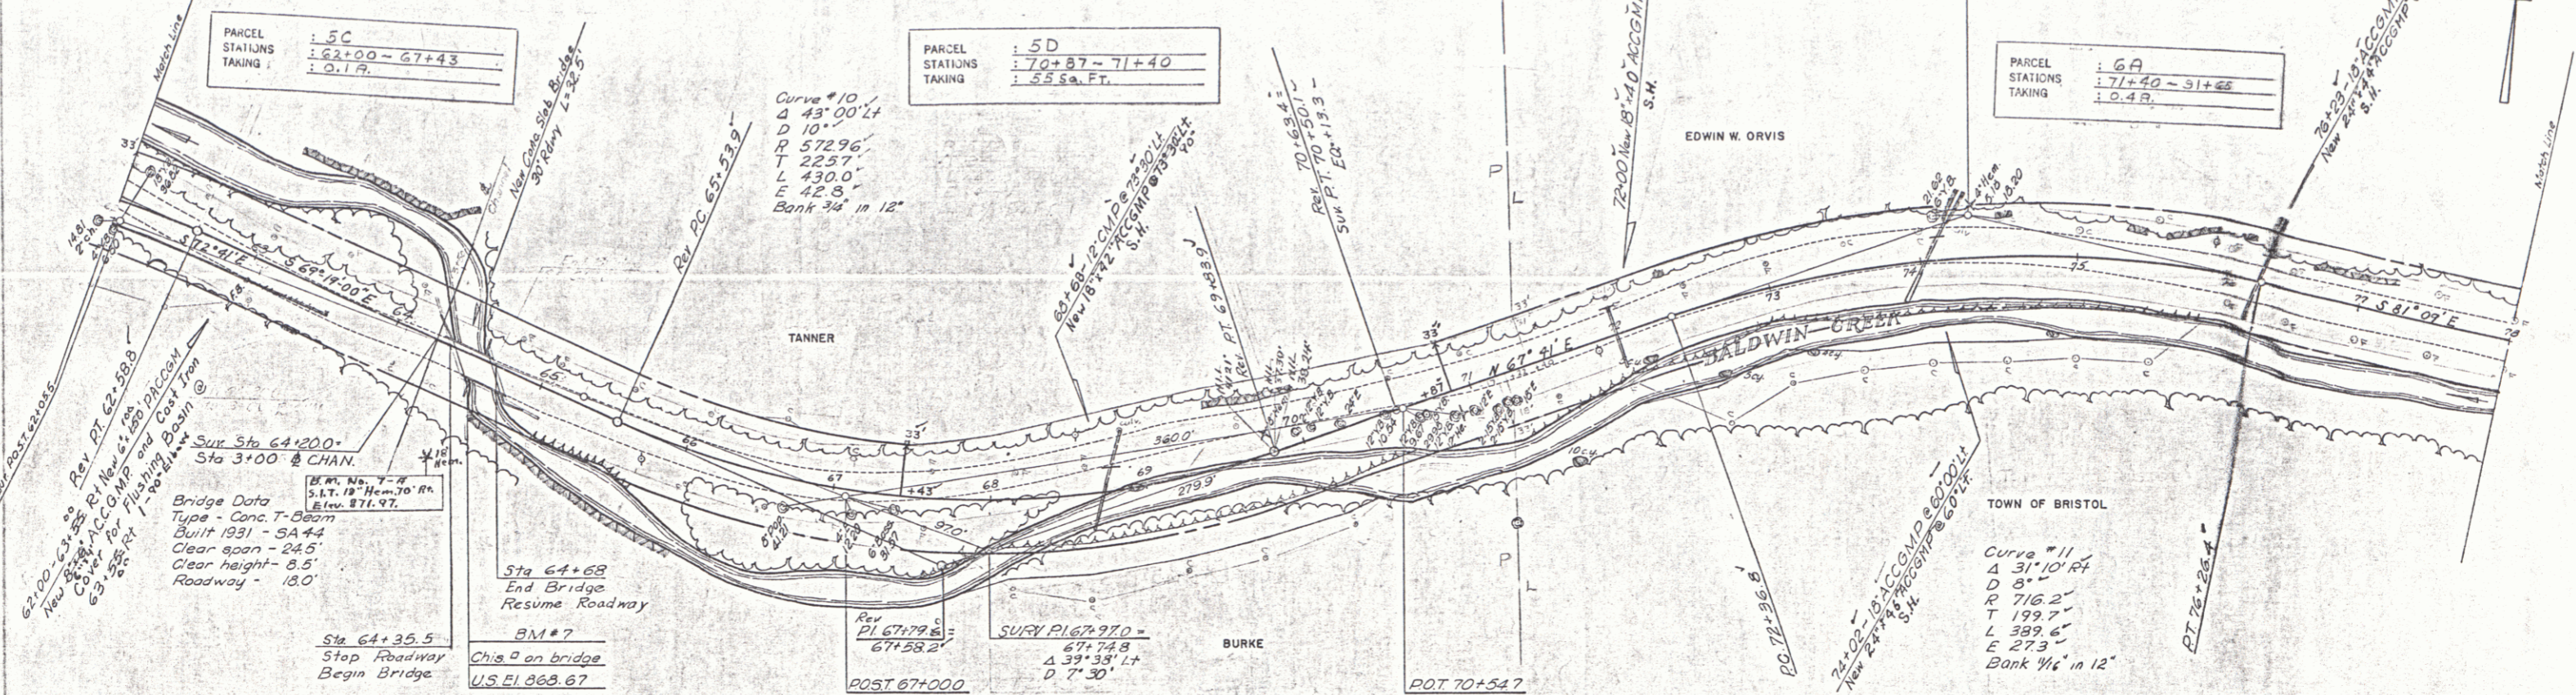

BRISTOL STARKSBORO
 Project S N 0200 (1) SA

6