




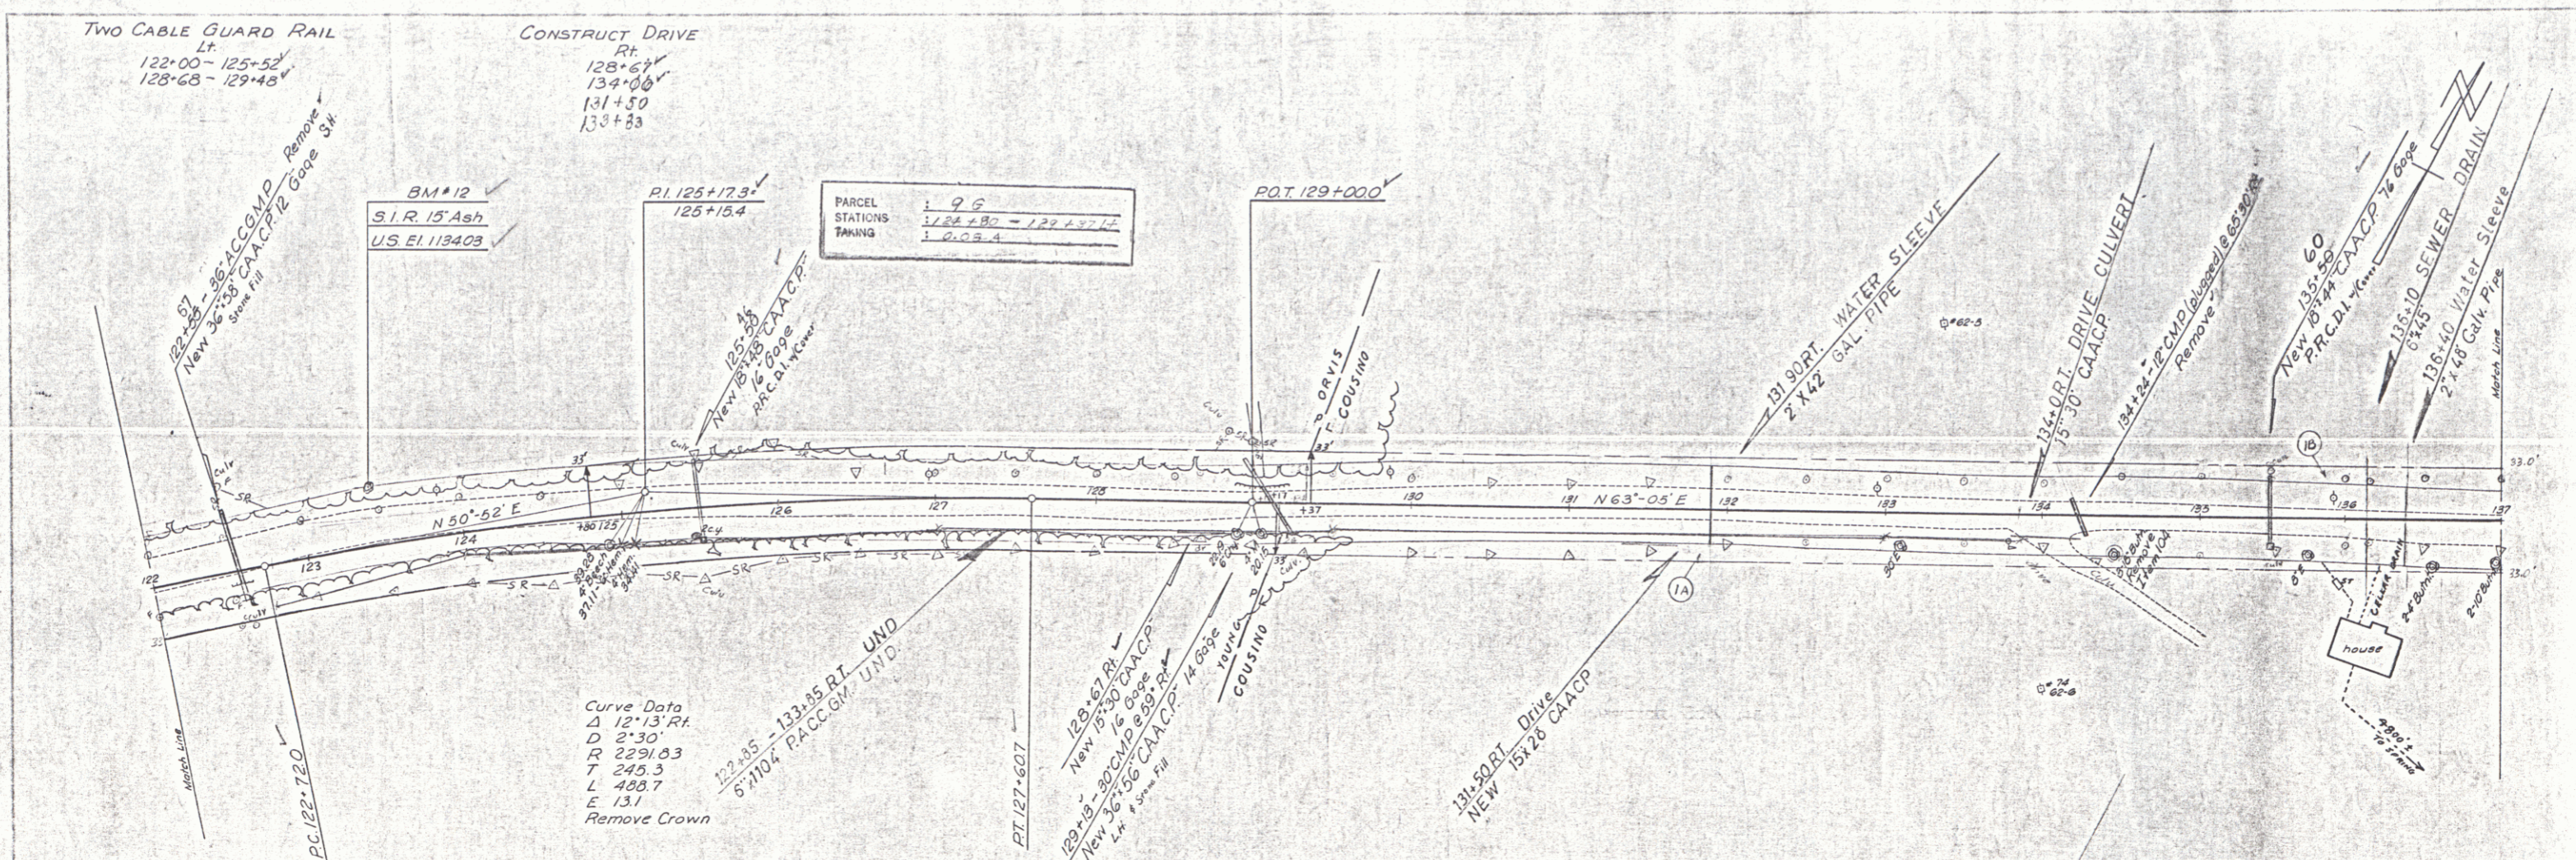


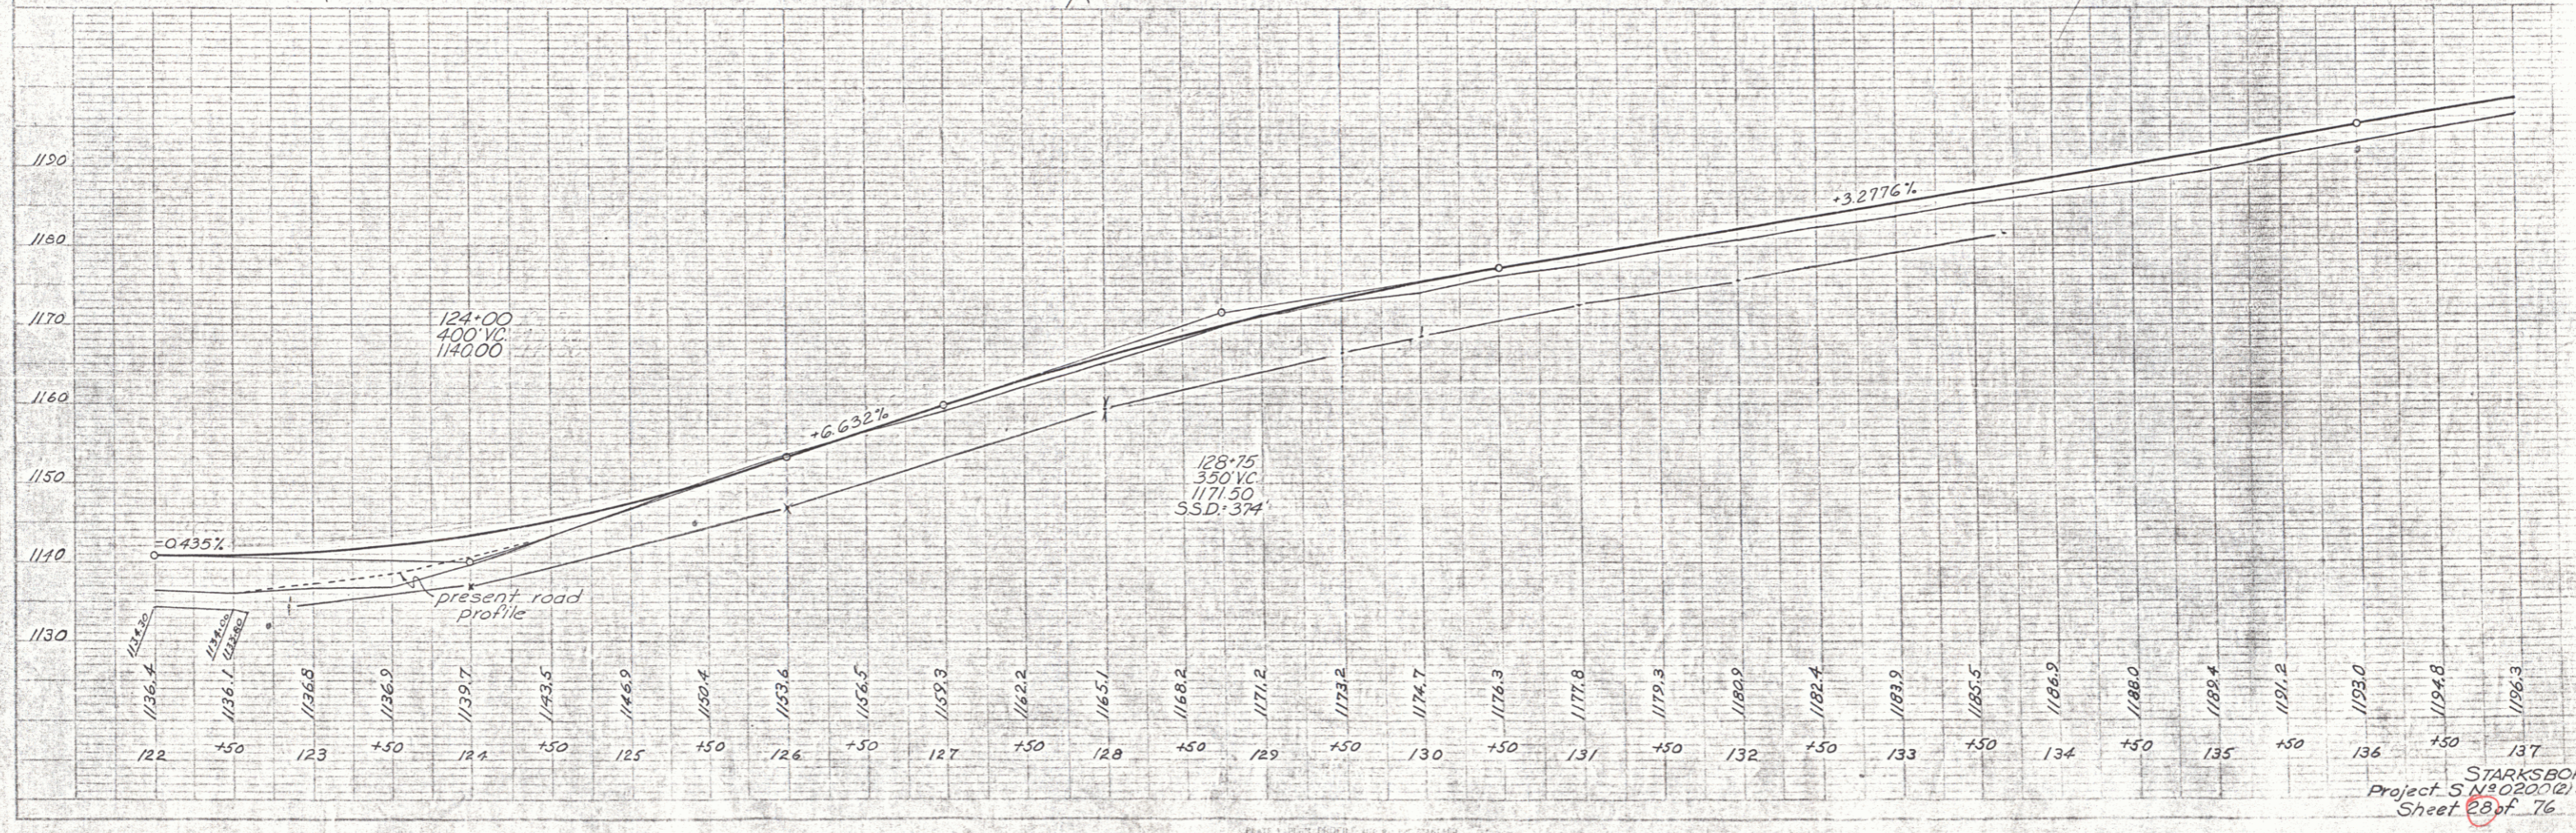

STARKSBORO
