


6-63
 5-63
 7-63
 Traced by: SJA
 P.L.H.

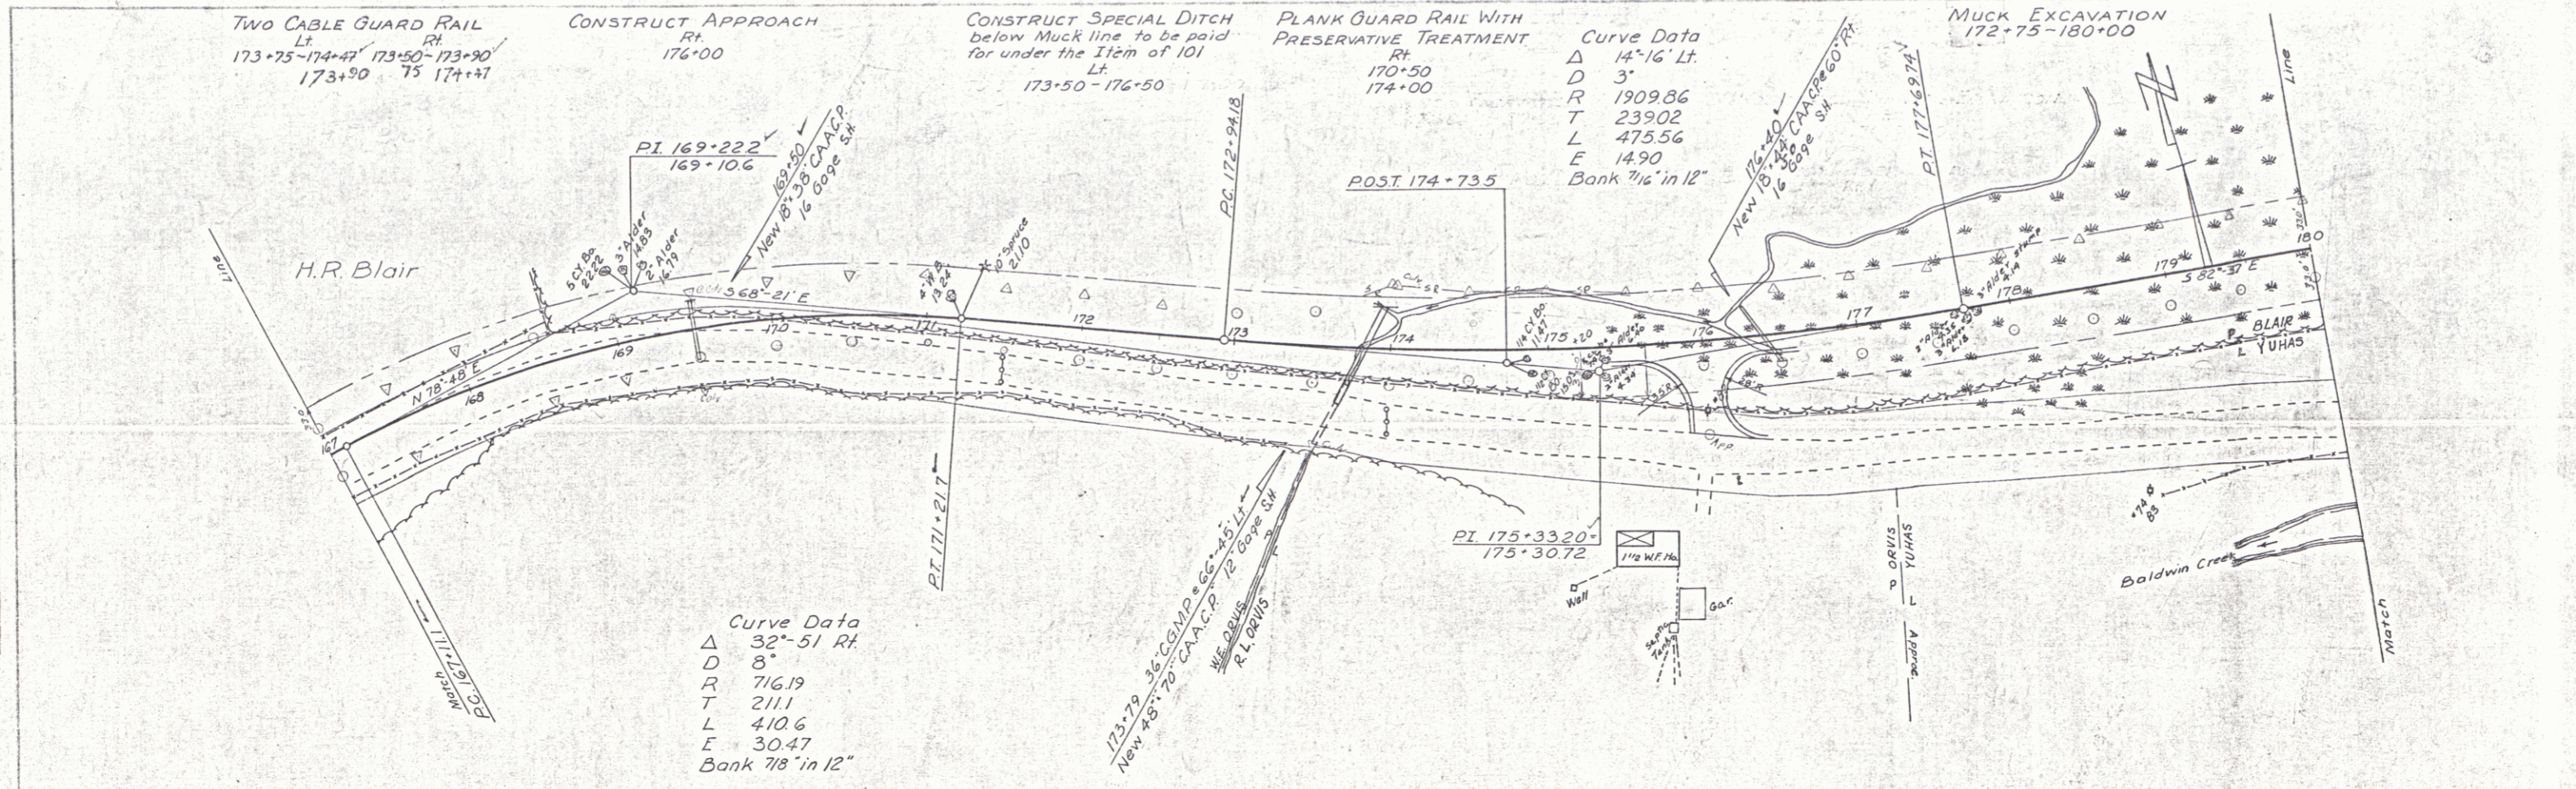

6-63
 5-63
 7-63
 PROFILE
 P.L.H.

