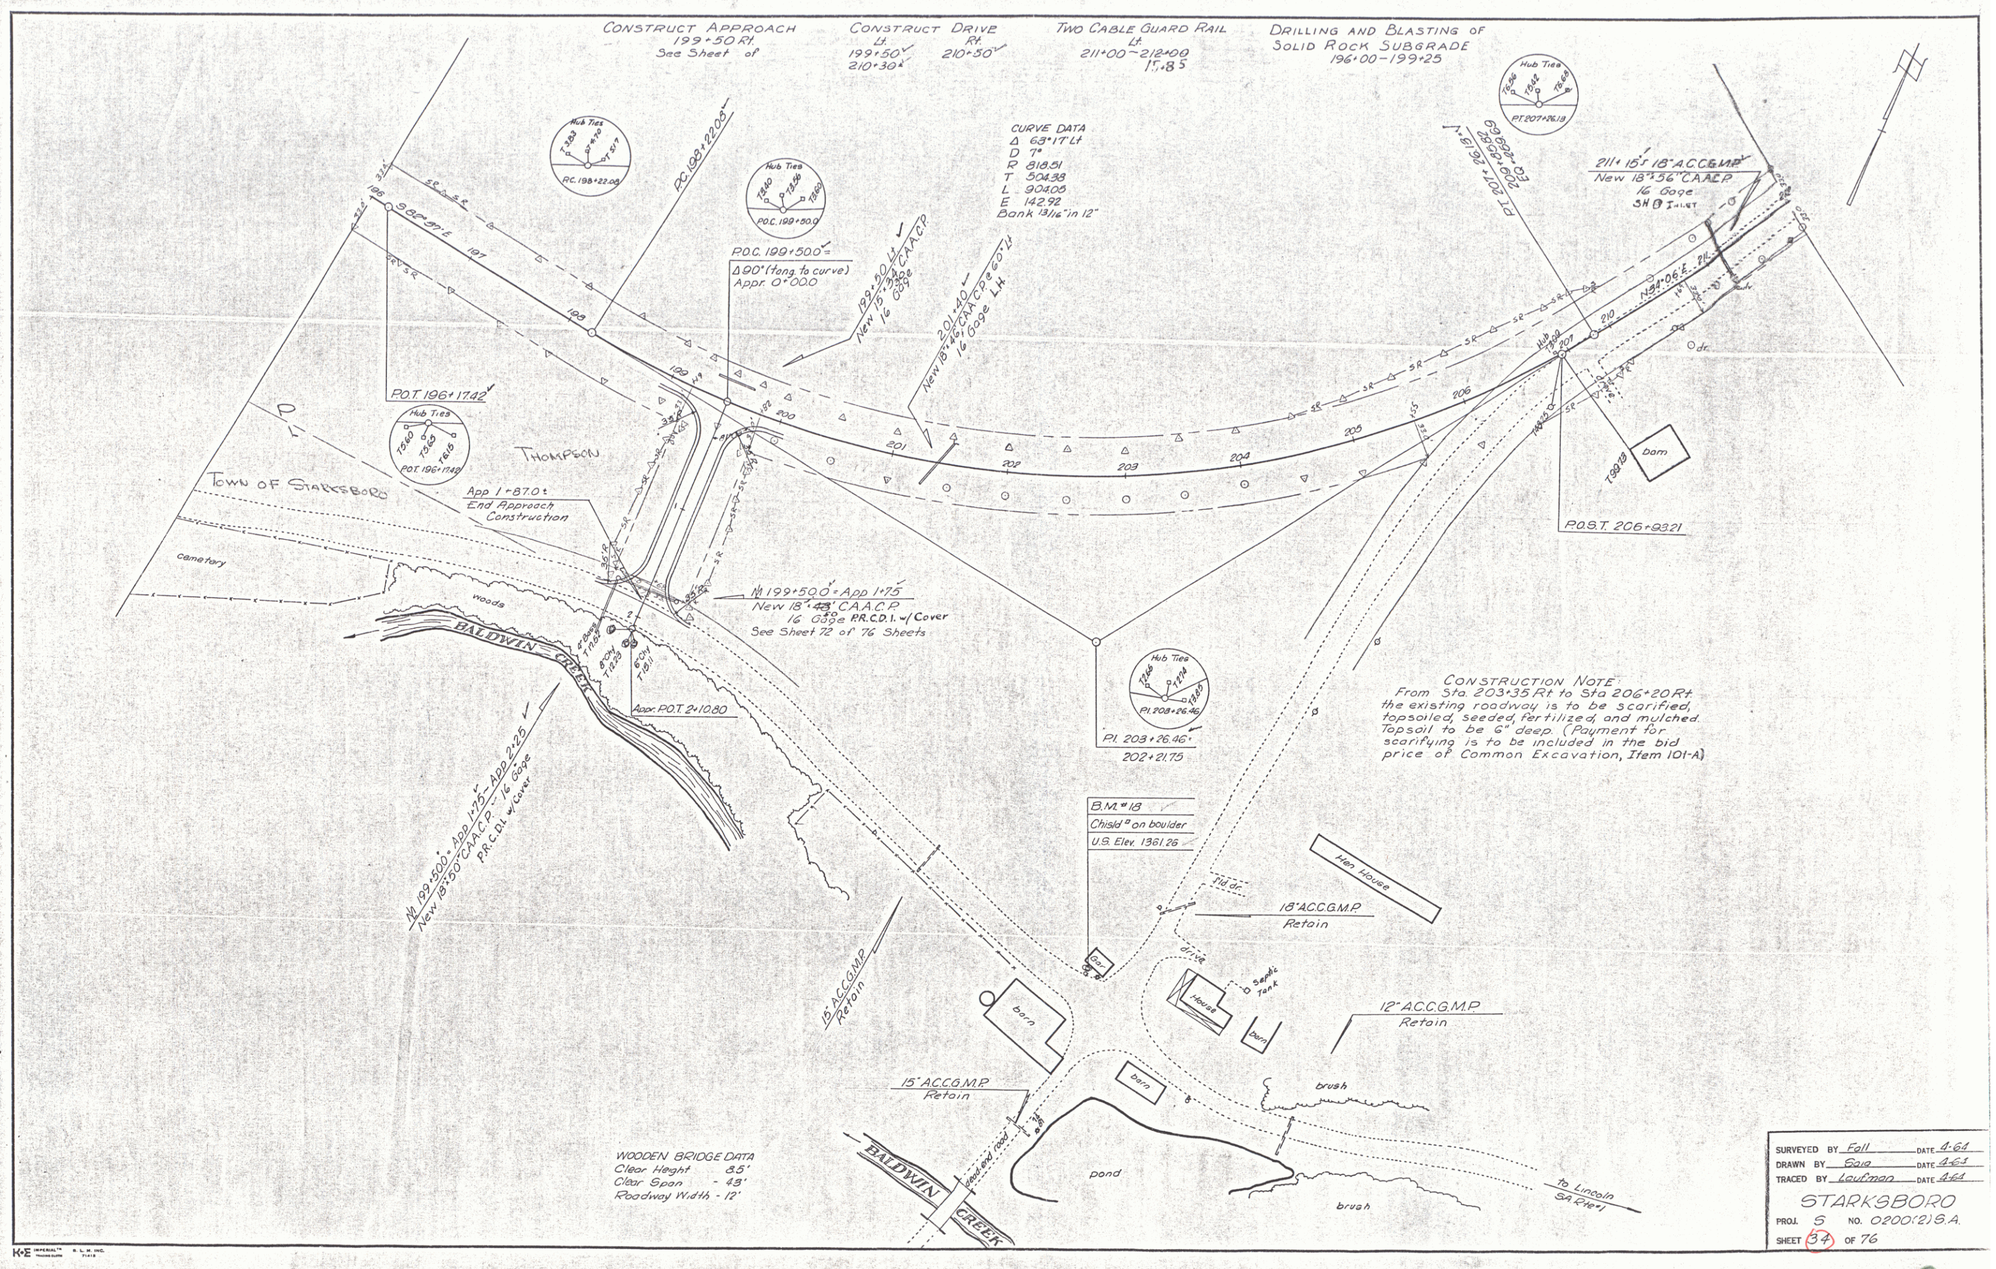


SURVEYED BY Fall DATE 4-64
DRAWN BY Gair DATE 4-64
TRACED BY Lautman DATE 4-64

STARKSBORO

PROJ. S NO. 0200(2) S.A.

SHEET 34 OF 76

8