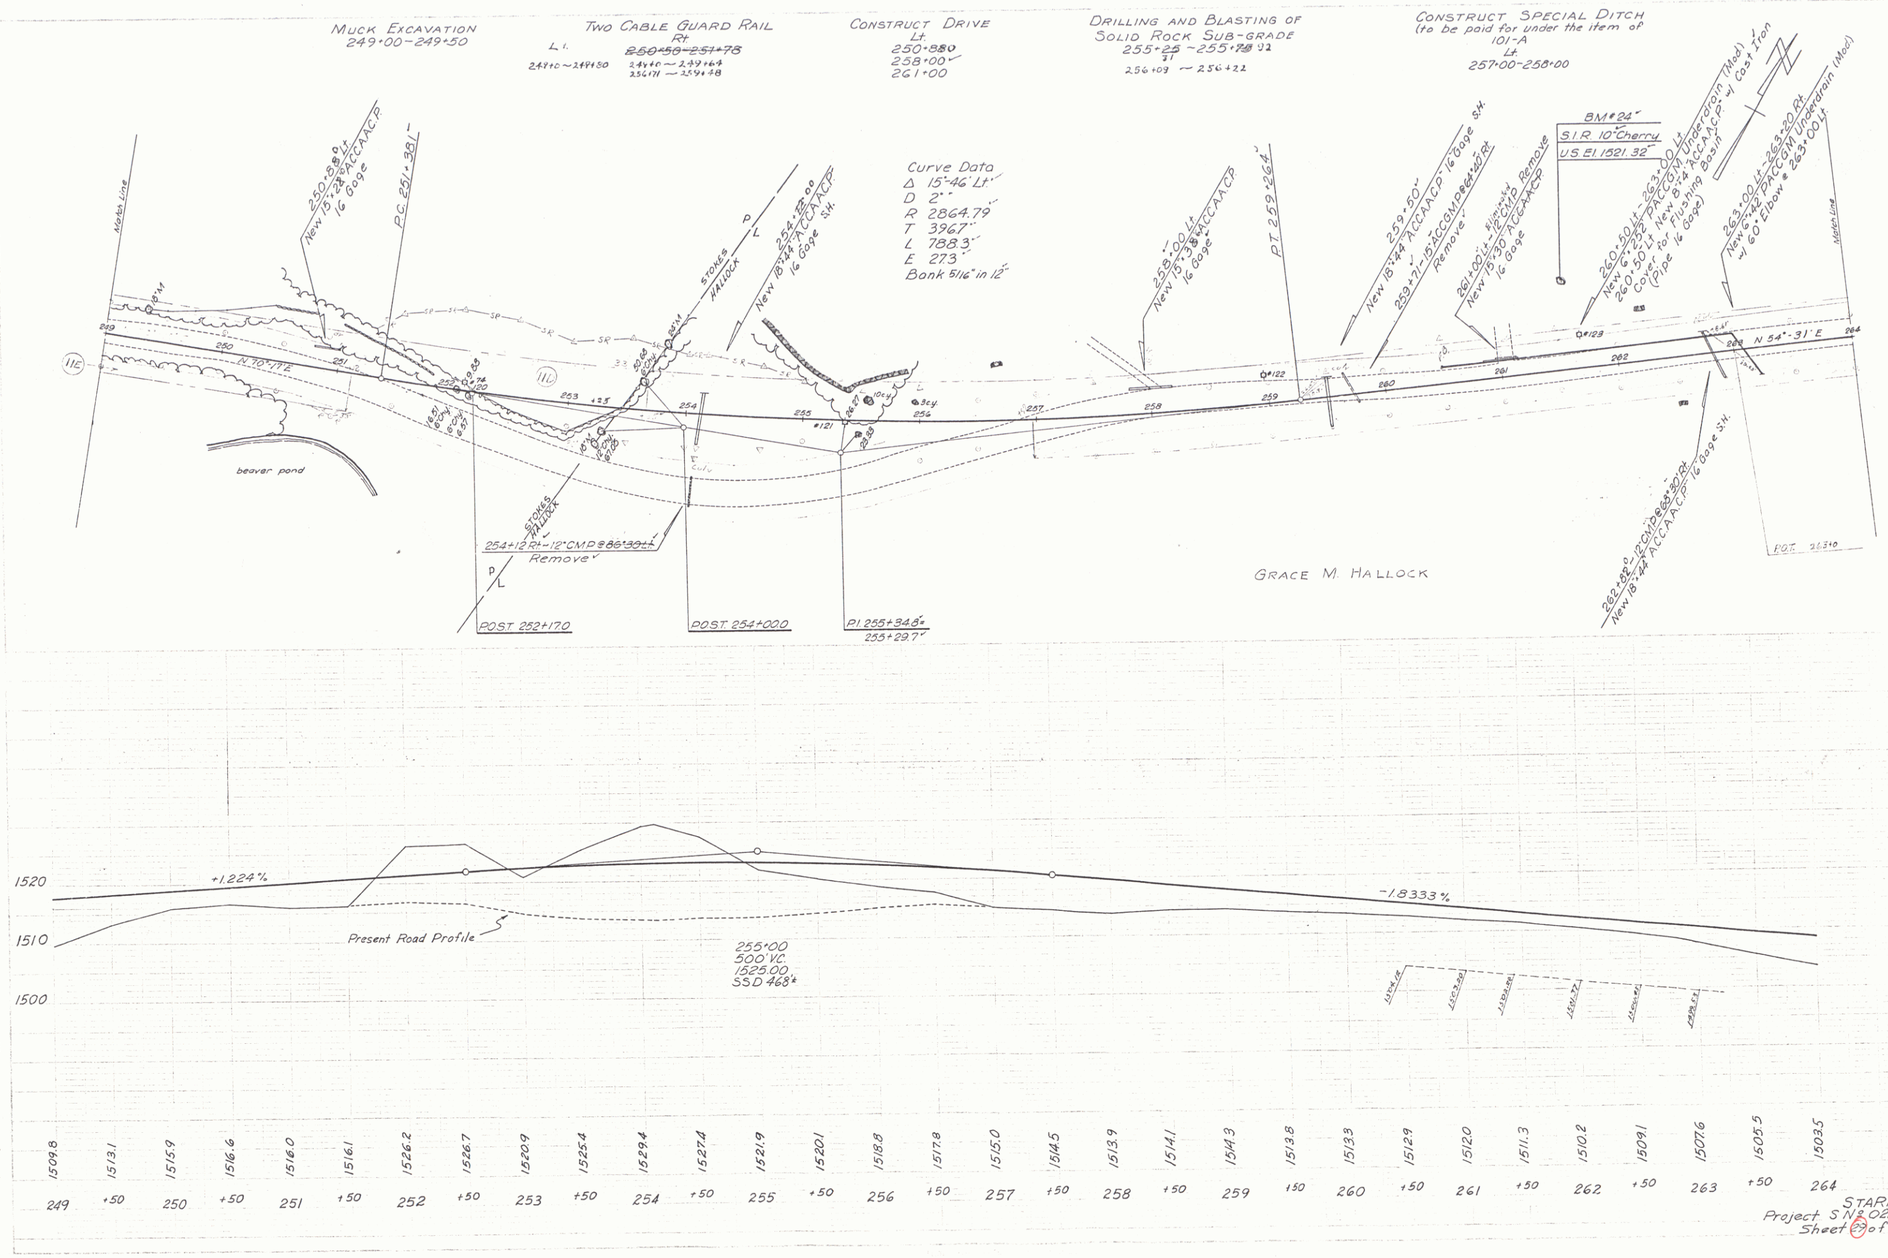
Muck Excavation
249+00-249+50
Two Cable Guard Rail
Rt
~~250+58-257+78~~
249+10 ~ 249+50
249+10 ~ 249+64
256+71 ~ 257+78
Lt.
Construct Drive
Lt.
250+880
258+00
261+00
Drilling and Blasting of
Solid Rock Sub-Grade
255+25 ~ 255+78
256+09 ~ 256+22
Construct Special Ditch
(to be paid for under the item of
101-A
Lt
257+00-258+00
Curve Data
Δ 15°-46' Lt
D 2°
R 2864.79'
T 396.7'
L 788.3'
E 273'
Bank 5/16" in 12"
BM #24
S.I.R. 10" Cherry
U.S. El. 1521.32'
Meter Line
beaver pond
N 70°-17' E
N 54°-31' E
Grace M. Hallock
Stokes Hallock
POST 252+170
POST 254+000
PI 255+34.6
255+29.7
PT 259+26.4
Present Road Profile
255+00
500' VC
1525.00
SSD 468'
+1.224%
-1.8333%
1520
1510
1500
STARKSBORO
Project S N.S. 0200(3)SA
Sheet 4 of 67

4