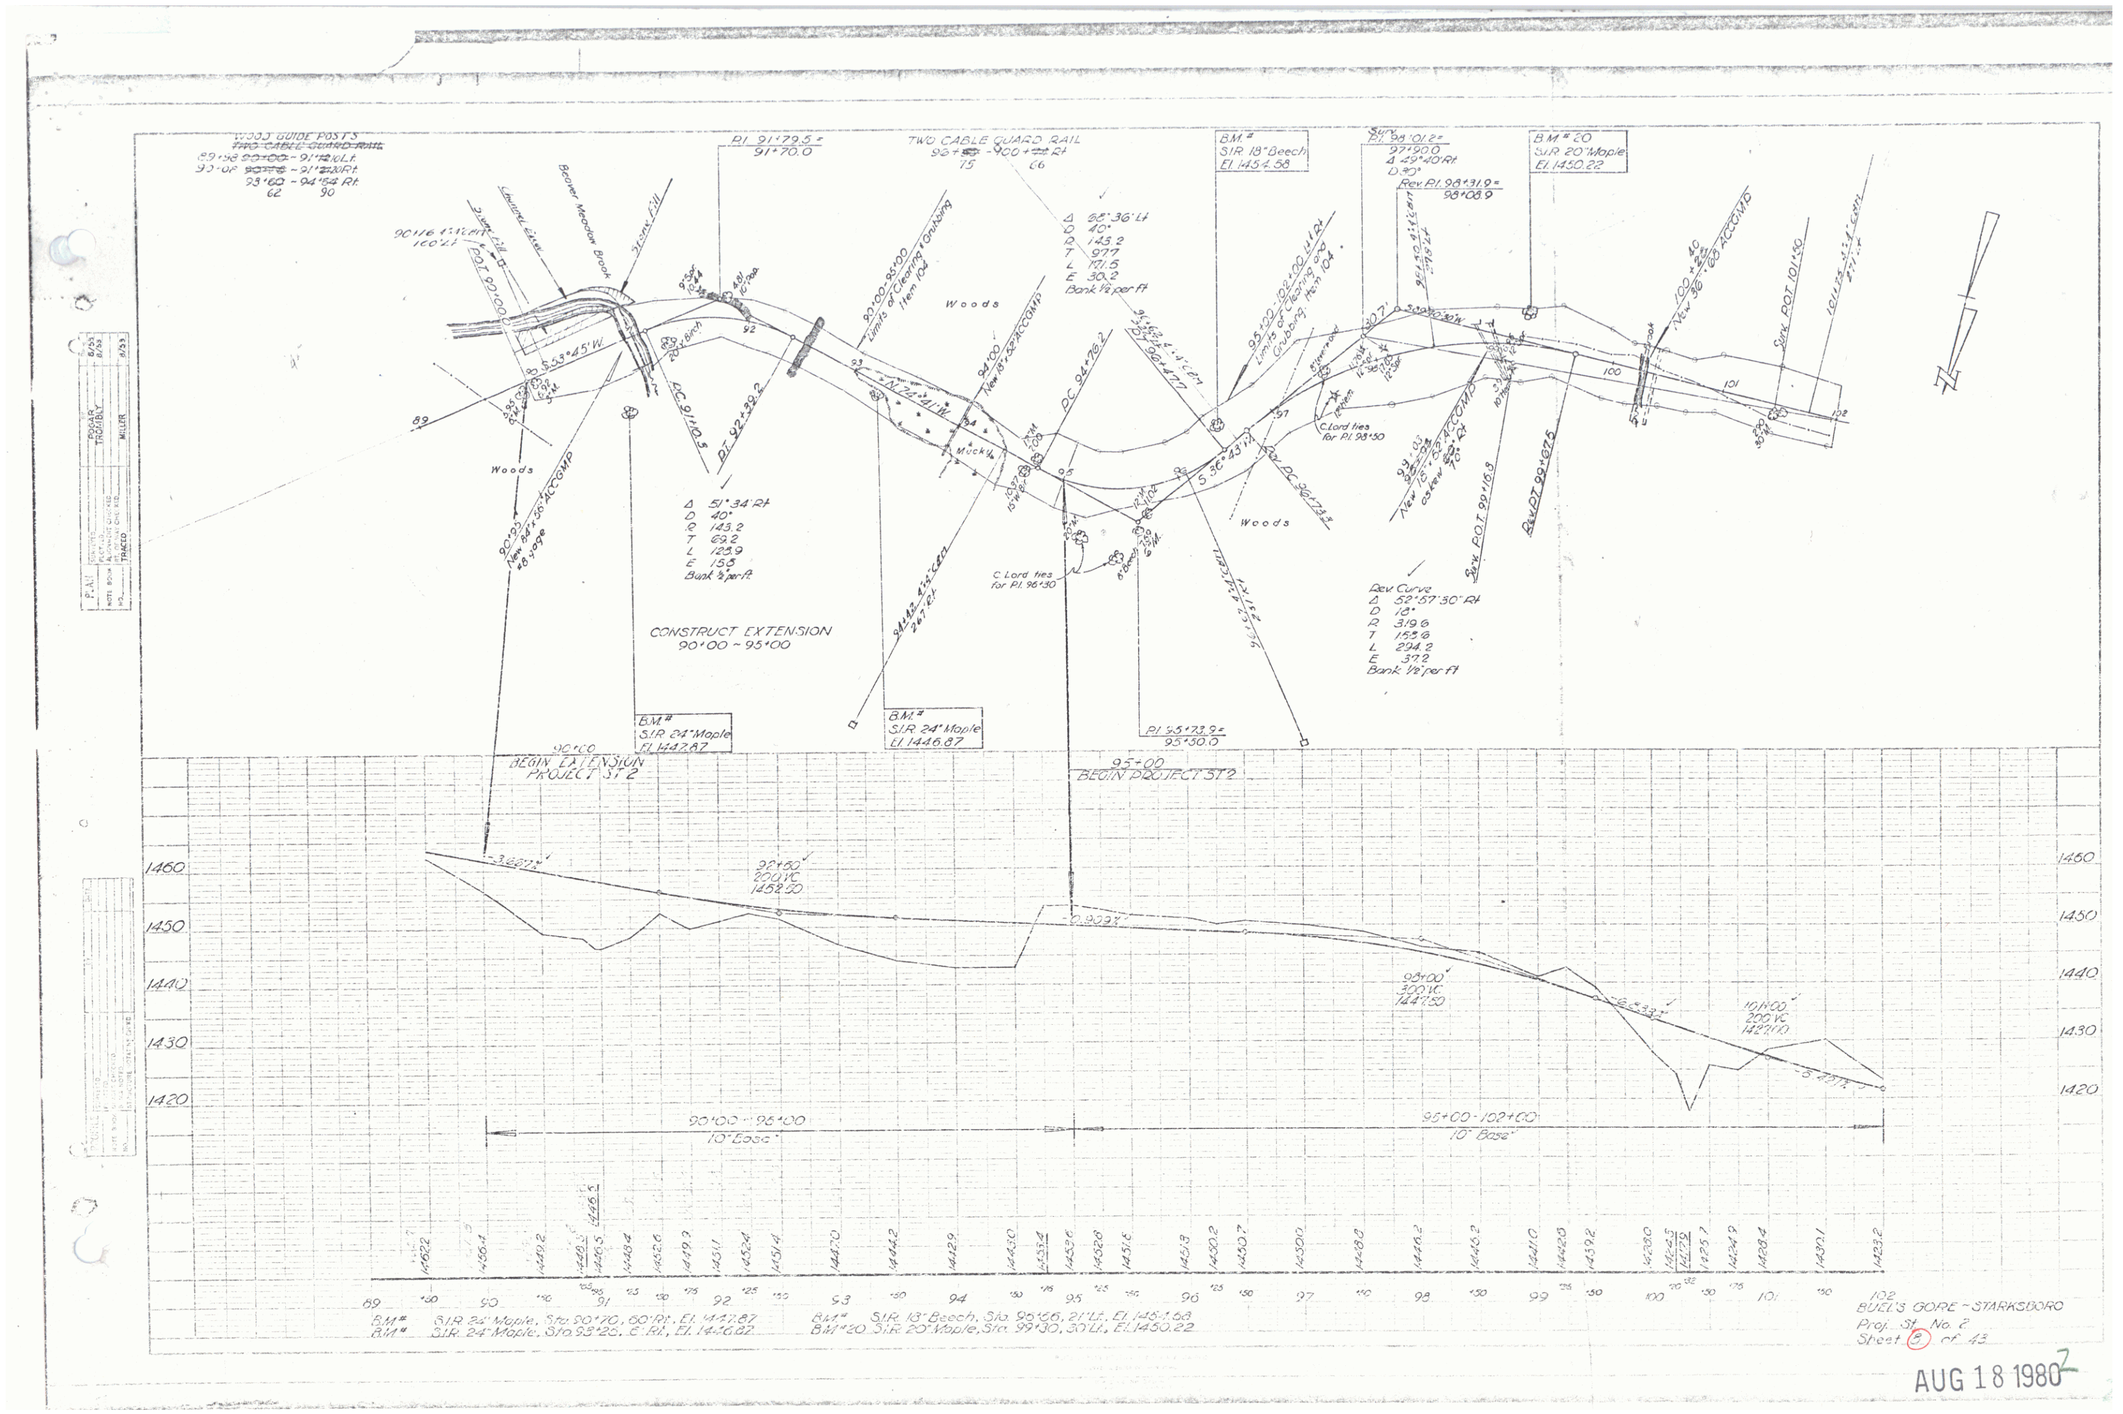
WOOD GUIDE POSTS
TWO CABLE GUARD RAIL
Beaver Meadow Brook
Woods
Mucky
CONSTRUCT EXTENSION
90+00 ~ 95+00
BEGIN EXTENSION
PROJECT ST 2
95+00
BEGIN PROJECT ST 2
90+00 - 95+00
10" Base
95+00 - 102+00
10" Base
BUEL'S GORE ~ STARKSBORO
Proj. St. No. 2
Sheet 8 of 43

AUG 18 1980