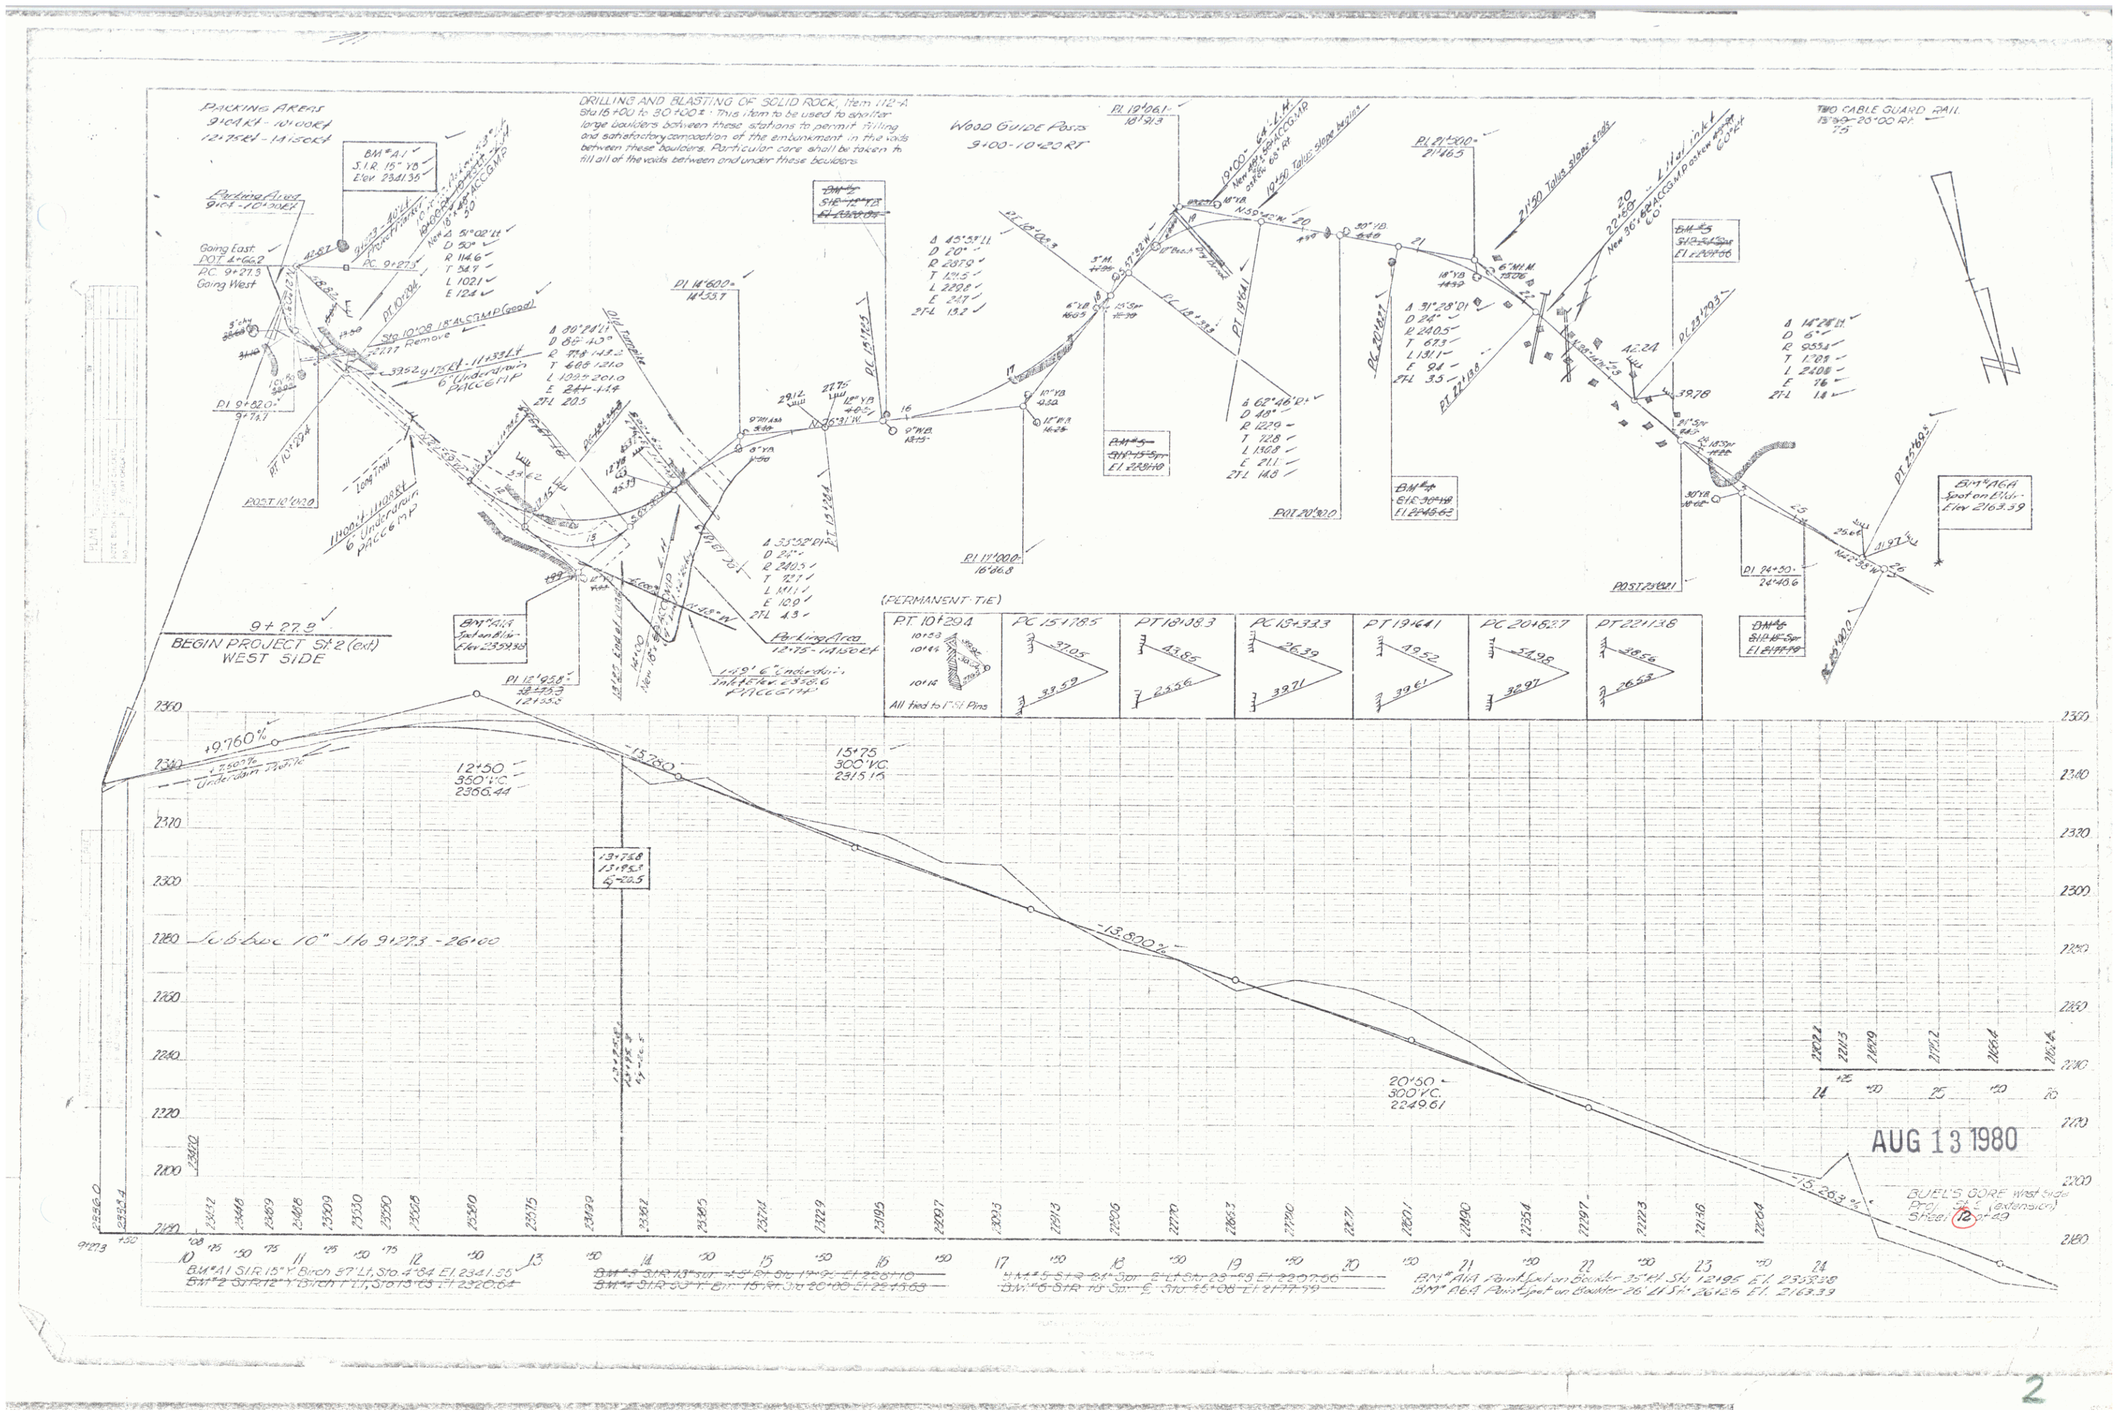
PARKING AREAS
9+00 Rt - 10+00 Rt
12+75 Rt - 14+50 Rt
DRILLING AND BLASTING OF SOLID ROCK, Item 112-A
Sta 15+00 to 30+00 ±: This item to be used to shatter large boulders between these stations to permit filling and satisfactory compaction of the embankment in the voids between these boulders. Particular care shall be taken to fill all of the voids between and under these boulders.
Wood Guide Posts
9+00 - 10+20 RT
TWO CABLE GUARD RAIL
13+90 - 20+00 Rt
BEGIN PROJECT Sta 2 (ext.)
WEST SIDE
Parking Area
12+75 - 14+50 Rt
(PERMANENT TIE)
All tied to 1"Sq Pins
Subbase 10" thru 9+27.3 - 26+00
AUG 13 1980
BUEL'S GORE West Side
Proj. 9+27.3 (extension)
Sheet 12 of 29

2