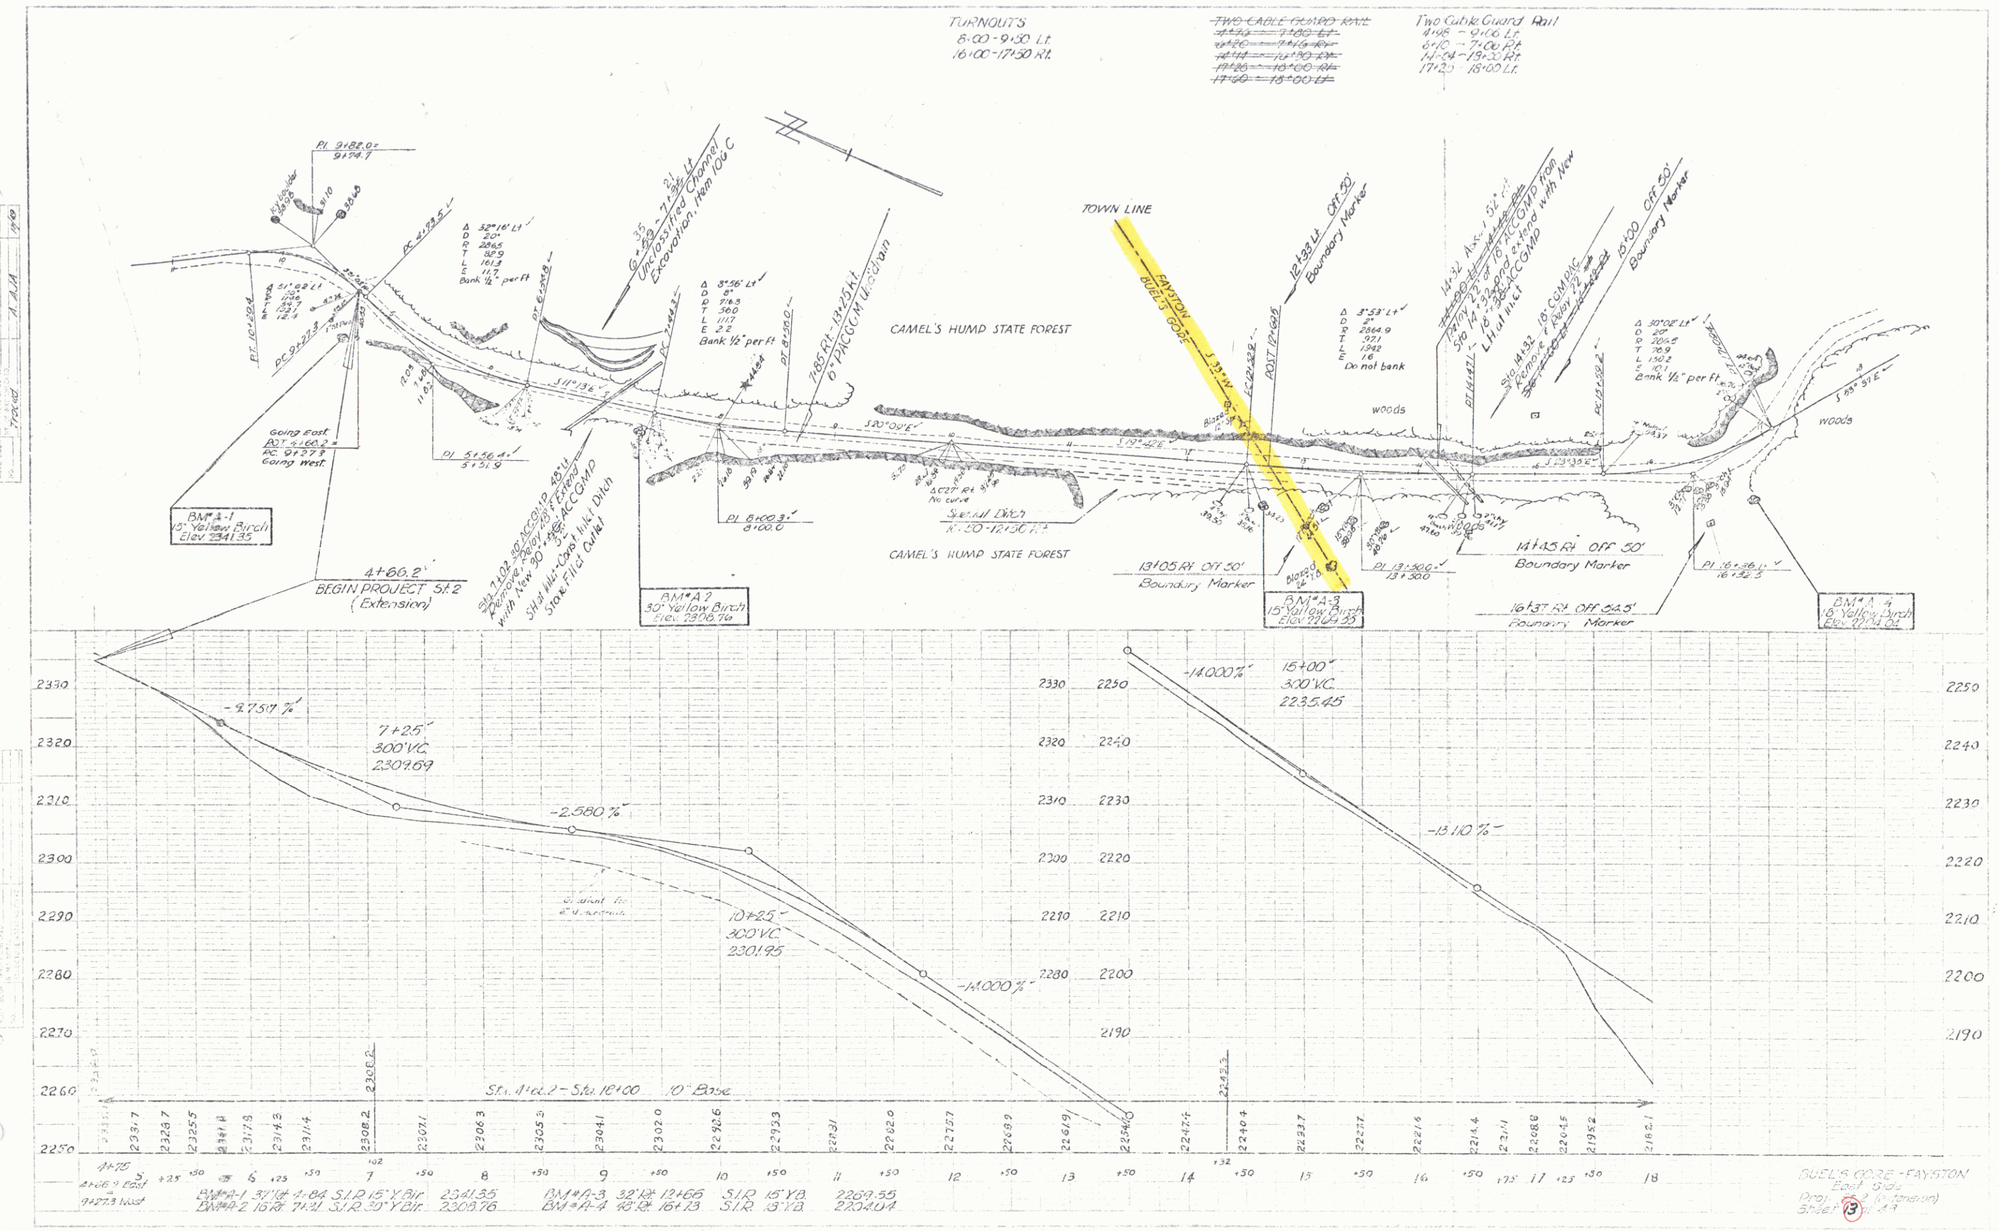
TURNOUTS
6+00 - 9+50 Lt.
16+00 - 17+50 Rt.
Two Cable Guard Rail
4+95 - 9+06 Lt.
6+10 - 7+00 Rt.
14+04 - 15+20 Rt.
17+20 - 18+00 Lt.
TOWN LINE
FAYSTON
BUELS GORE
CAMEL'S HUMP STATE FOREST
CAMEL'S HUMP STATE FOREST
Do not bank
Do not bank
Bank 1/2" per ft
Bank 1/2" per ft
Bank 1/2" per ft
Unclassified Channel Excavation, Item 100 C
Sta. 14+32 105 COMP.