




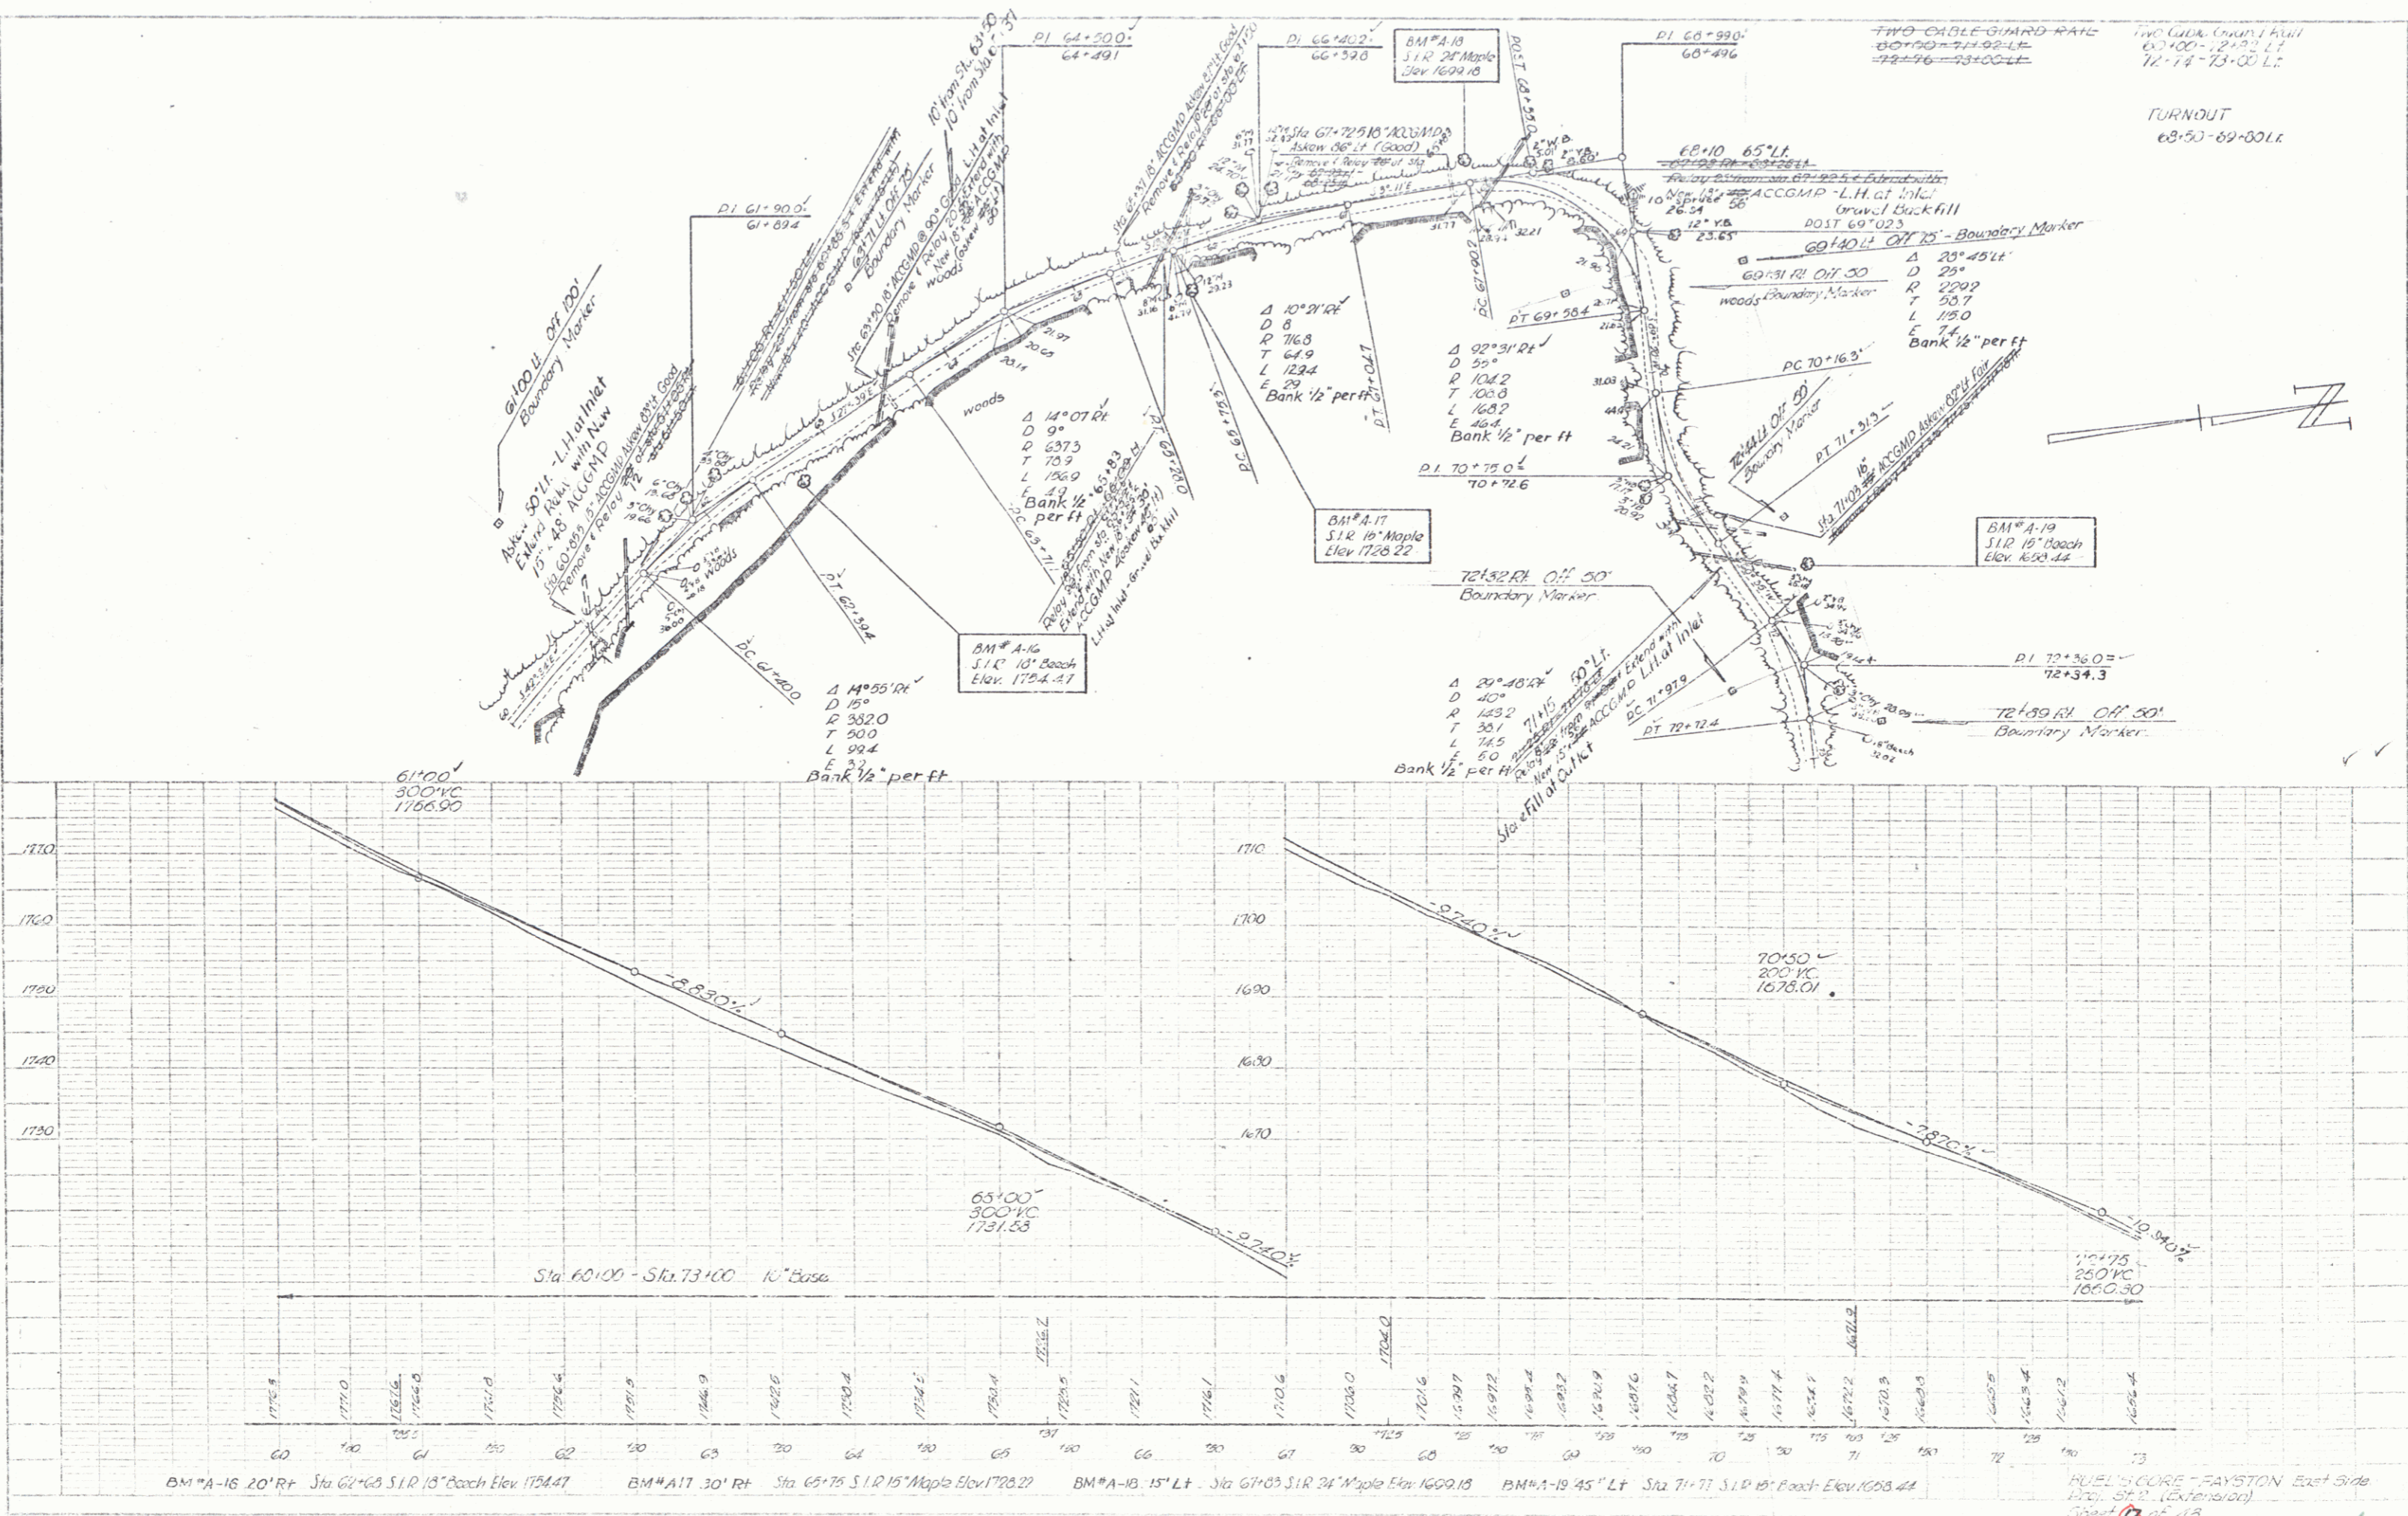

AUG 18 1980