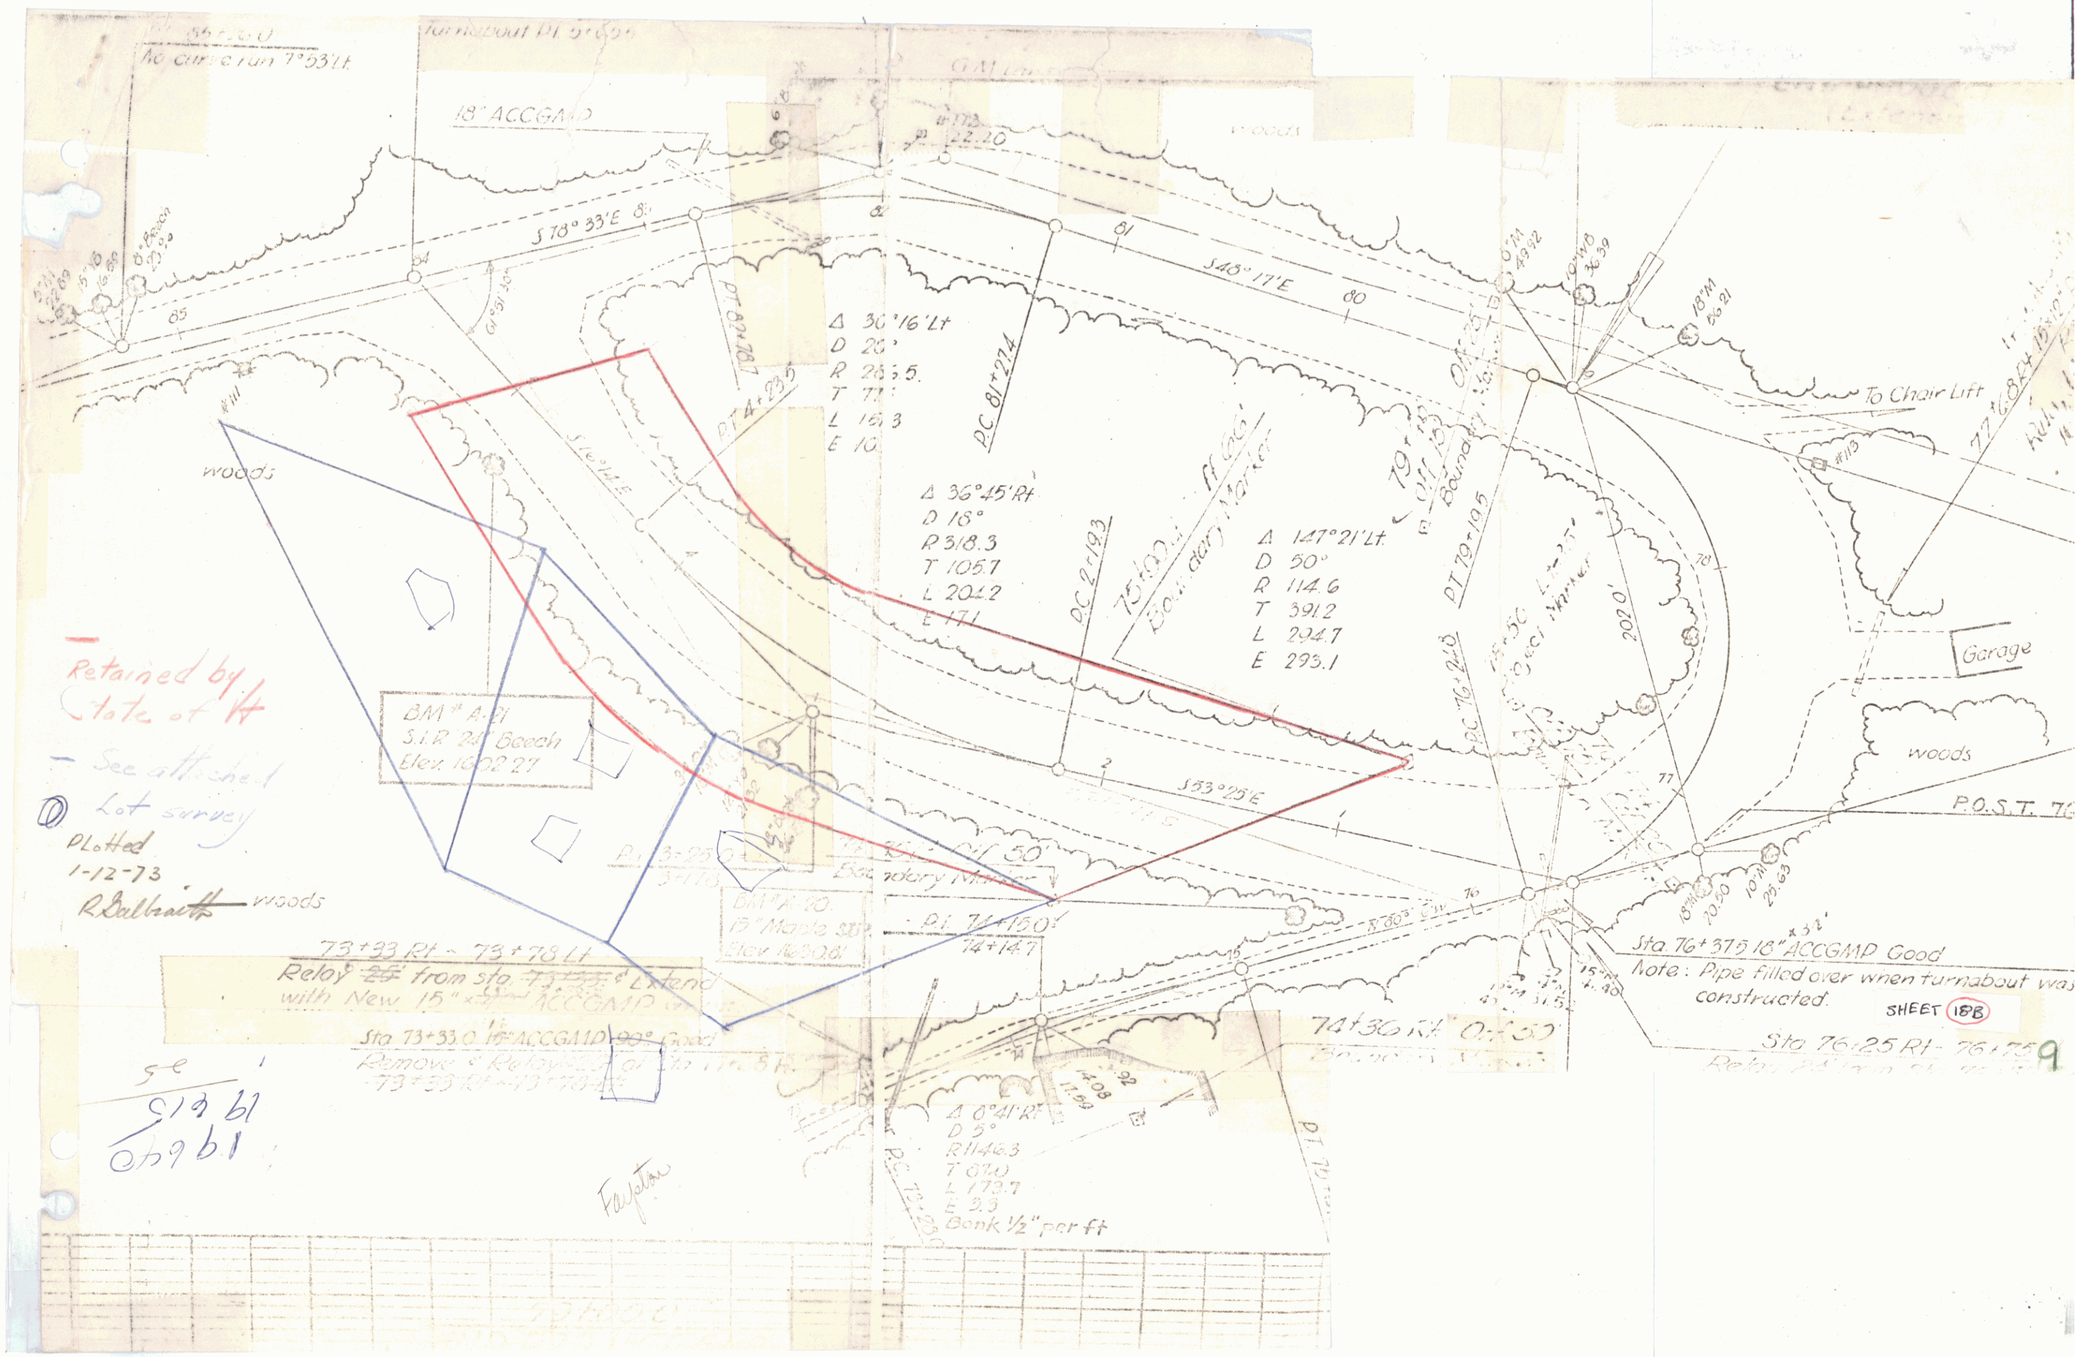
18" ACCGMP
S 78° 33' E
S 48° 17' E
S 83° 25' E
Δ 30° 16' Lt
D 20°
R 286.5
T 77.1
L 151.3
E 10.
Δ 36° 45' Rt
D 18°
R 318.3
T 105.7
L 204.2
E 17.1
Δ 147° 21' Lt
D 50°
R 114.6
T 391.2
L 294.7
E 293.1
Δ 0° 41' Rt
D 5°
R 1146.3
T 67.0
L 133.7
E 2.3
Bank 1/2" per ft
woods
To Chair Lift
Garage
P.O.S.T. 76
BM# A-21
S.I.R. 24" Beech
Elev. 1602.27
BM# A-20
15" Maple
Elev. 1630.81
Sta. 76+37.5 18" ACCGMP Good
Note: Pipe filled over when turnabout was constructed.
SHEET 18B
Sta. 76+25 Rt - 76+75
73+33 Rt - 73+78 Lt
Relay from sta. 73+33 Lt and with New 15" ACCGMP
Sta. 73+33.0 18" ACCGMP 90° Good
74+36 Rt 0+50
Retained by State of Vt
See attached Lot survey
Plotted 1-12-73
R. Galbraith
Fenton