



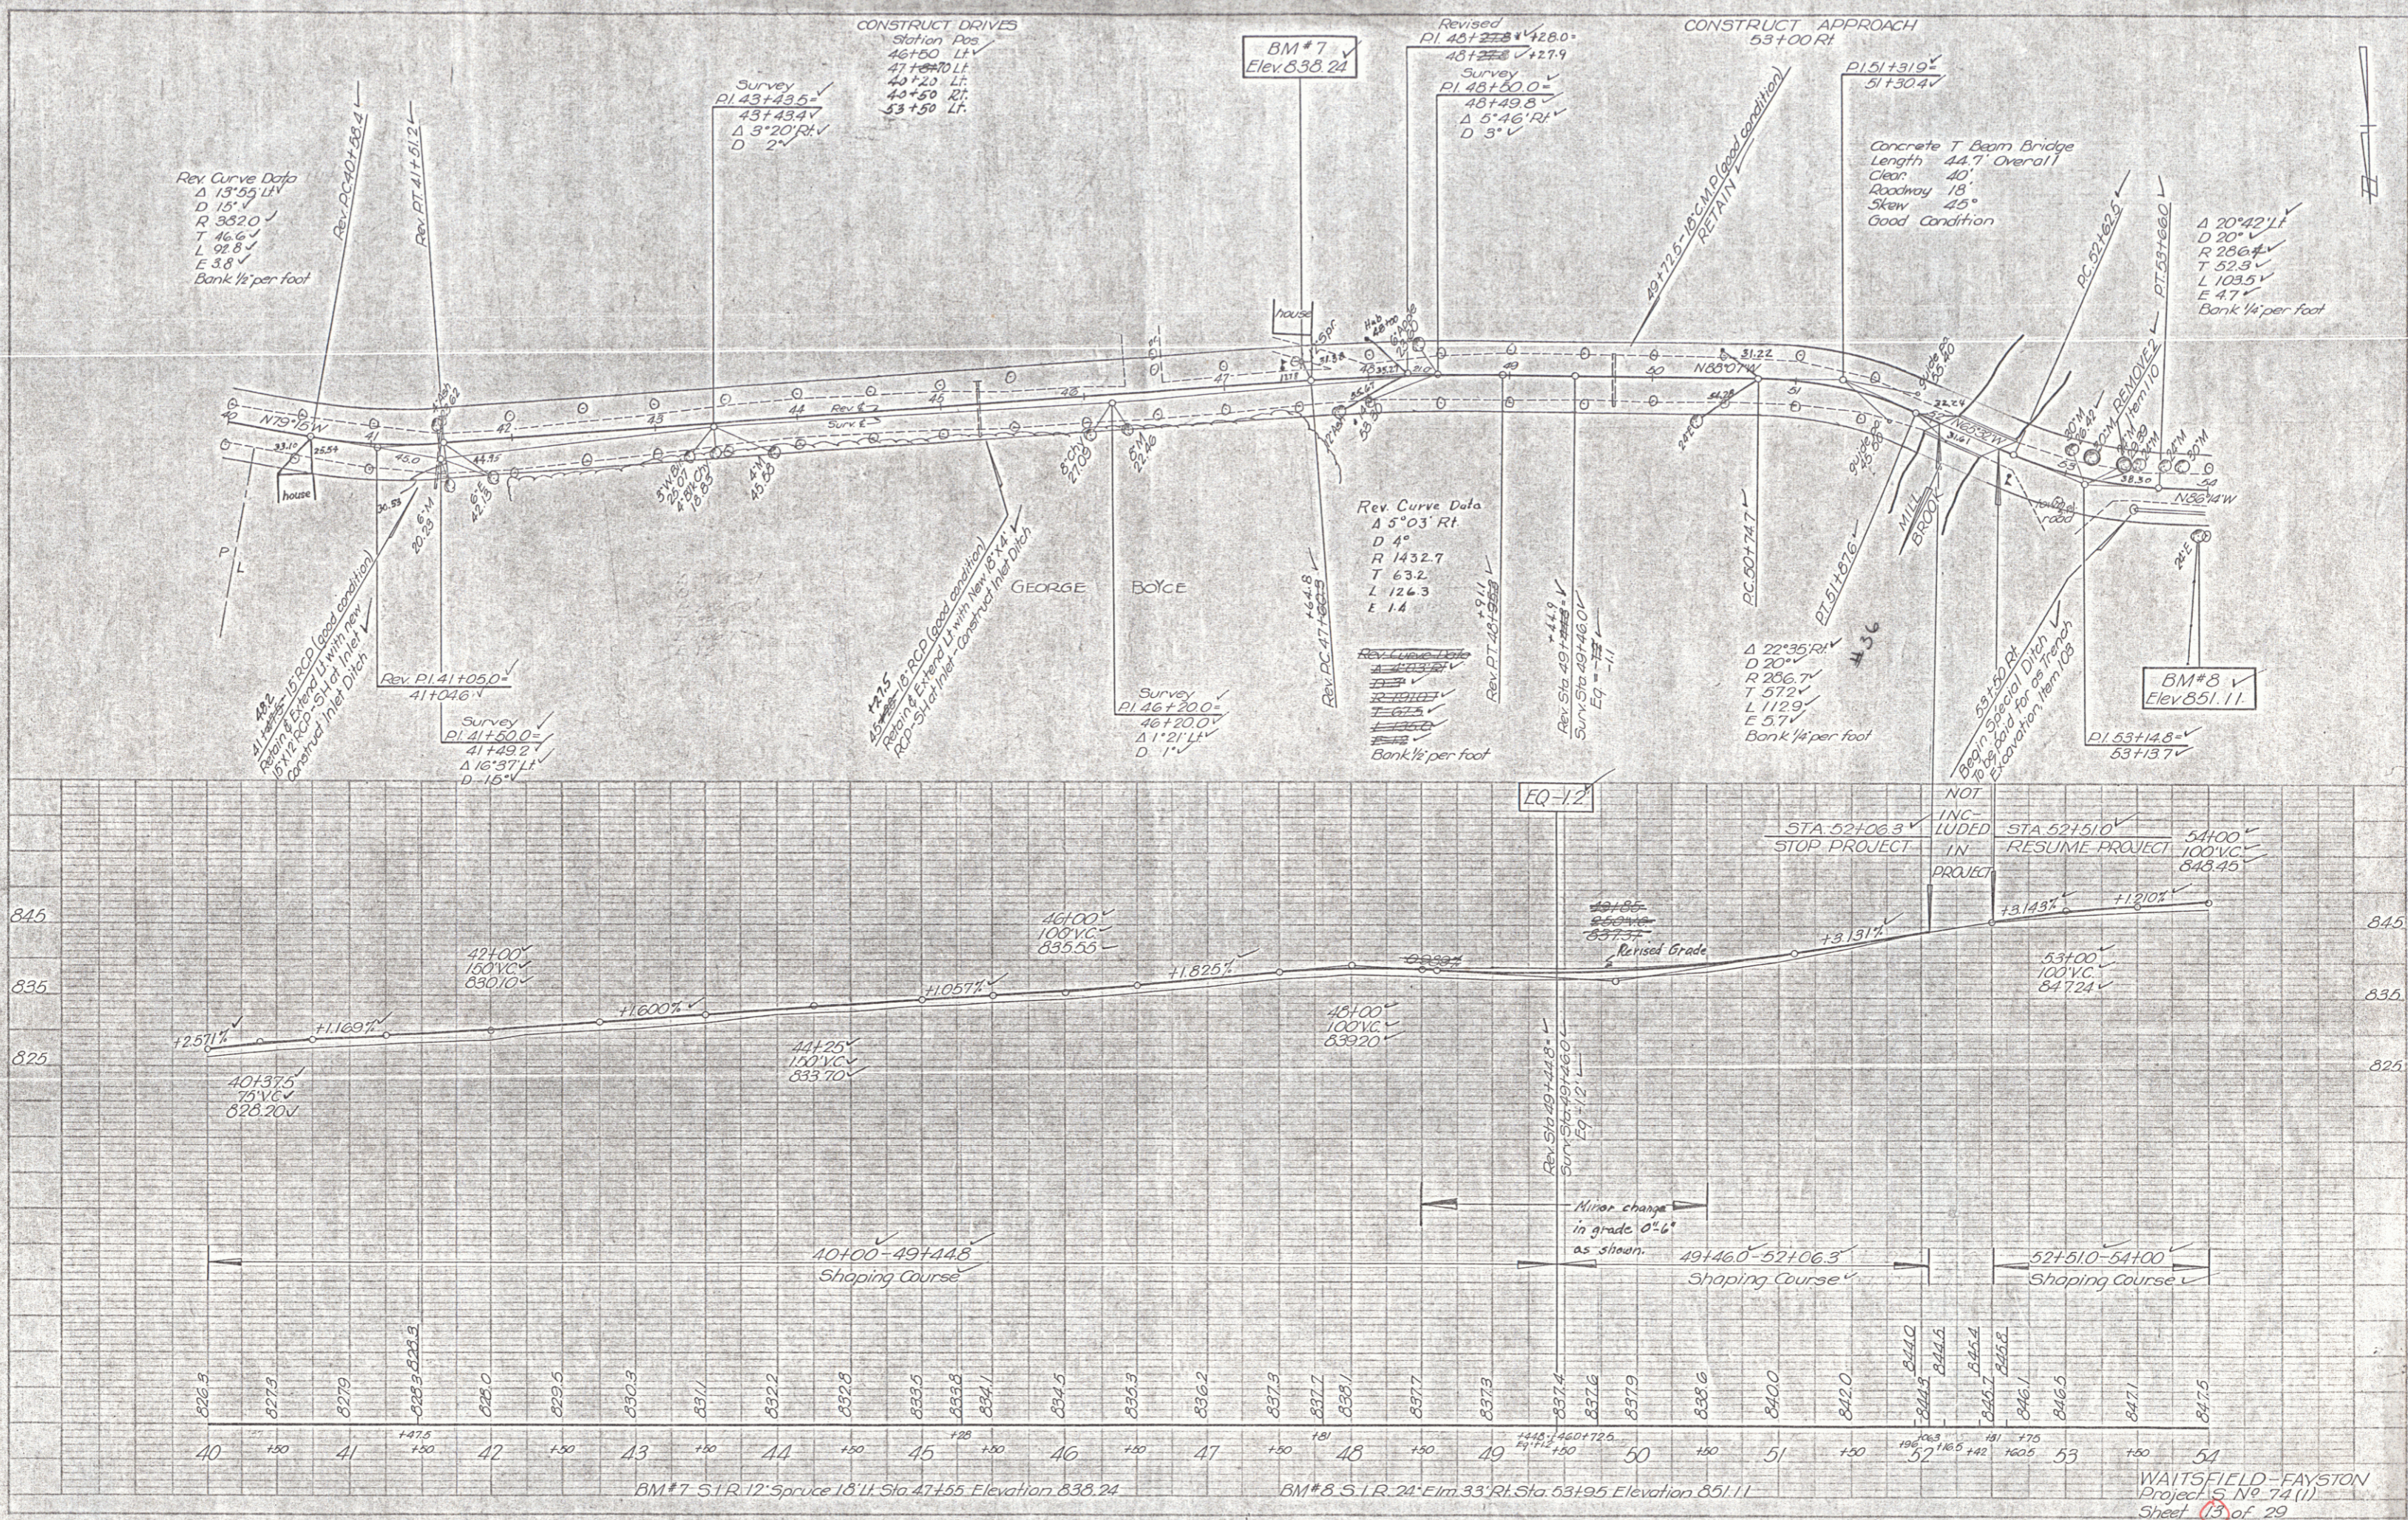


PLATE 11. PLAN PROFILE
 WAITSFIELD-FAYSTON
 Project No. 74 (1)
 Sheet 13 of 29

5