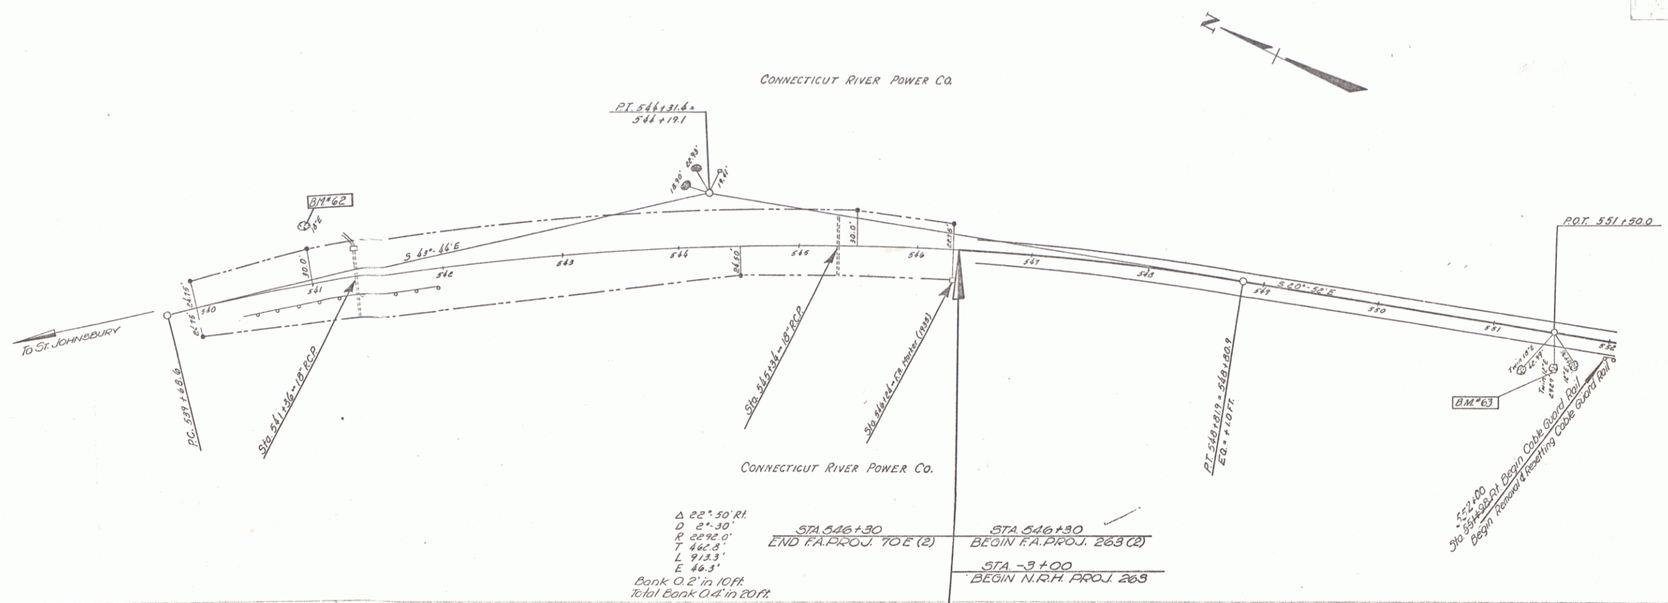

BM #62 - Spike in Root - 18" Elm - 47' Lt. 540+99 - Elev. 763.83
BM #63 - " " " Twin 12" Elm - 28.5' Rt. 551+49 - Elev. 734.17

WATERFORD
SERIES F.A.P. NO. 263(2)
SHEET 3 OF 11

2