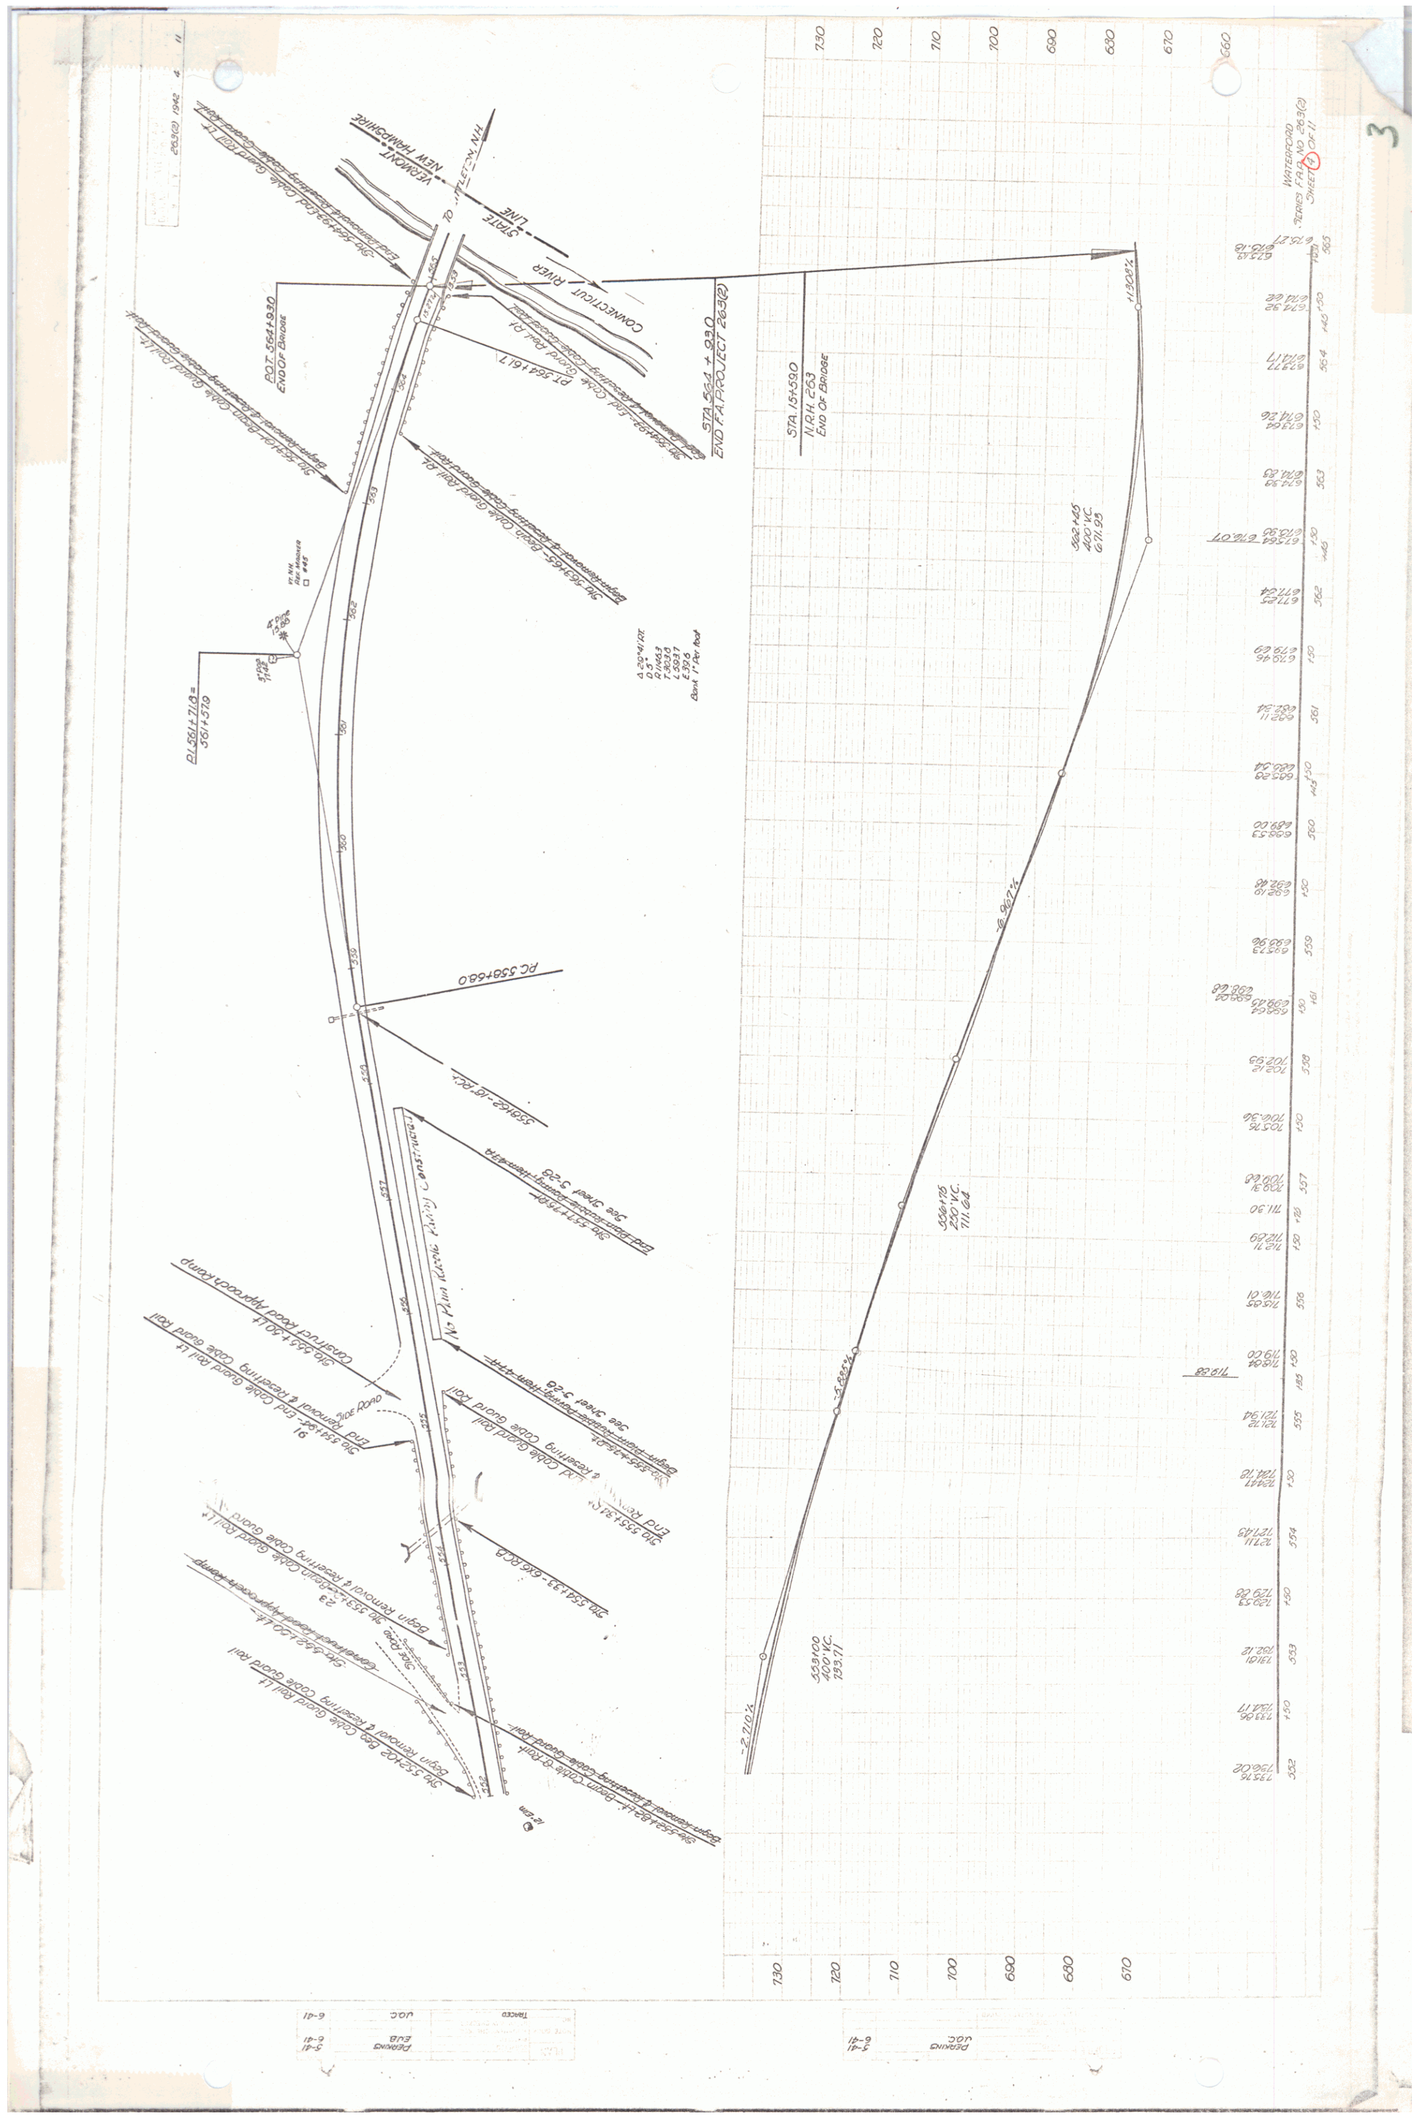
VERMONT
NEW HAMPSHIRE
STATE LINE
CONNECTICUT RIVER
STA. 564 + 23.0
END F.A. PROJECT 263(2)
STA. 15+59.0
N.R.H. 263
END OF BRIDGE
EOT 564+93.0
END OF BRIDGE
PT 564+61.7
PC 559+68.0
PT 263+92.0
PC 263+67.0
PI 263+42.0
PT 263+17.0
PC 262+42.0
PI 262+17.0
