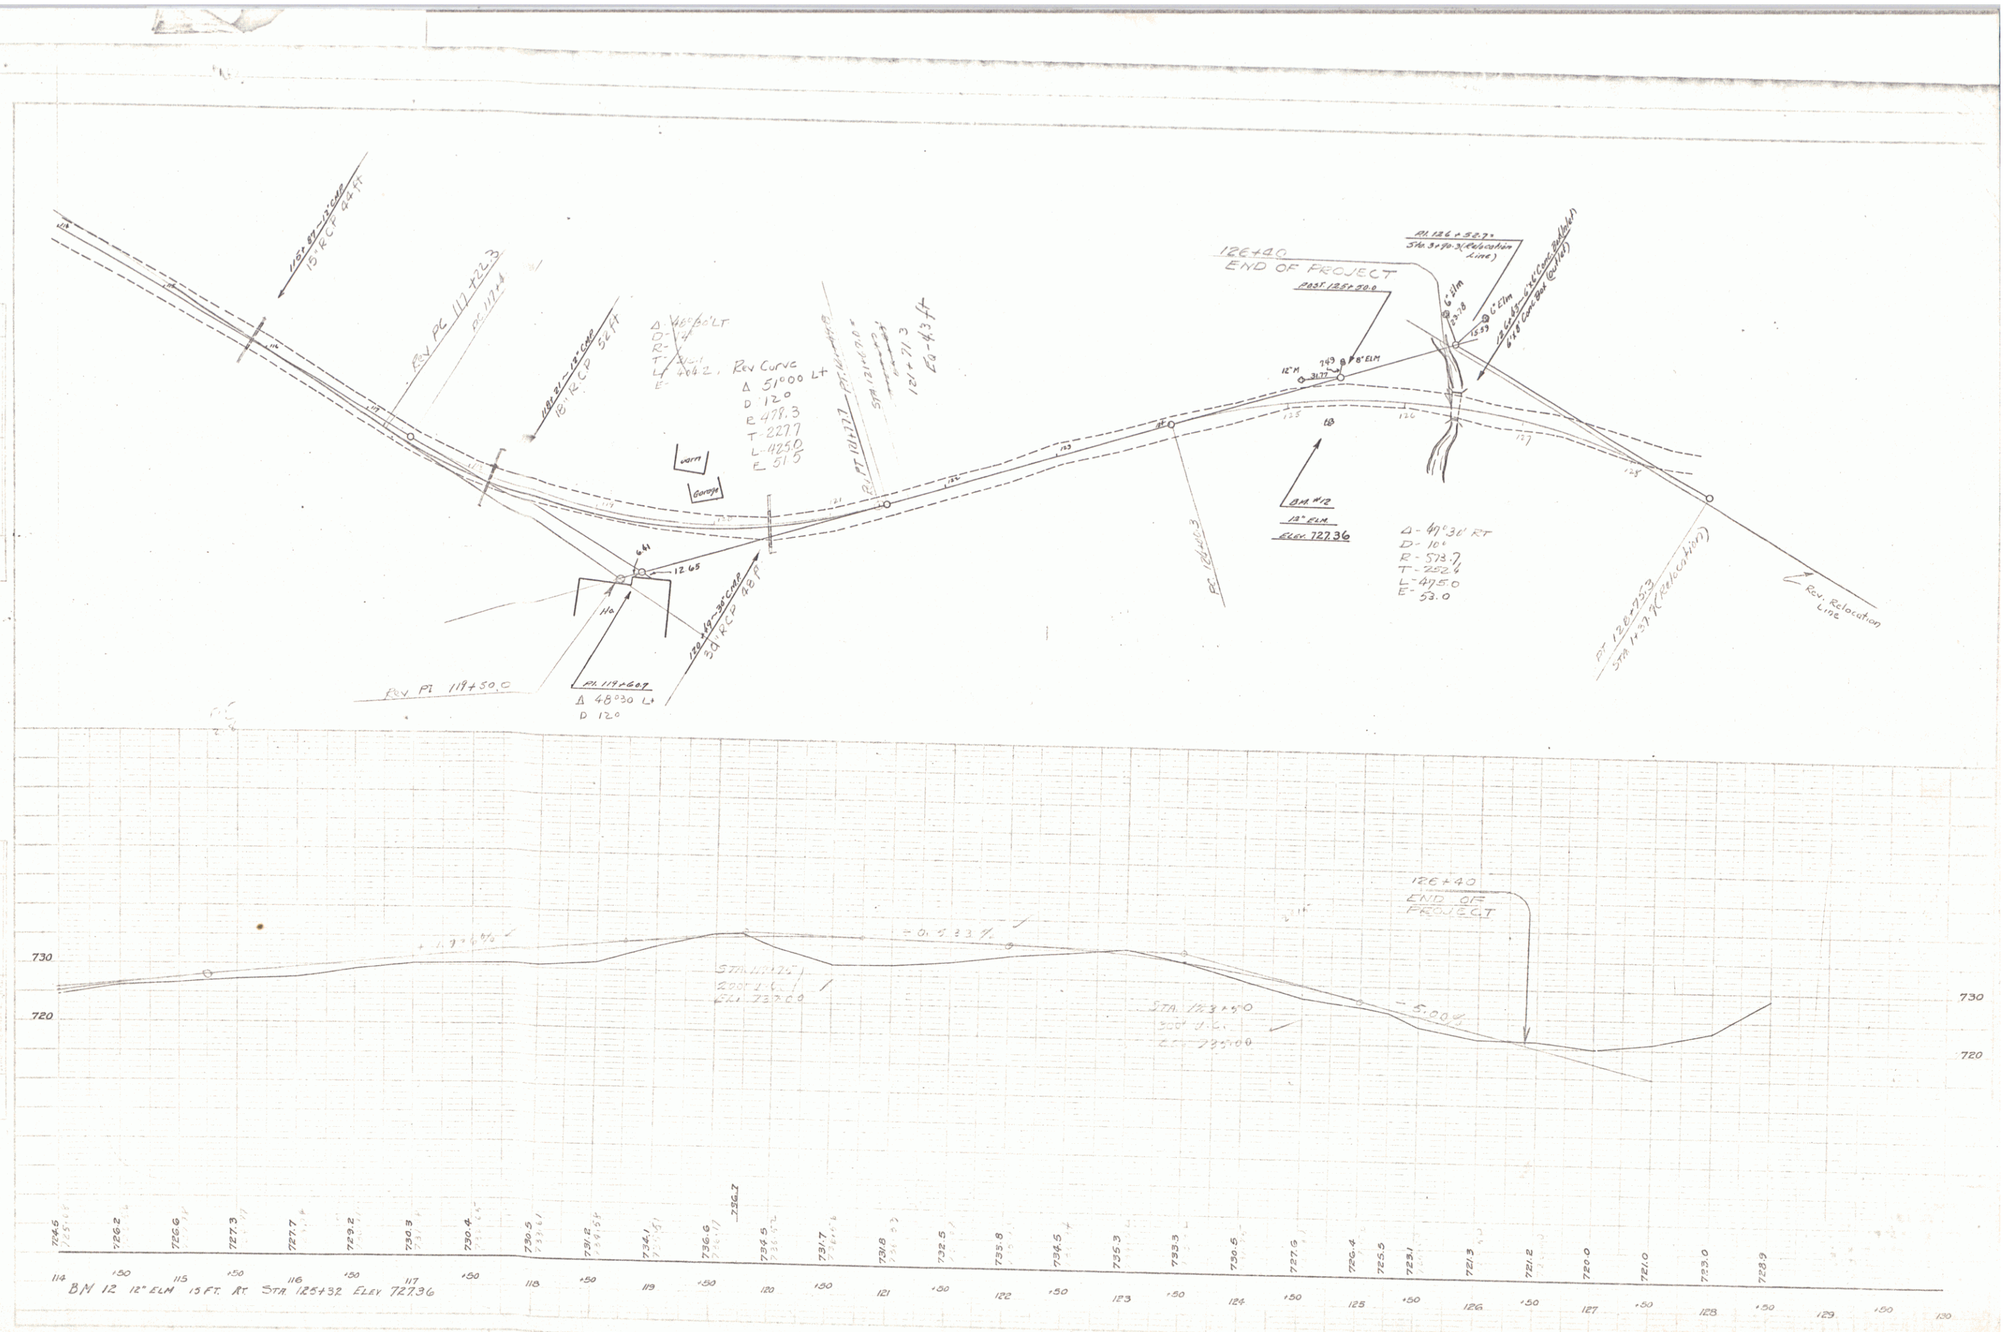
12E+40
END OF PROJECT
Rev. Curve
Δ 51°00' Lt
D 12.0
E 478.3
T 227.7
L 425.0
E 51.5
Δ 47°30' RT
D 10°
R 573.7
T 252.6
L 475.0
E 53.0
Rev. Relocation Line
BM #12
12" ELM
ELEV. 727.36
Rev. PI 119+50.0
PI 119+67
Δ 48°30' Lt
D 12°
730
720
BM 12 12" ELM 15 FT. RT. STA. 125+32 ELEV. 727.36

SHEET 10

10