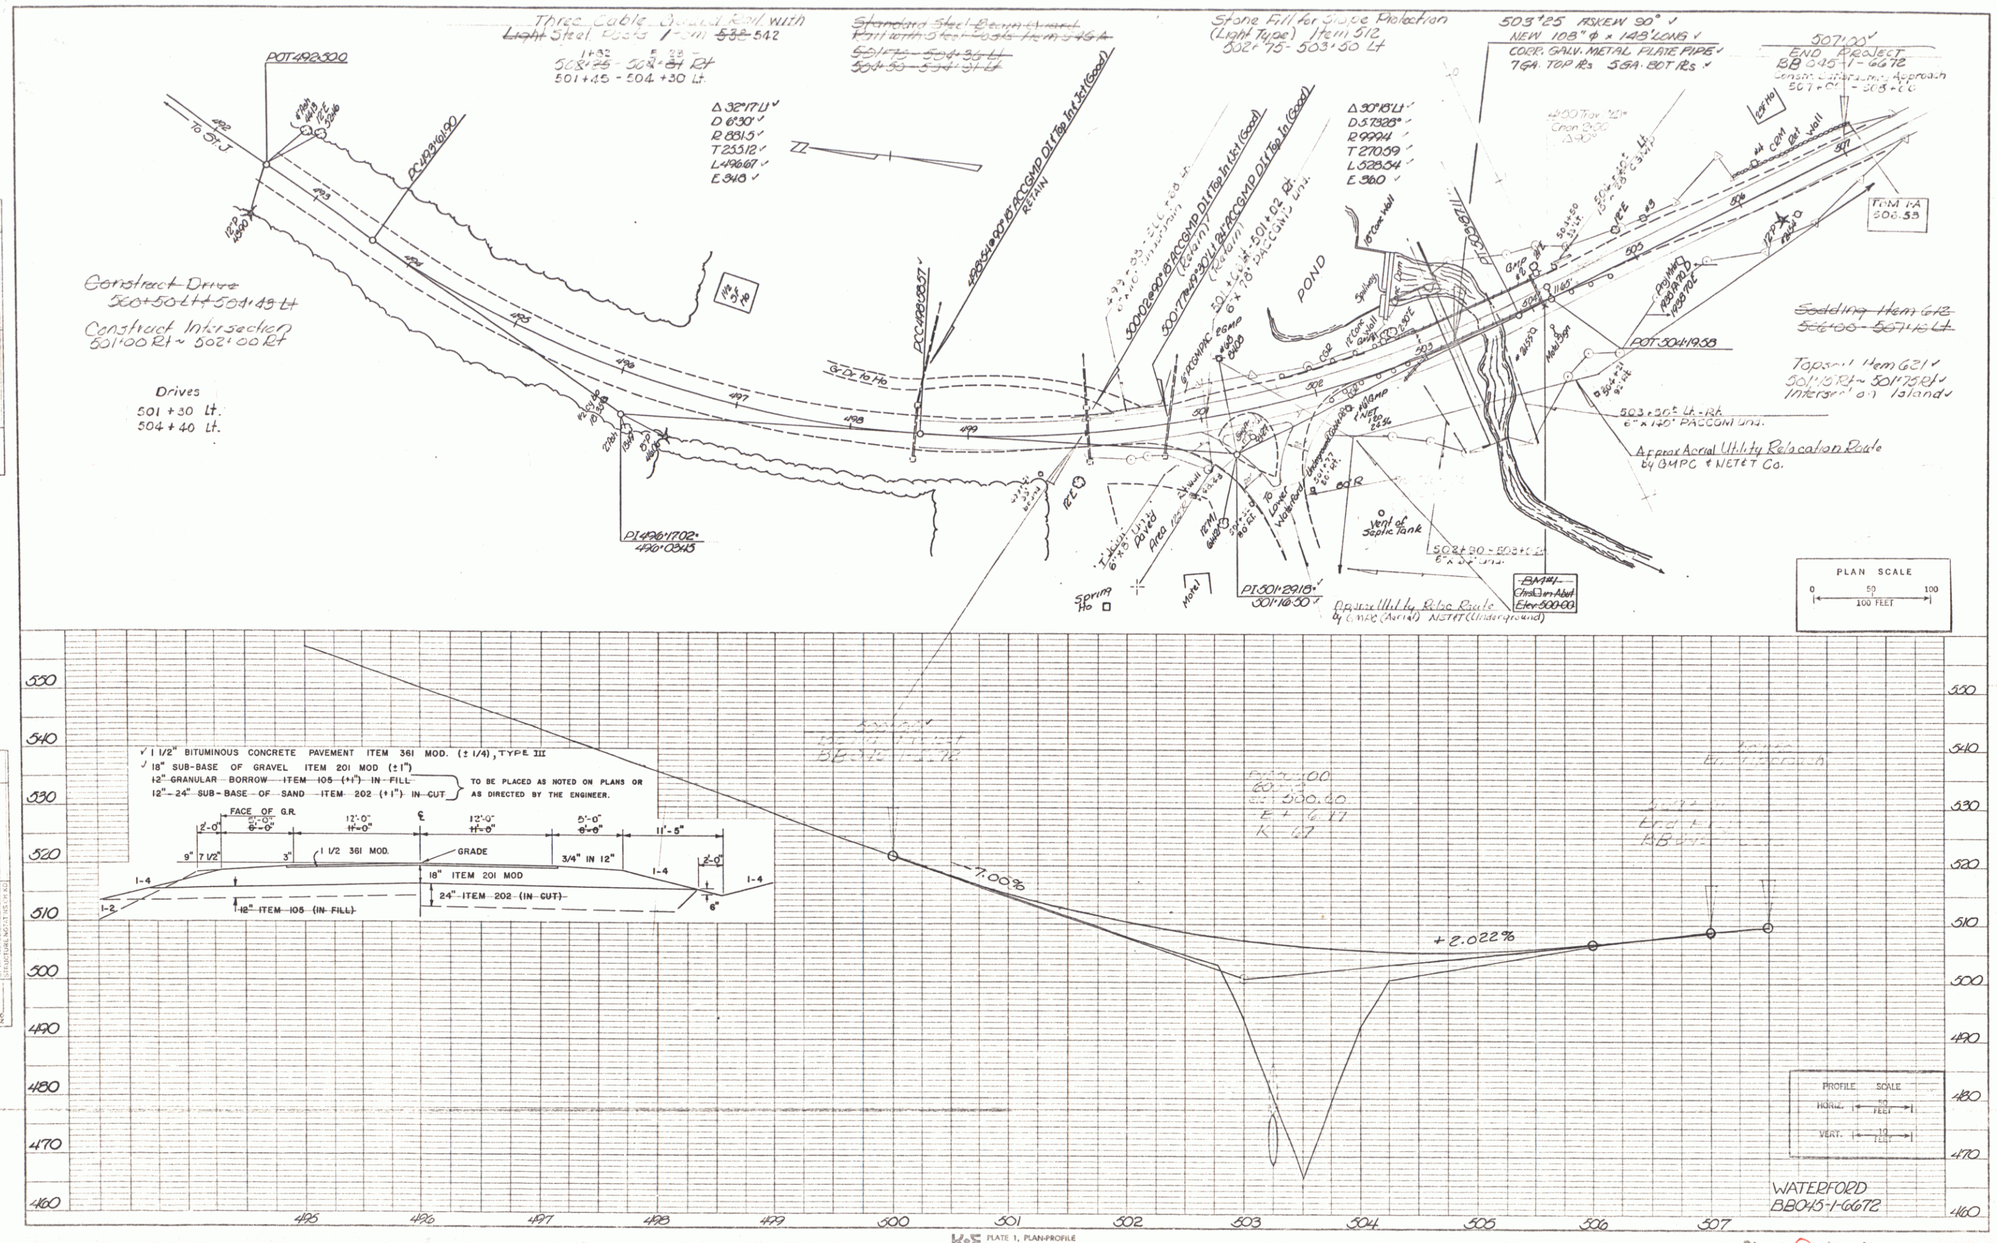
Three Cable Guard Rail with Light Steel Posts Item 538-542
Standard Steel Beam Guard Rail with Steel Posts Item 545A
Stone Fill for Slope Protection (Light Type) Item 512
503+25 ASKEW 90°
NEW 108" Φ x 148' LONG
CORR. GALV. METAL PLATE PIPE
7GA. TOP RS 5GA. BOT RS
END PROJECT
Construct Drive
Construct Intersection
Drives
501 + 30 Lt.
504 + 40 Lt.
POND
Spillway
Top of Dam
Vent of Septic Tank
Sprin Ho
Model
Approx Aerial Utility Relocation Route by BMPC & NETET Co.
Approx Utility Relocation Route by C.N.R.E. (Aerial) NETET (Underground)
Topsoil Item 621
Seeding Item 612
PLAN SCALE
0 50 100
100 FEET
PROFILE SCALE
HORIZ. 50 FEET
VERT. 10 FEET
-7.00%
+2.022%
1 1/2" BITUMINOUS CONCRETE PAVEMENT ITEM 361 MOD. (± 1/4), TYPE III
18" SUB-BASE OF GRAVEL ITEM 201 MOD (± 1")
12" GRANULAR BORROW ITEM 105 (+1") IN FILL
12"-24" SUB-BASE OF SAND ITEM 202 (+1") IN CUT
TO BE PLACED AS NOTED ON PLANS OR AS DIRECTED BY THE ENGINEER.
FACE OF G.R.
GRADE
18" ITEM 201 MOD
24" ITEM 202 (IN CUT)
12" ITEM 105 (IN FILL)
3/4" IN 12"
WATERFORD
BB015-1-6672
PLATE 1, PLAN-PROFILE
KEUFFEL & ESSER CO.
Sheet 6 of 28 Sheets