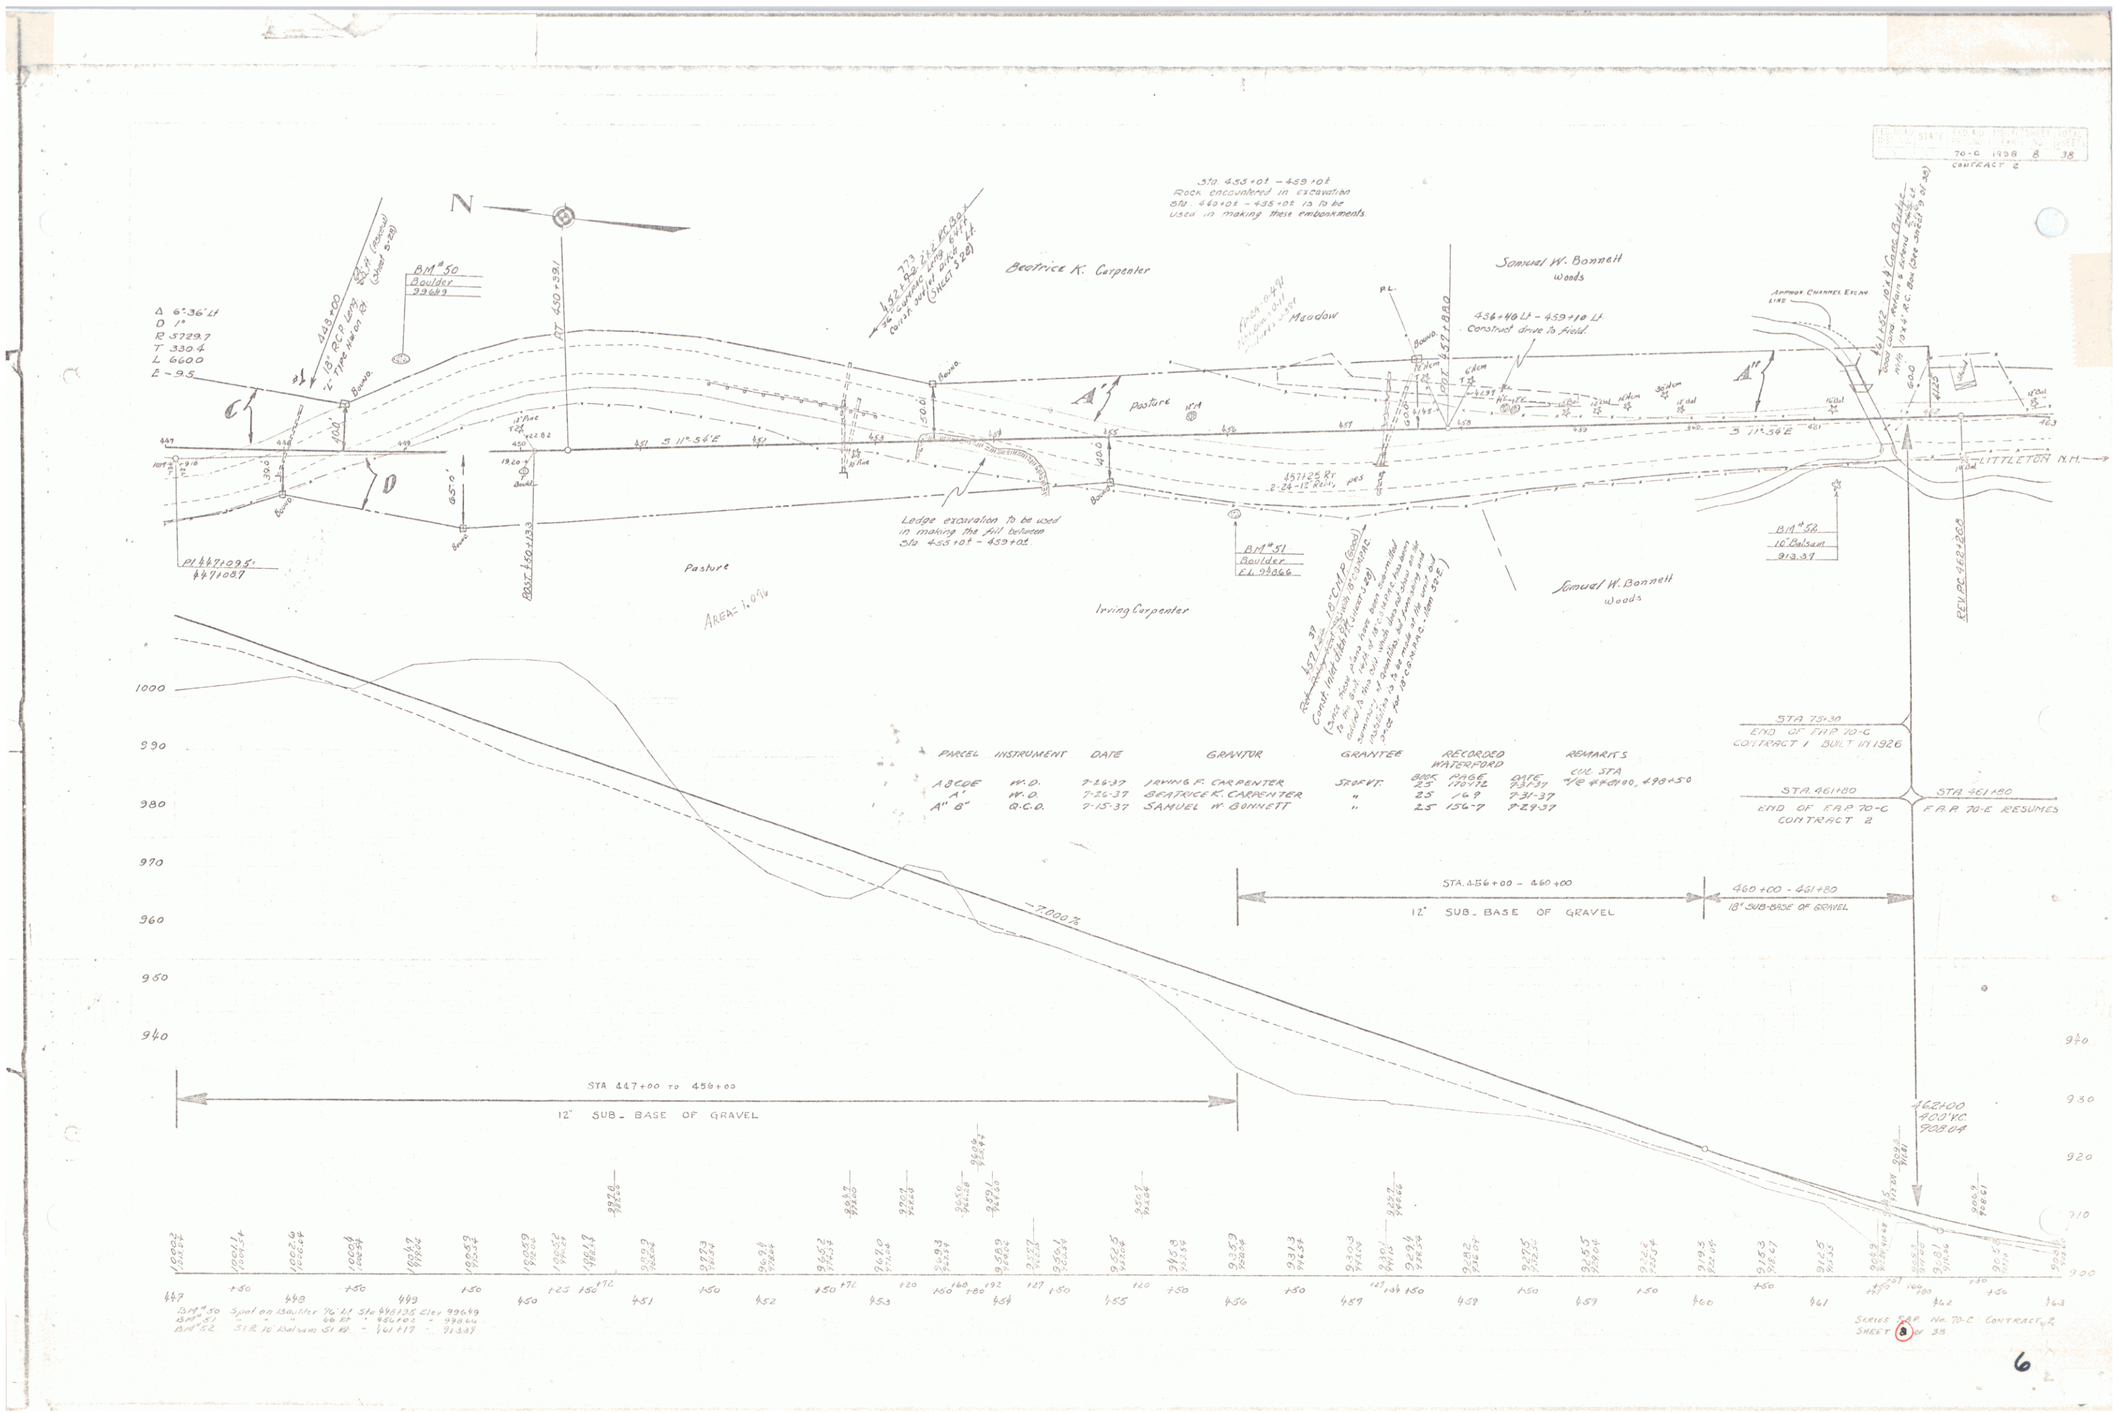

PARCEL	INSTRUMENT	DATE	GRANTOR	GRANTEE	RECORDED WATERFORD BOOK	PAGE	DATE	REMARKS
A B C D E	W.D.	7-26-37	IRVING F. CARPENTER	State Hwy.	25	170-72	7-31-37	Cul. Sta. 4/12 #461+00, 498+50
A'	W.D.	7-26-37	BEATRICE K. CARPENTER	"	25	169	7-31-37	
A" B"	Q.C.D.	7-15-37	SAMUEL W. BONNETT	"	25	156-7	8-24-37	

BM #50 Spike on Boulder 76 Lt Sta 448+35 Elev 99649
BM #51 " " " 66 Rt - 98066 - 99644
BM #52 SIR 10" Balsam 51 Rt. - 461+17 - 913.37

SERIES F.A.P. No. 70-C CONTRACT 2

6