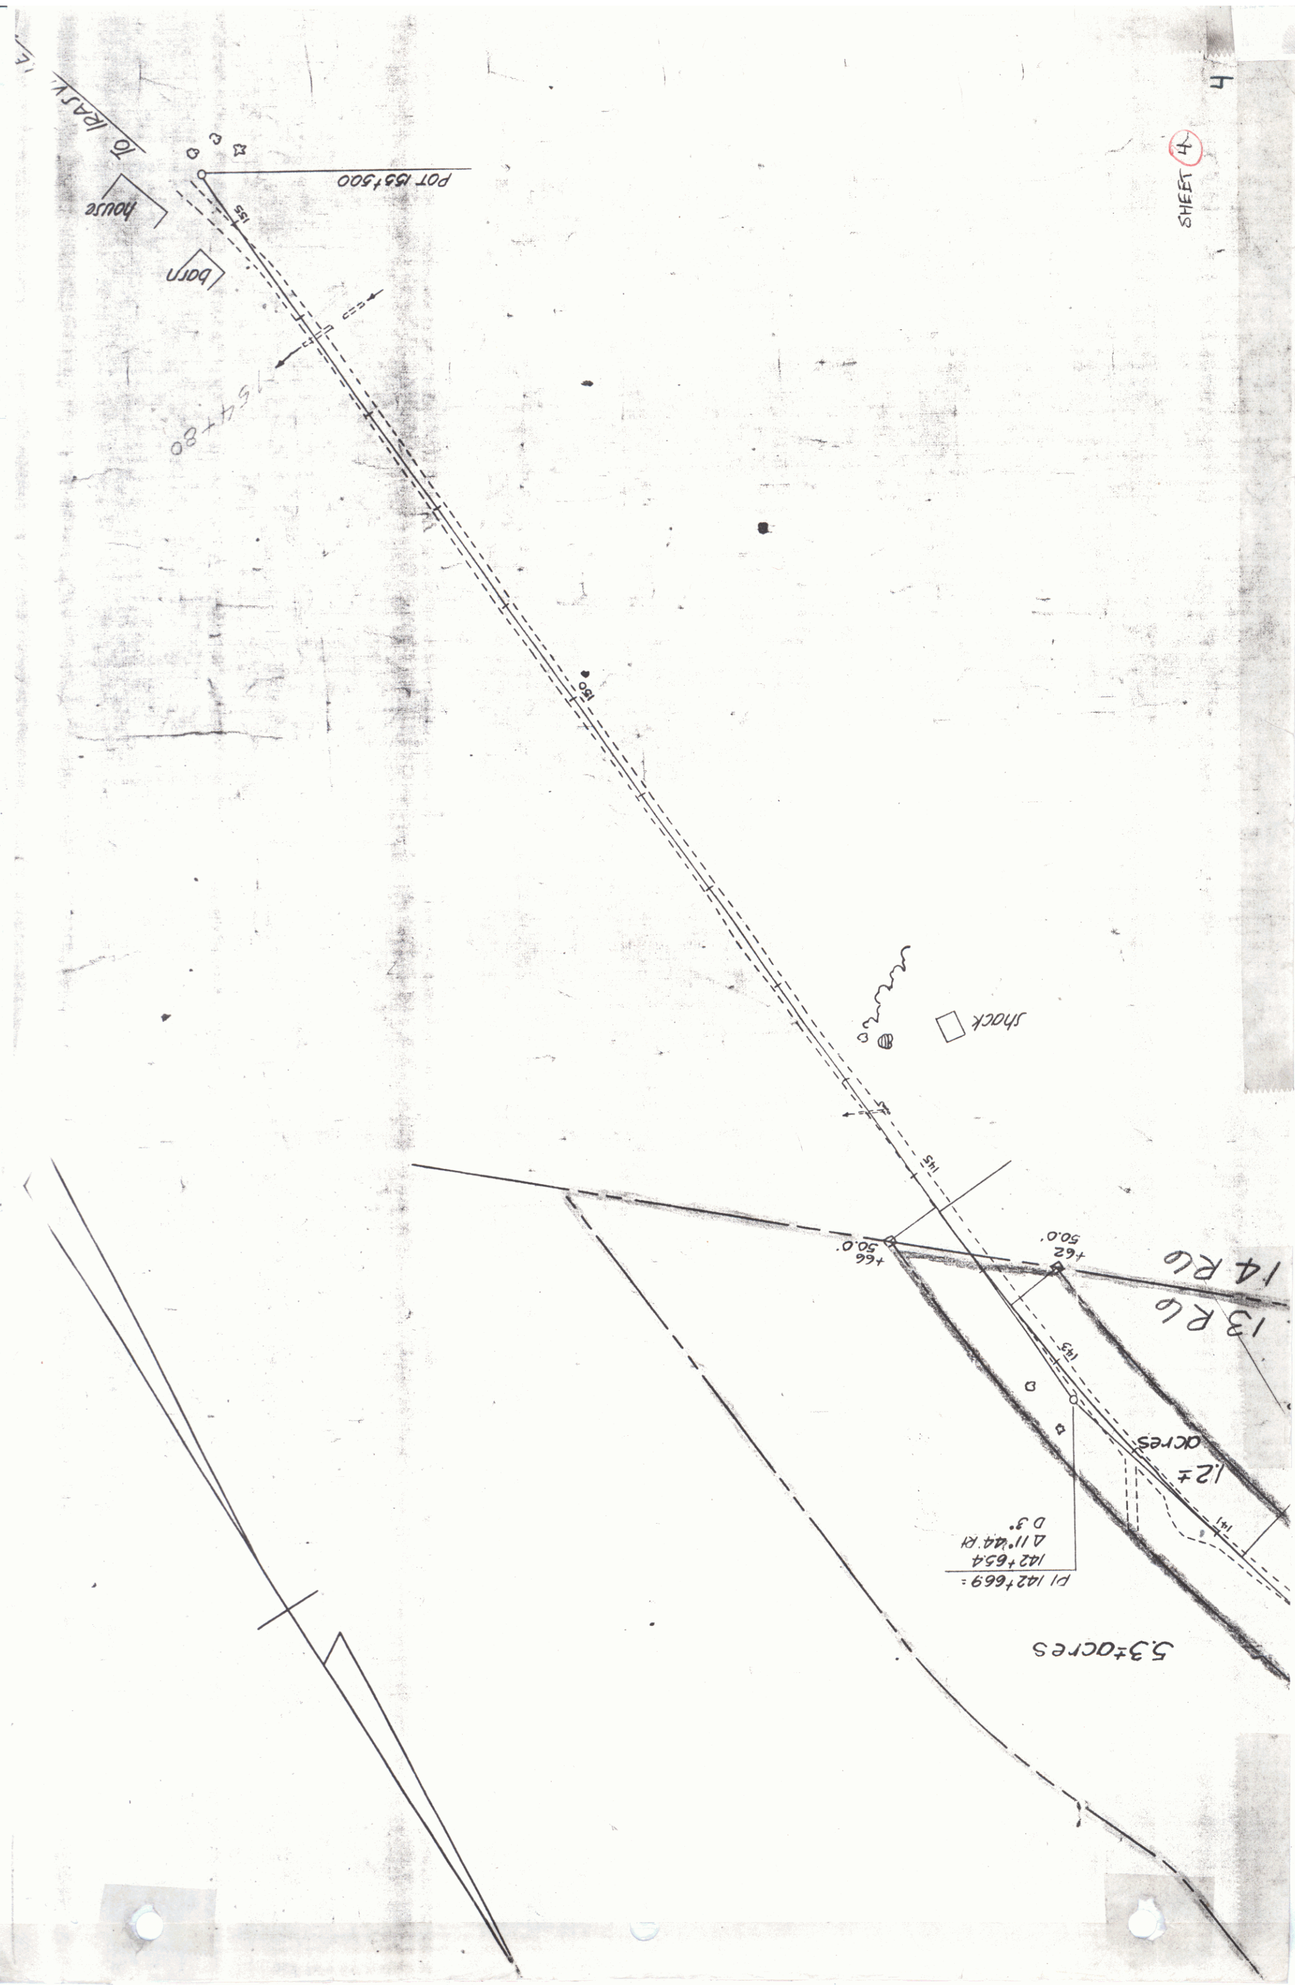
5.3±acres
PI 142+669 =
142+654
Δ 11°44'RT
D 3°
1.2±
acres
13 Rlo
14 Rlo
+66
50.0'
+62
50.0'
145
145
145
shack
shack
145
house
barn
154+80
To CASY

SHEET 4