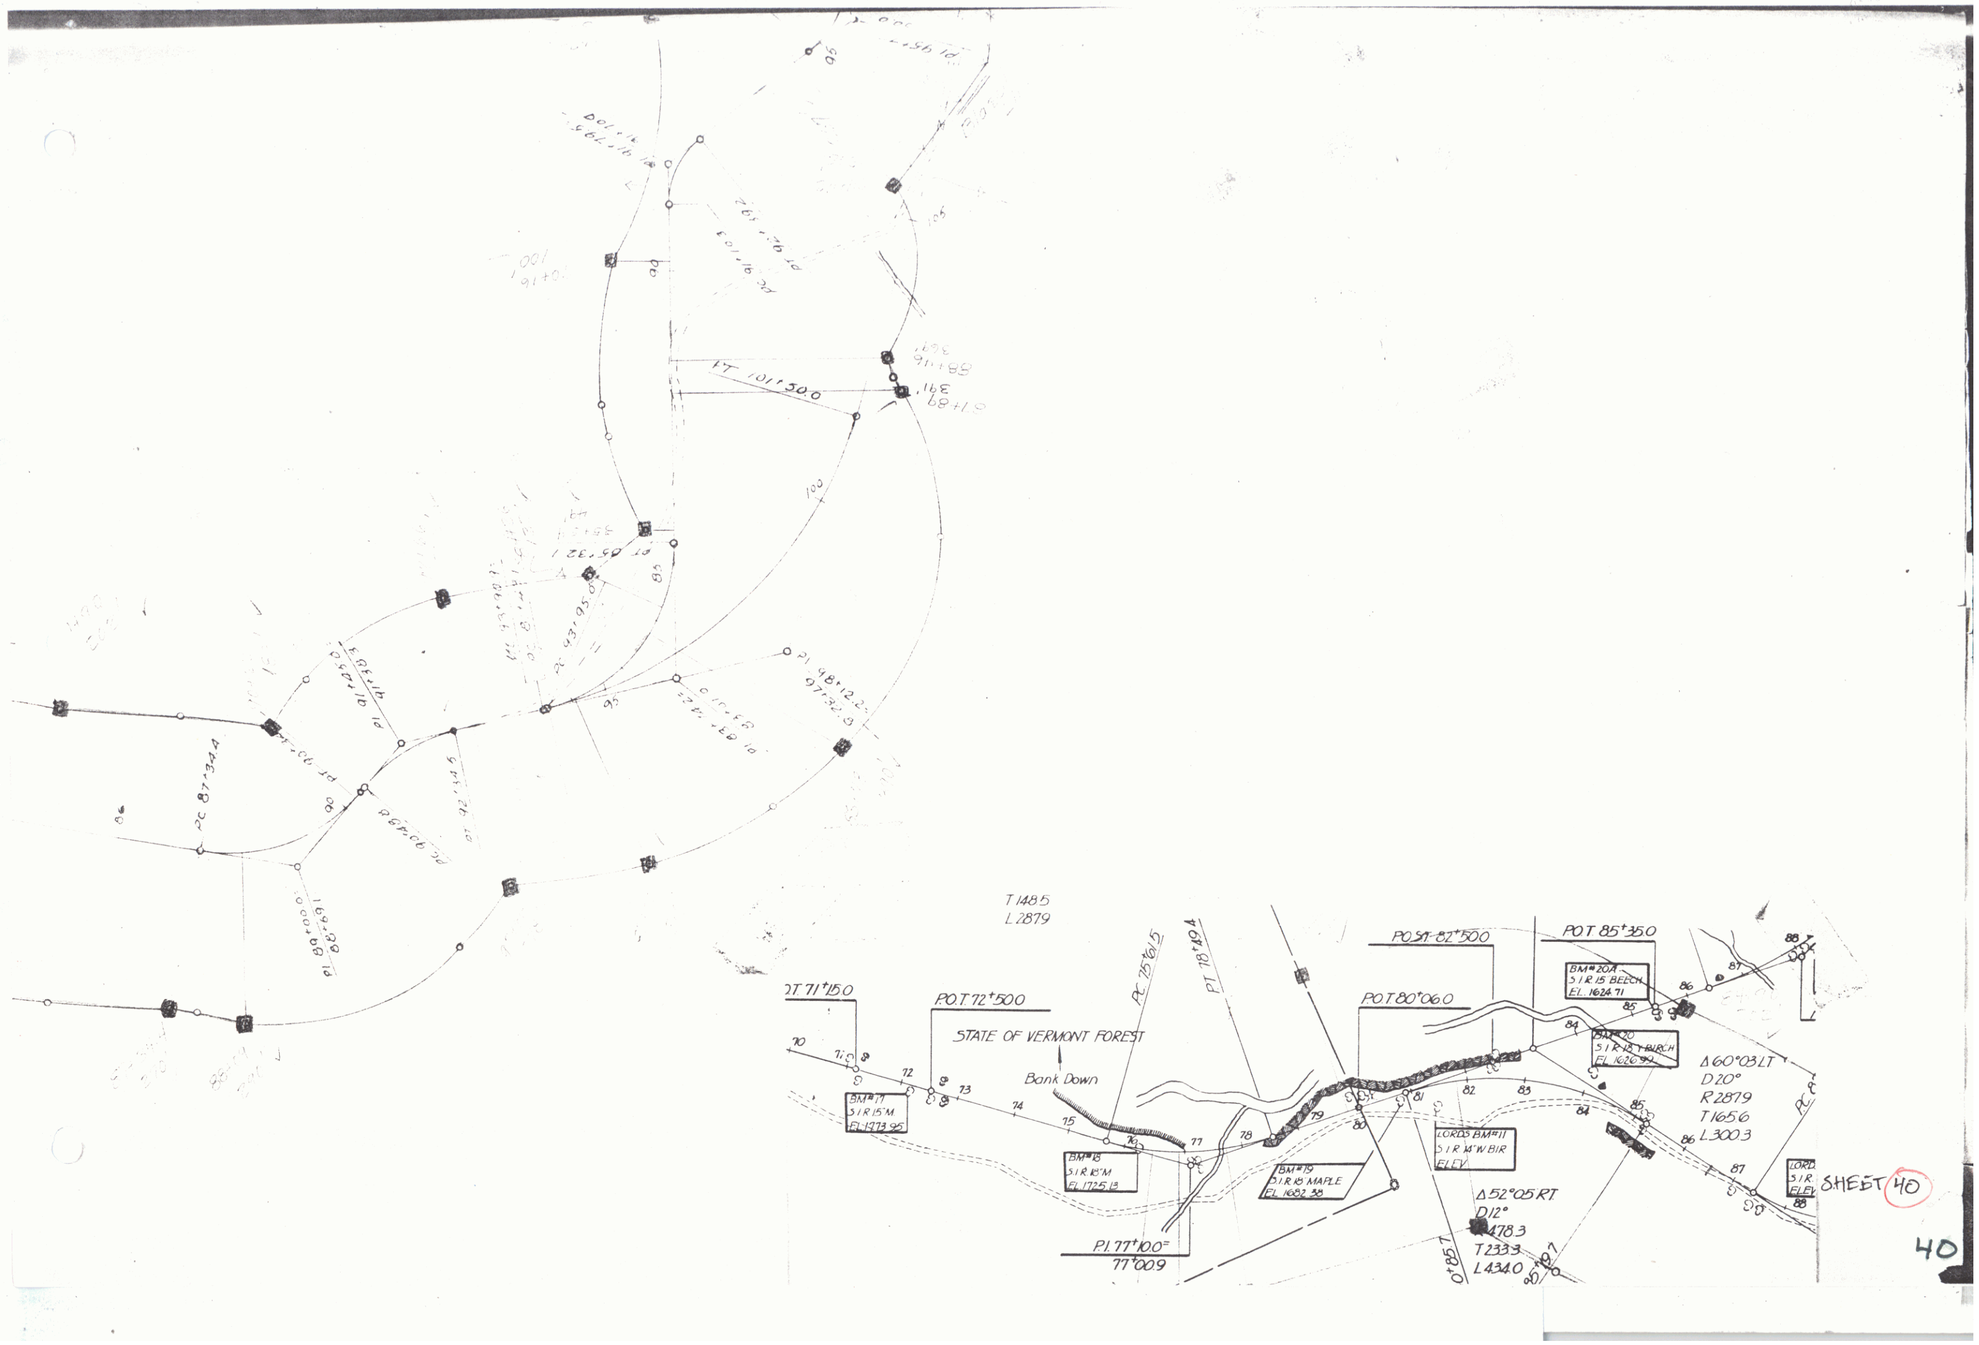
T 148.5
L 287.9
P.O.T. 71+15.0
P.O.T. 72+50.0
STATE OF VERMONT FOREST
Bank Down
BM#17
5 I R 15" M
EL. 1973.95
BM#18
5 I R 15" M
EL. 1725.13
P.I. 77+00=
77°00.9
BM#19
5 I R 15 MAPLE
EL. 1682.38
P.O.T. 80°06.0
P.O.T. 82+50.0
LORDS BM#11
5 I R 14" W. BIR
ELEV.
Δ 52°05' RT
D 12°
R 478.3
T 233.3
L 434.0
P.O.T. 85+35.0
BM#20A
5 I R 15 BEECH
EL. 1624.71
BM#20
5 I R 15 T. BIRCH
EL. 1620.94
Δ 60°03' LT
D 20°
R 287.9
T 165.6
L 300.3
SHEET 40