Note: Dubois Project
1953
Project Markers
on Record Plans –
JO Scribner

Record
Kim
Testing

ROW staked
Aug 57
S.R. Jenkins

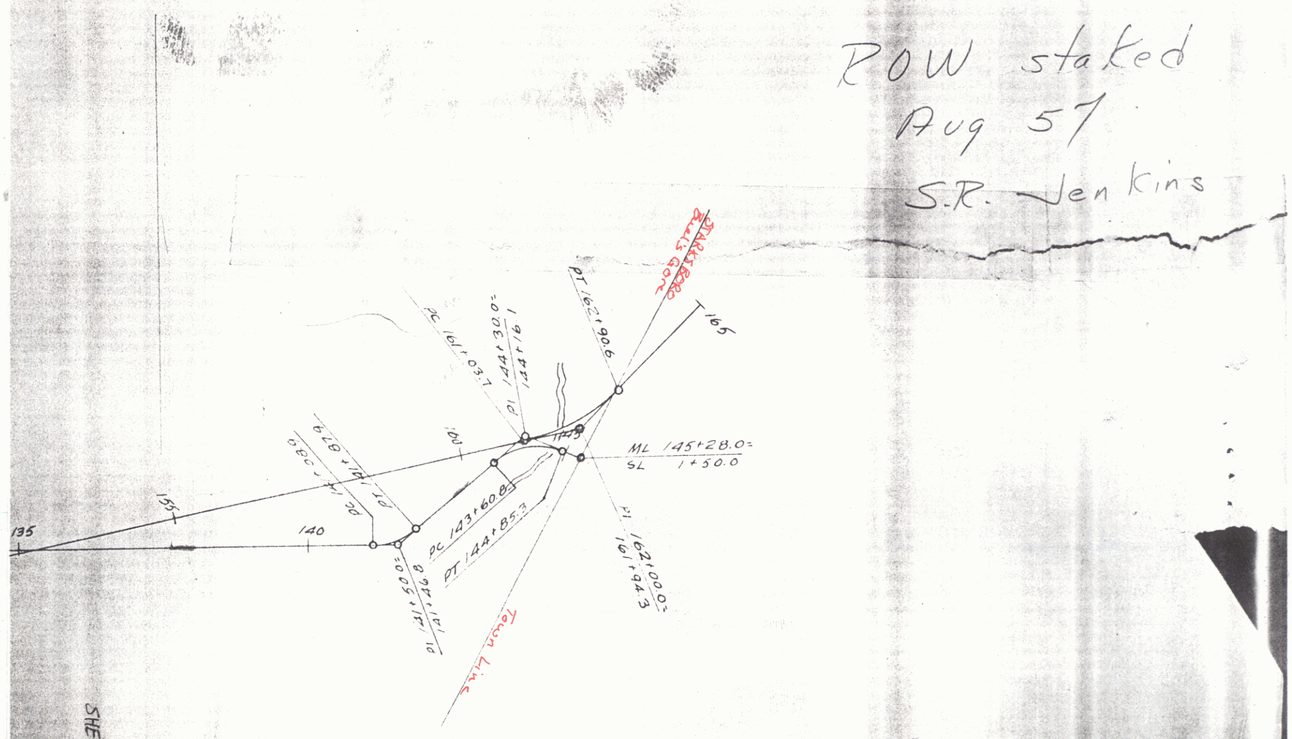

BUELL'S GORE
Starksboro
Proj St No. 2

SHEET 56

96