FED. AID PROJ. NO.	STATE	FISCAL YEAR	SHEET NO.	TOTAL SHEETS
F	VT	70A 1938	5	36

CONTRACT 2

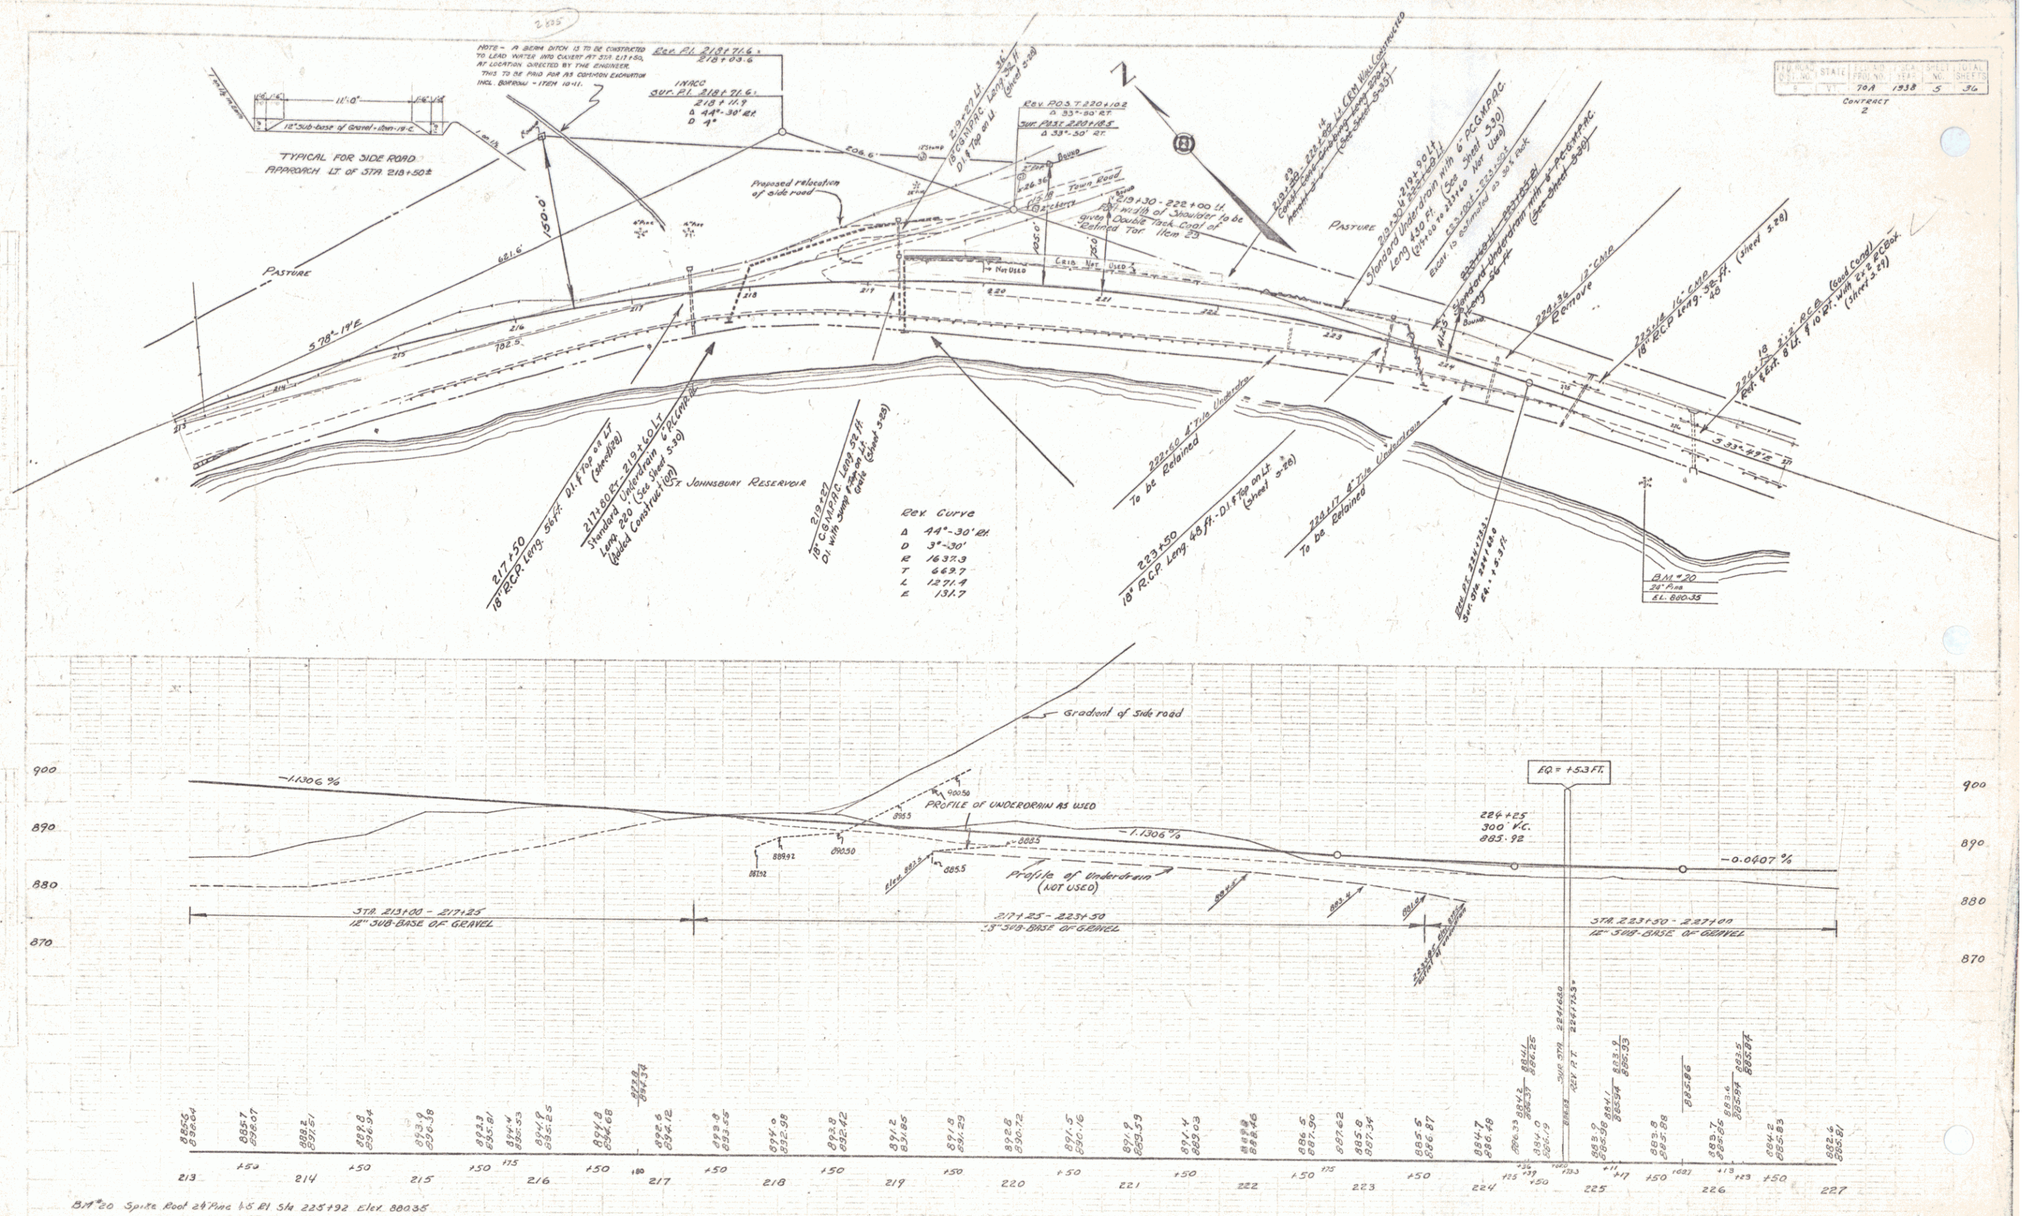

SERIES F.A.P. NO. 70A CONTRACT 2
SHEET 5 OF 36 SHEETS

3