FED. ROAD DIST. NO.	STATE	FED. AID PROJ. NO.	FISCAL YEAR	SHEET NO.	TOTAL SHEETS
9	VT.	70-A	1938	6	36

CONTRACT 2

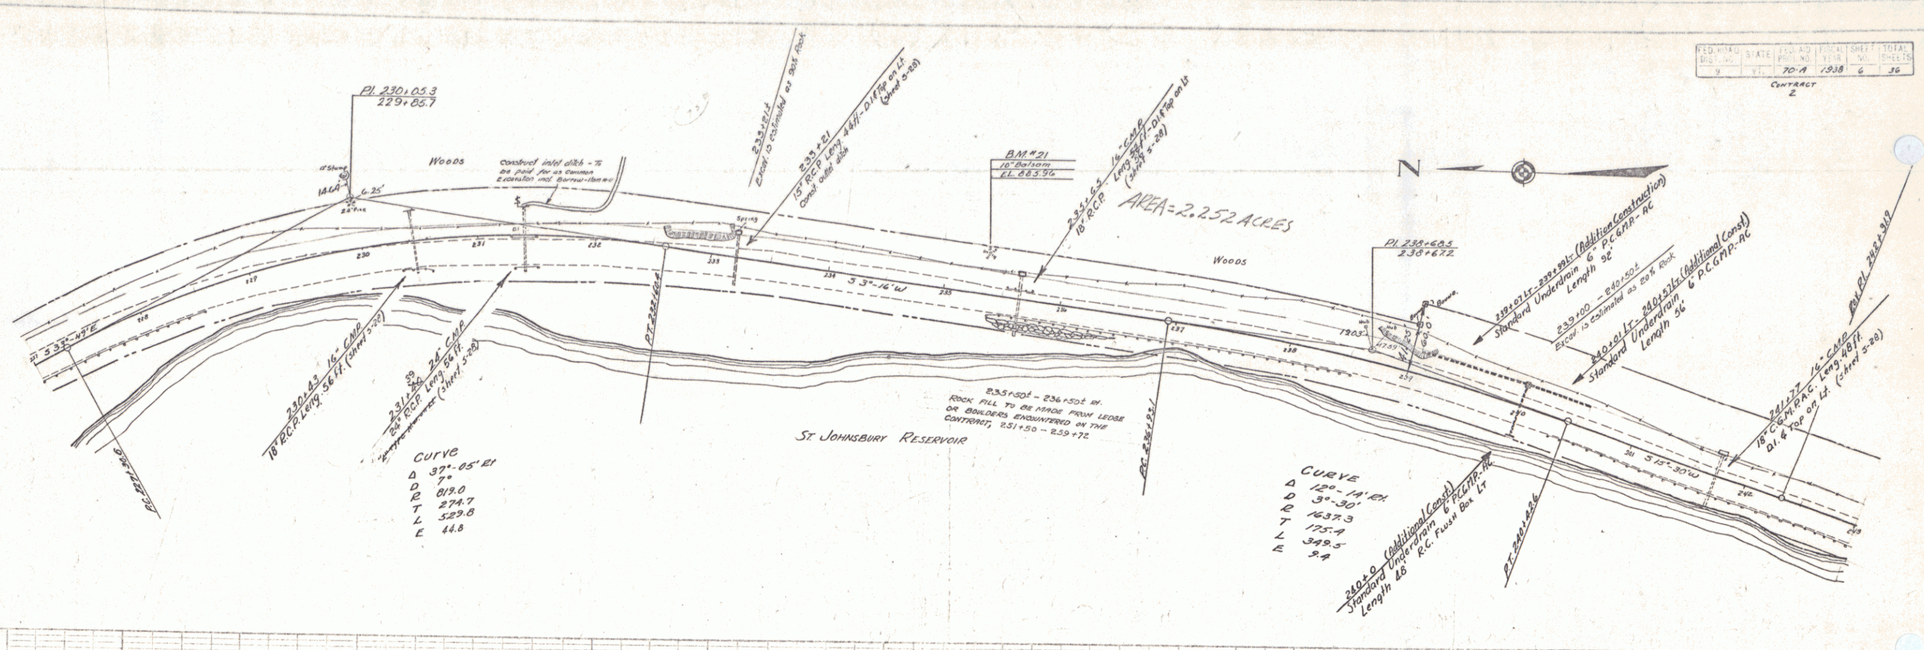

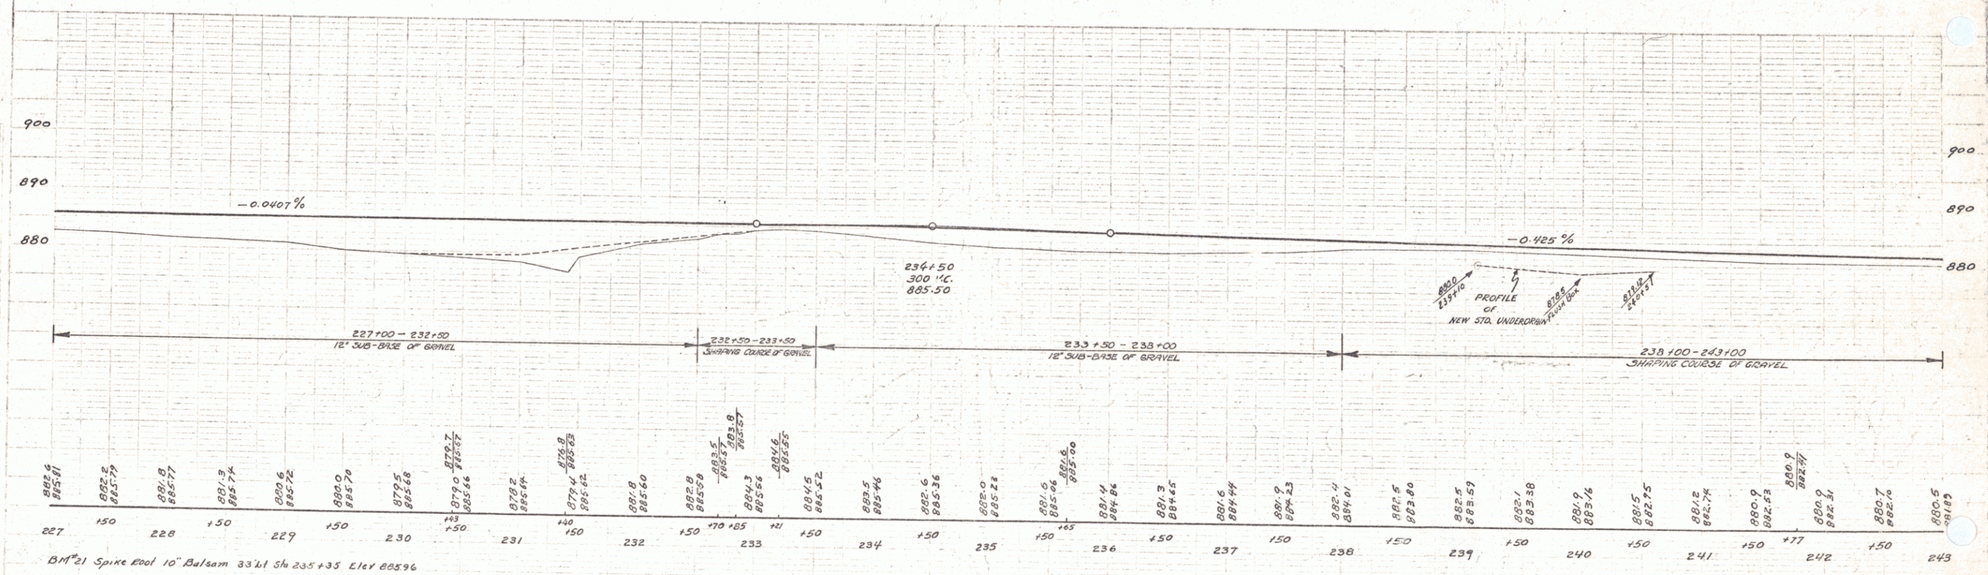

SERIES F.A.P. NO. 70 A CONTRACT 2
SHEET 6 OF 36 SHEETS

4