FED. ROAD DIST. NO.	STATE	FED. AID PROJ. NO.	FISCAL YEAR	TOTAL SHEETS	SHEET NO.
5	VT.	70-B	1938	6	24

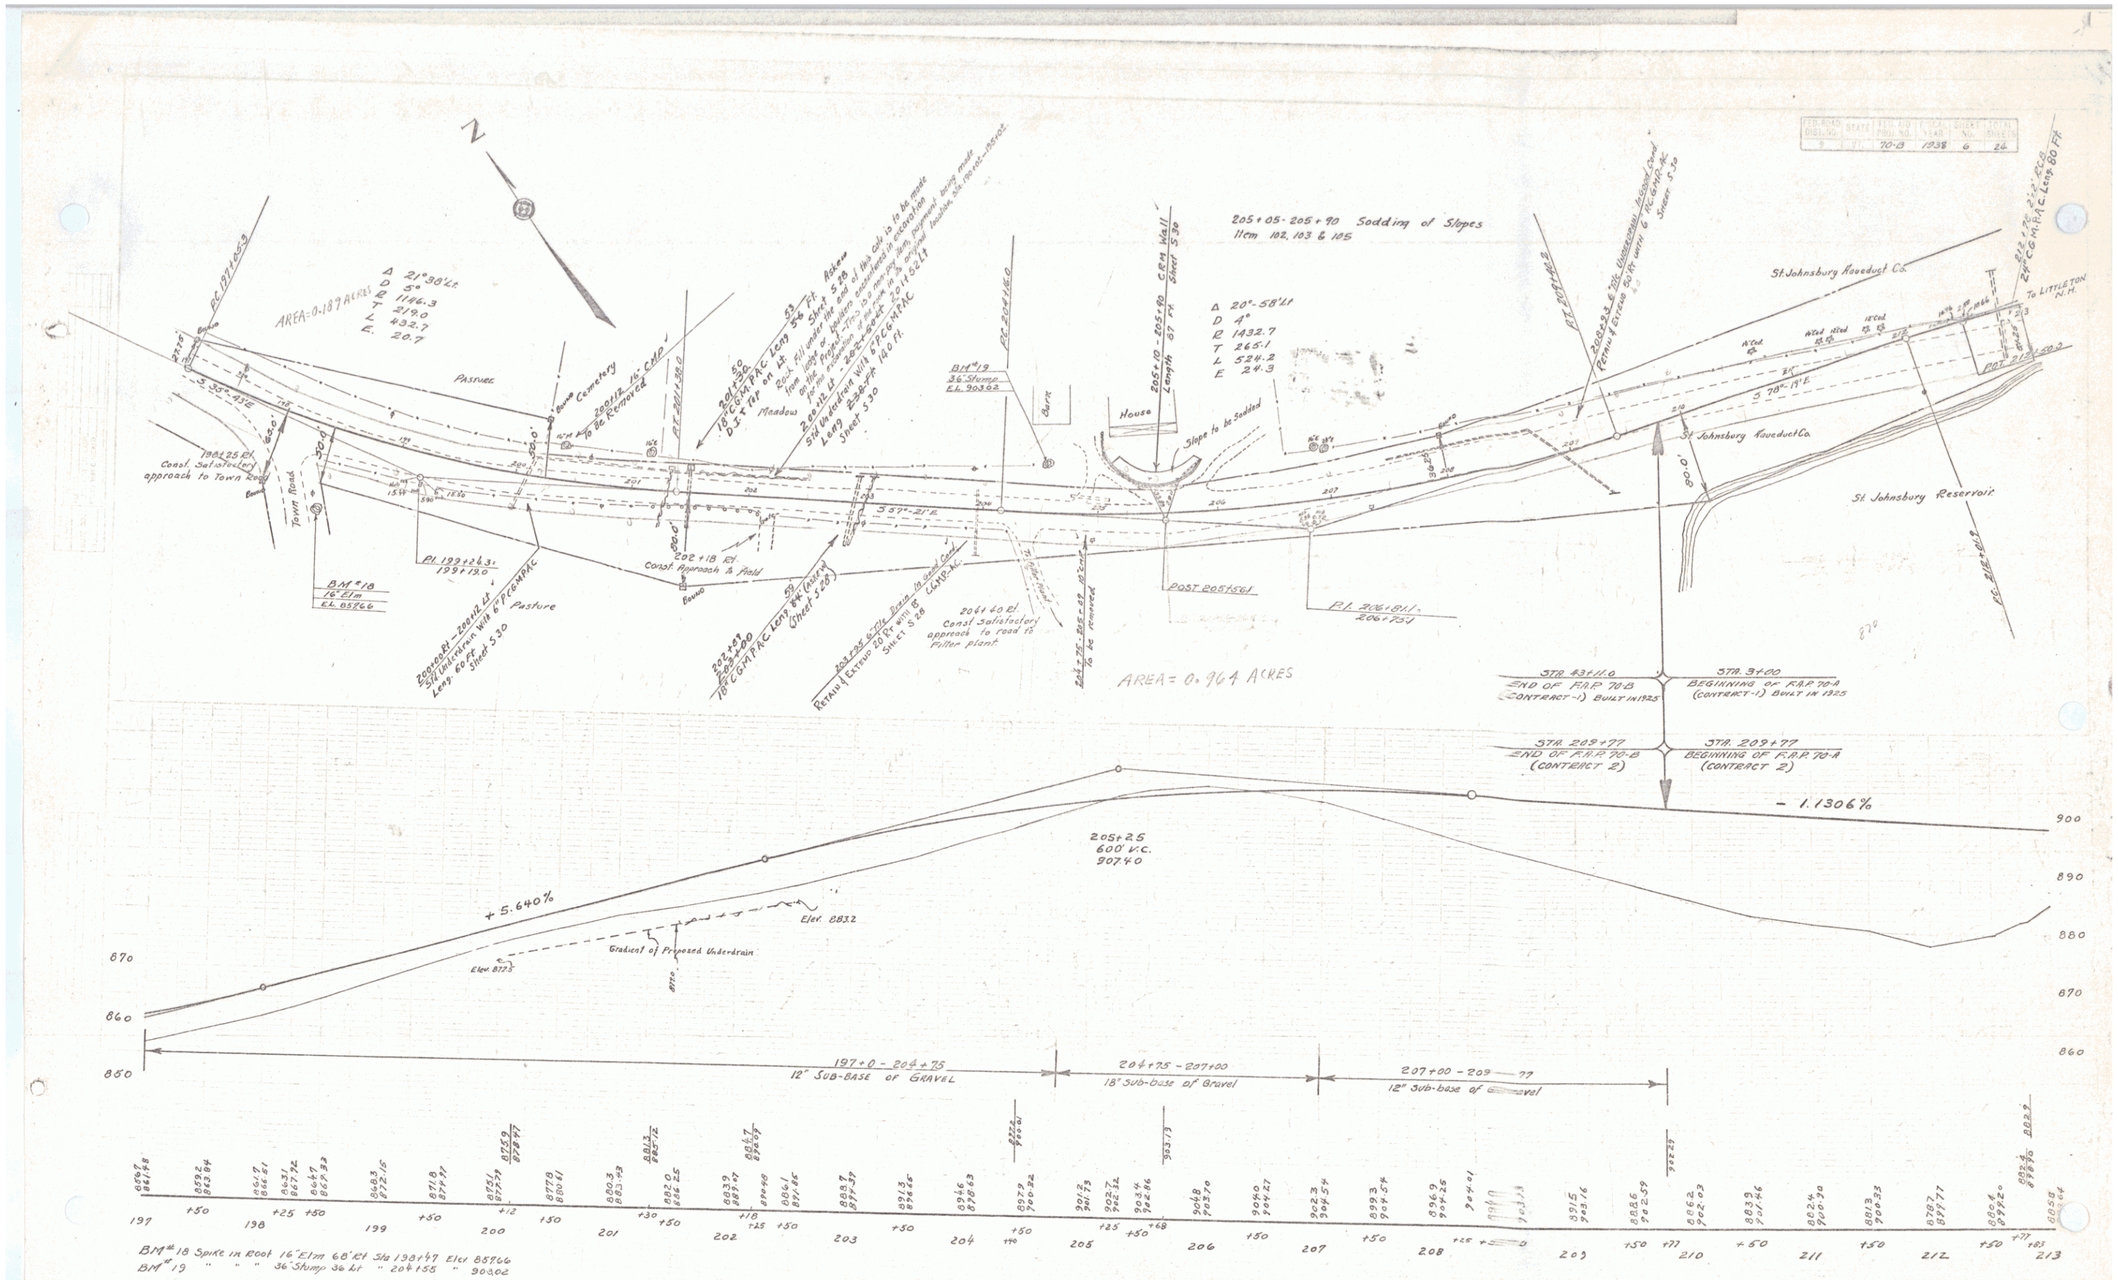

4