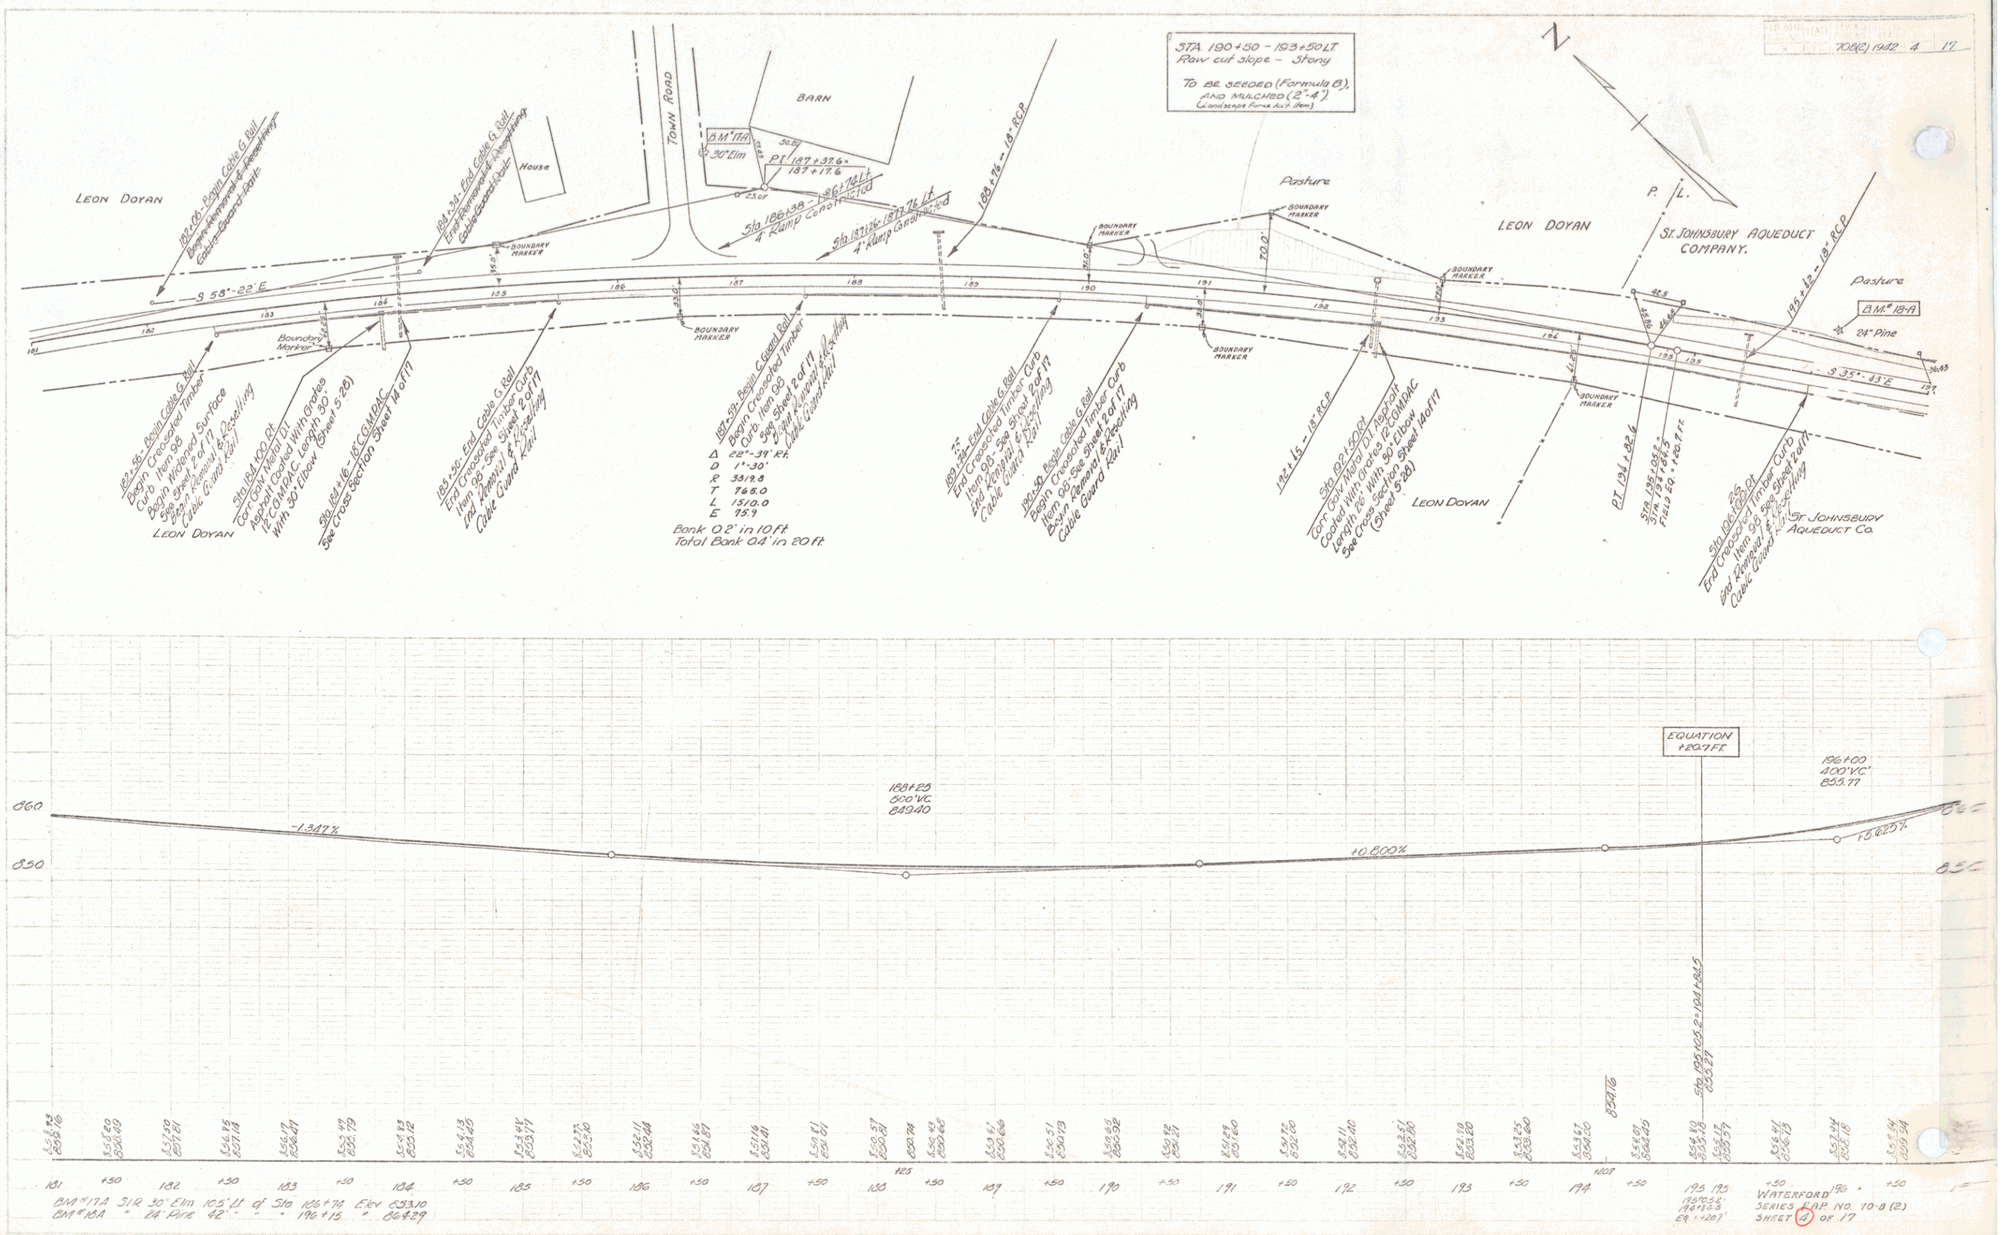
STA. 190+50 - 193+50 LT
Raw cut slope - Stony
To be seeded (Formula B), and mulched (2"-4")
(Landscape Furnish Act. Item)
N
Town Road
BARN
House
B.M.# 17A
30" Elm
PT 187+37.6 = 187+17.6
Sta. 186+38 - 186+74 Lt. 4' Ramp Constructed
Sta. 187+76 - 187+76 Lt. 4' Ramp Constructed
188+74 - 18" RCP
Pasture
LEON DOYAN
P.I.
St. Johnsbury Aqueduct Company.
195+12 - 18" RCP
B.M.# 18-A
24" Pine
S 58°-22' E
S 35°-43' E
Boundary Marker
Δ 22°-39' Rt.
D 1°-30'
R 3819.8
T 765.0
L 1510.0
E 95.9
Bank 0.2' in 10 ft.
Total Bank 0.4' in 20 ft.
PT 194+82.6
St. Johnsbury Aqueduct Co.
EQUATION +20.7 FT.
188+25 800' VC 849.40
196+00 400' VC 855.77
-1.347%
+0.800%
+0.625%
860
850
855
Sta. 195+00 = 104 FT. 2" = 855.77
855.76
BM #17A 51R 30" Elm 105' Lt of Sta 186+74 Elev 853.10
BM #18A " 24" Pine 42' " " 196+15 " 864.29
WATERFORD SERIES
MAP NO. 10-8 (2)
SHEET 4 OF 17