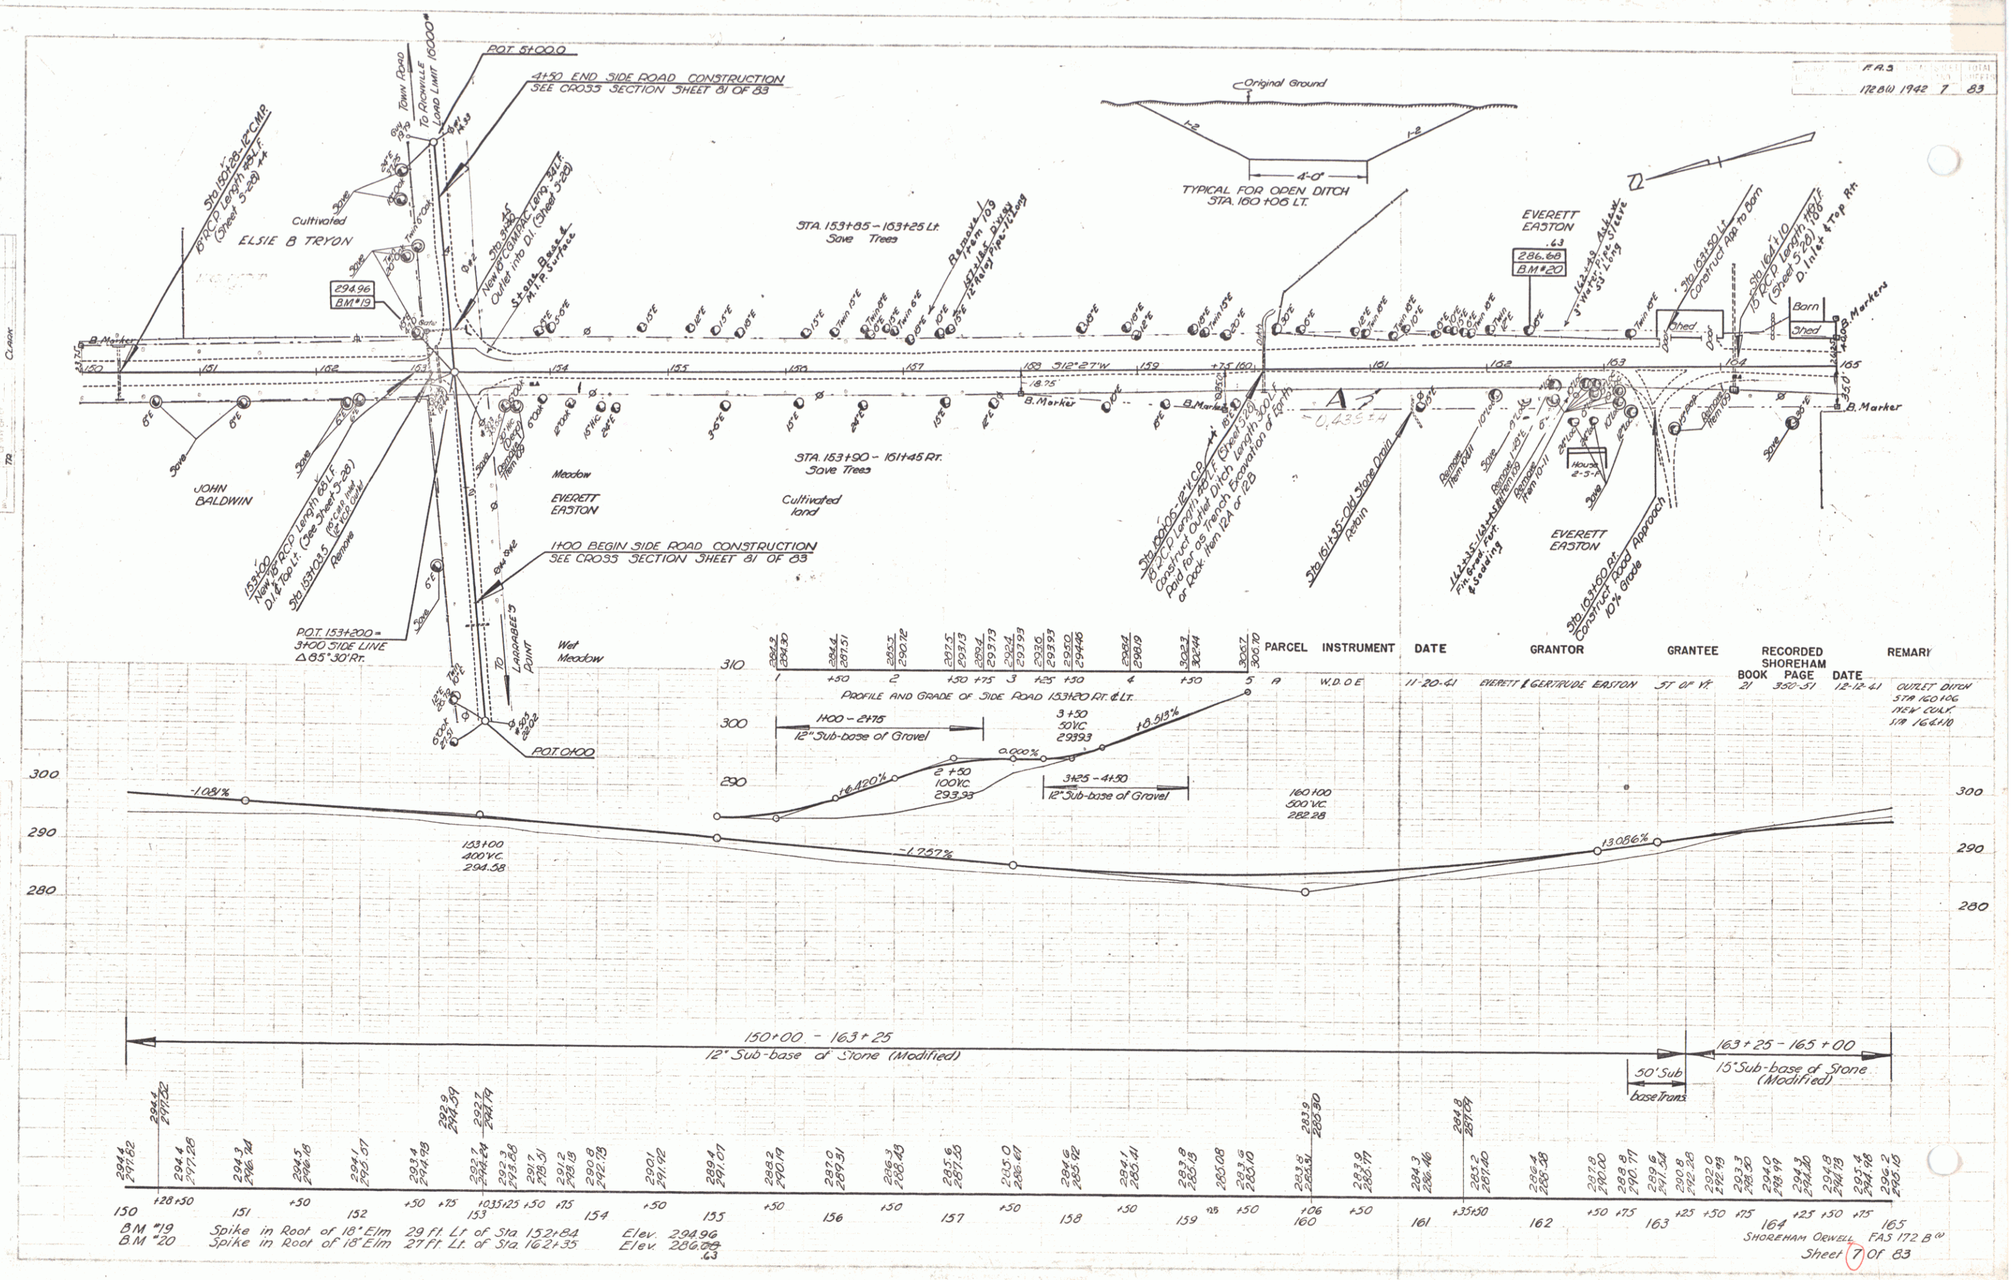

PARCEL	INSTRUMENT	DATE	GRANTOR	GRANTEE	RECORDED SHOREHAM BOOK	PAGE	DATE	REMARKS
19	W.D. O.E.	11-20-41	EVERETT & GERTRUDE EASTON	ST. OF VT.	21	350-51	12-12-41	OUTLET DITCH STA 160+06 NEW COLV. 1/19 164+10